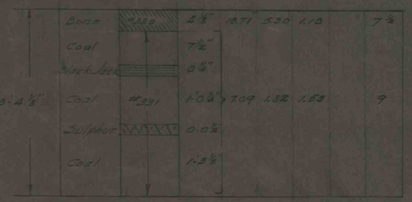

Ave. Analysis
Ash - 7.77
Sul - 2.17
Moisture 1.82
B.T.U.
Coke Button 2.8

Sampled 12-18-51

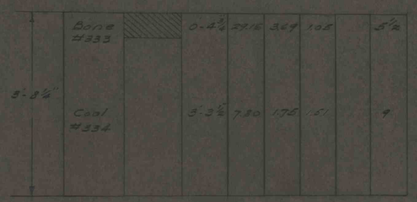

Ave. Analysis
Ash 10.11
Sul 1.96
Moisture 1.26
B.T.U.
Coke Button 8.6

Sampled 12-18-51

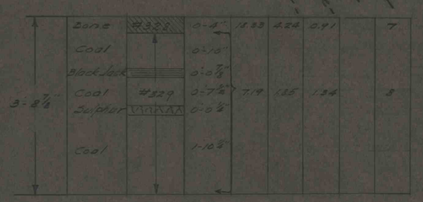

Ave. Analysis
Ash - 8.16
Sul - 2.06
Moisture 1.30
B.T.U.
Coke Button 7.4

Sampled 12-18-51

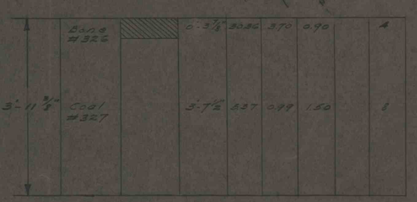

Ave. Analysis
Ash 7.80
Sul. 1.21
Moisture 1.46
B.T.U.
Coke Button 7.7

Sampled 12-18-51

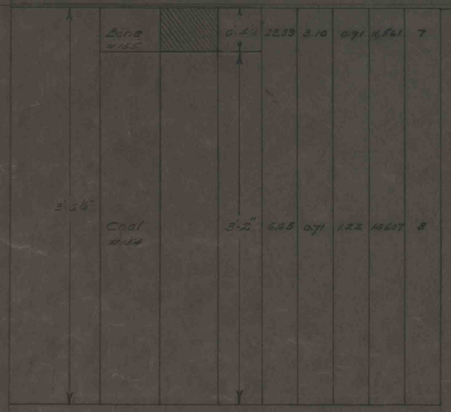

Ave. Analysis
Ash 8.31 -
Sulphur 0.98 -
Moisture 1.19 -
B.T.U. 14304 +
Coke Button 7.9 -

2nd Panel Hdg.
Sampled 3-26-51

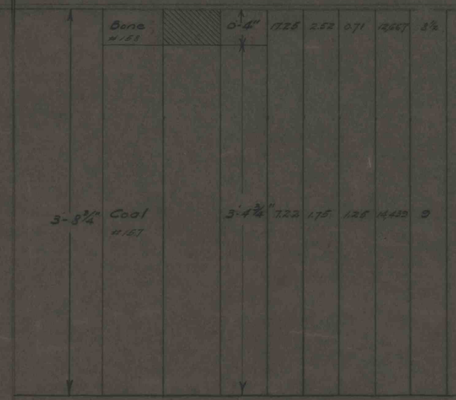

Ave. Analysis
Ash 8.08
Sulphur 1.81
Moisture 1.20
B.T.U. 14,043
Coke Button - 7.9

3rd Panel Hdg.
Sampled 3-26-51

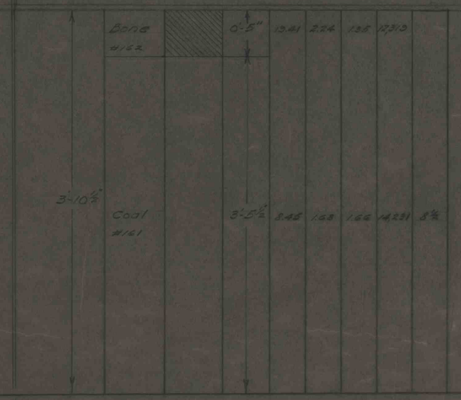

Ave. Analysis
Ash 8.68
Sulphur 1.75
Moisture 1.62
B.T.U. 14,060
Coke Button

4th Panel Hdg
Sampled 3-26-51

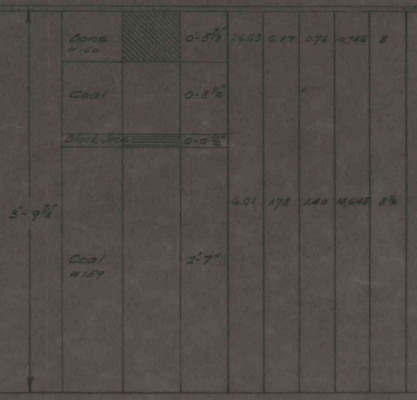

Ave. Analysis
Ash - 7.63
Sul - 2.23
Moisture 1.32
B.T.U. 14,46
Coke Button 8.5

No. 1 South Hdg.
Sampled 3-26-51

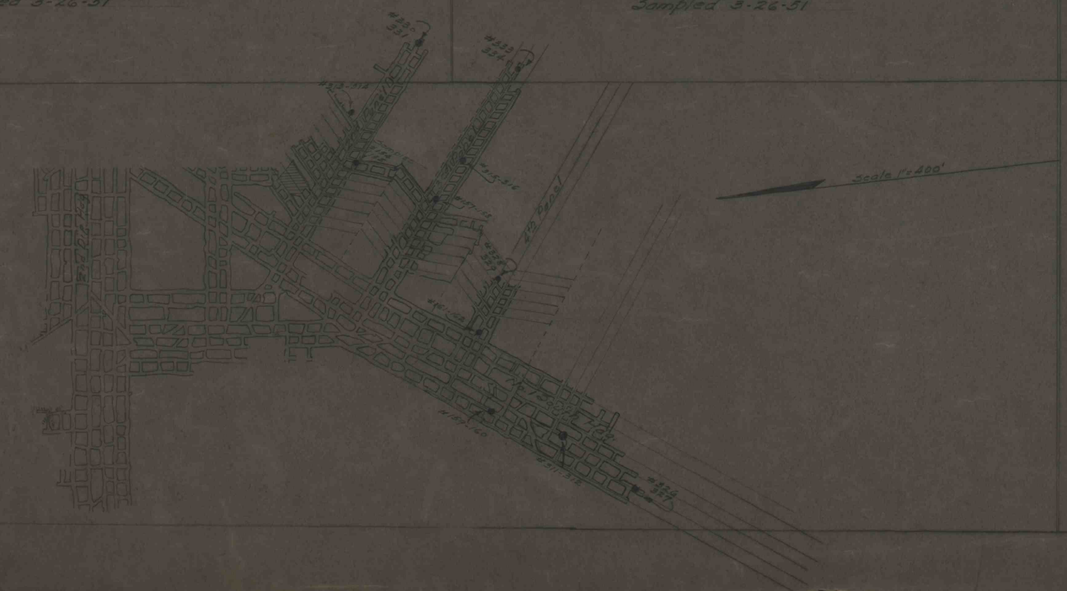

JOHNSTOWN COAL AND COKE CO.
PORTAGE NO. 4 MINE
COAL ANALYSES
NO. 1 MAIN SOUTH AND PANEL HDGS.
MAR. 26. 1951