


1512

5157

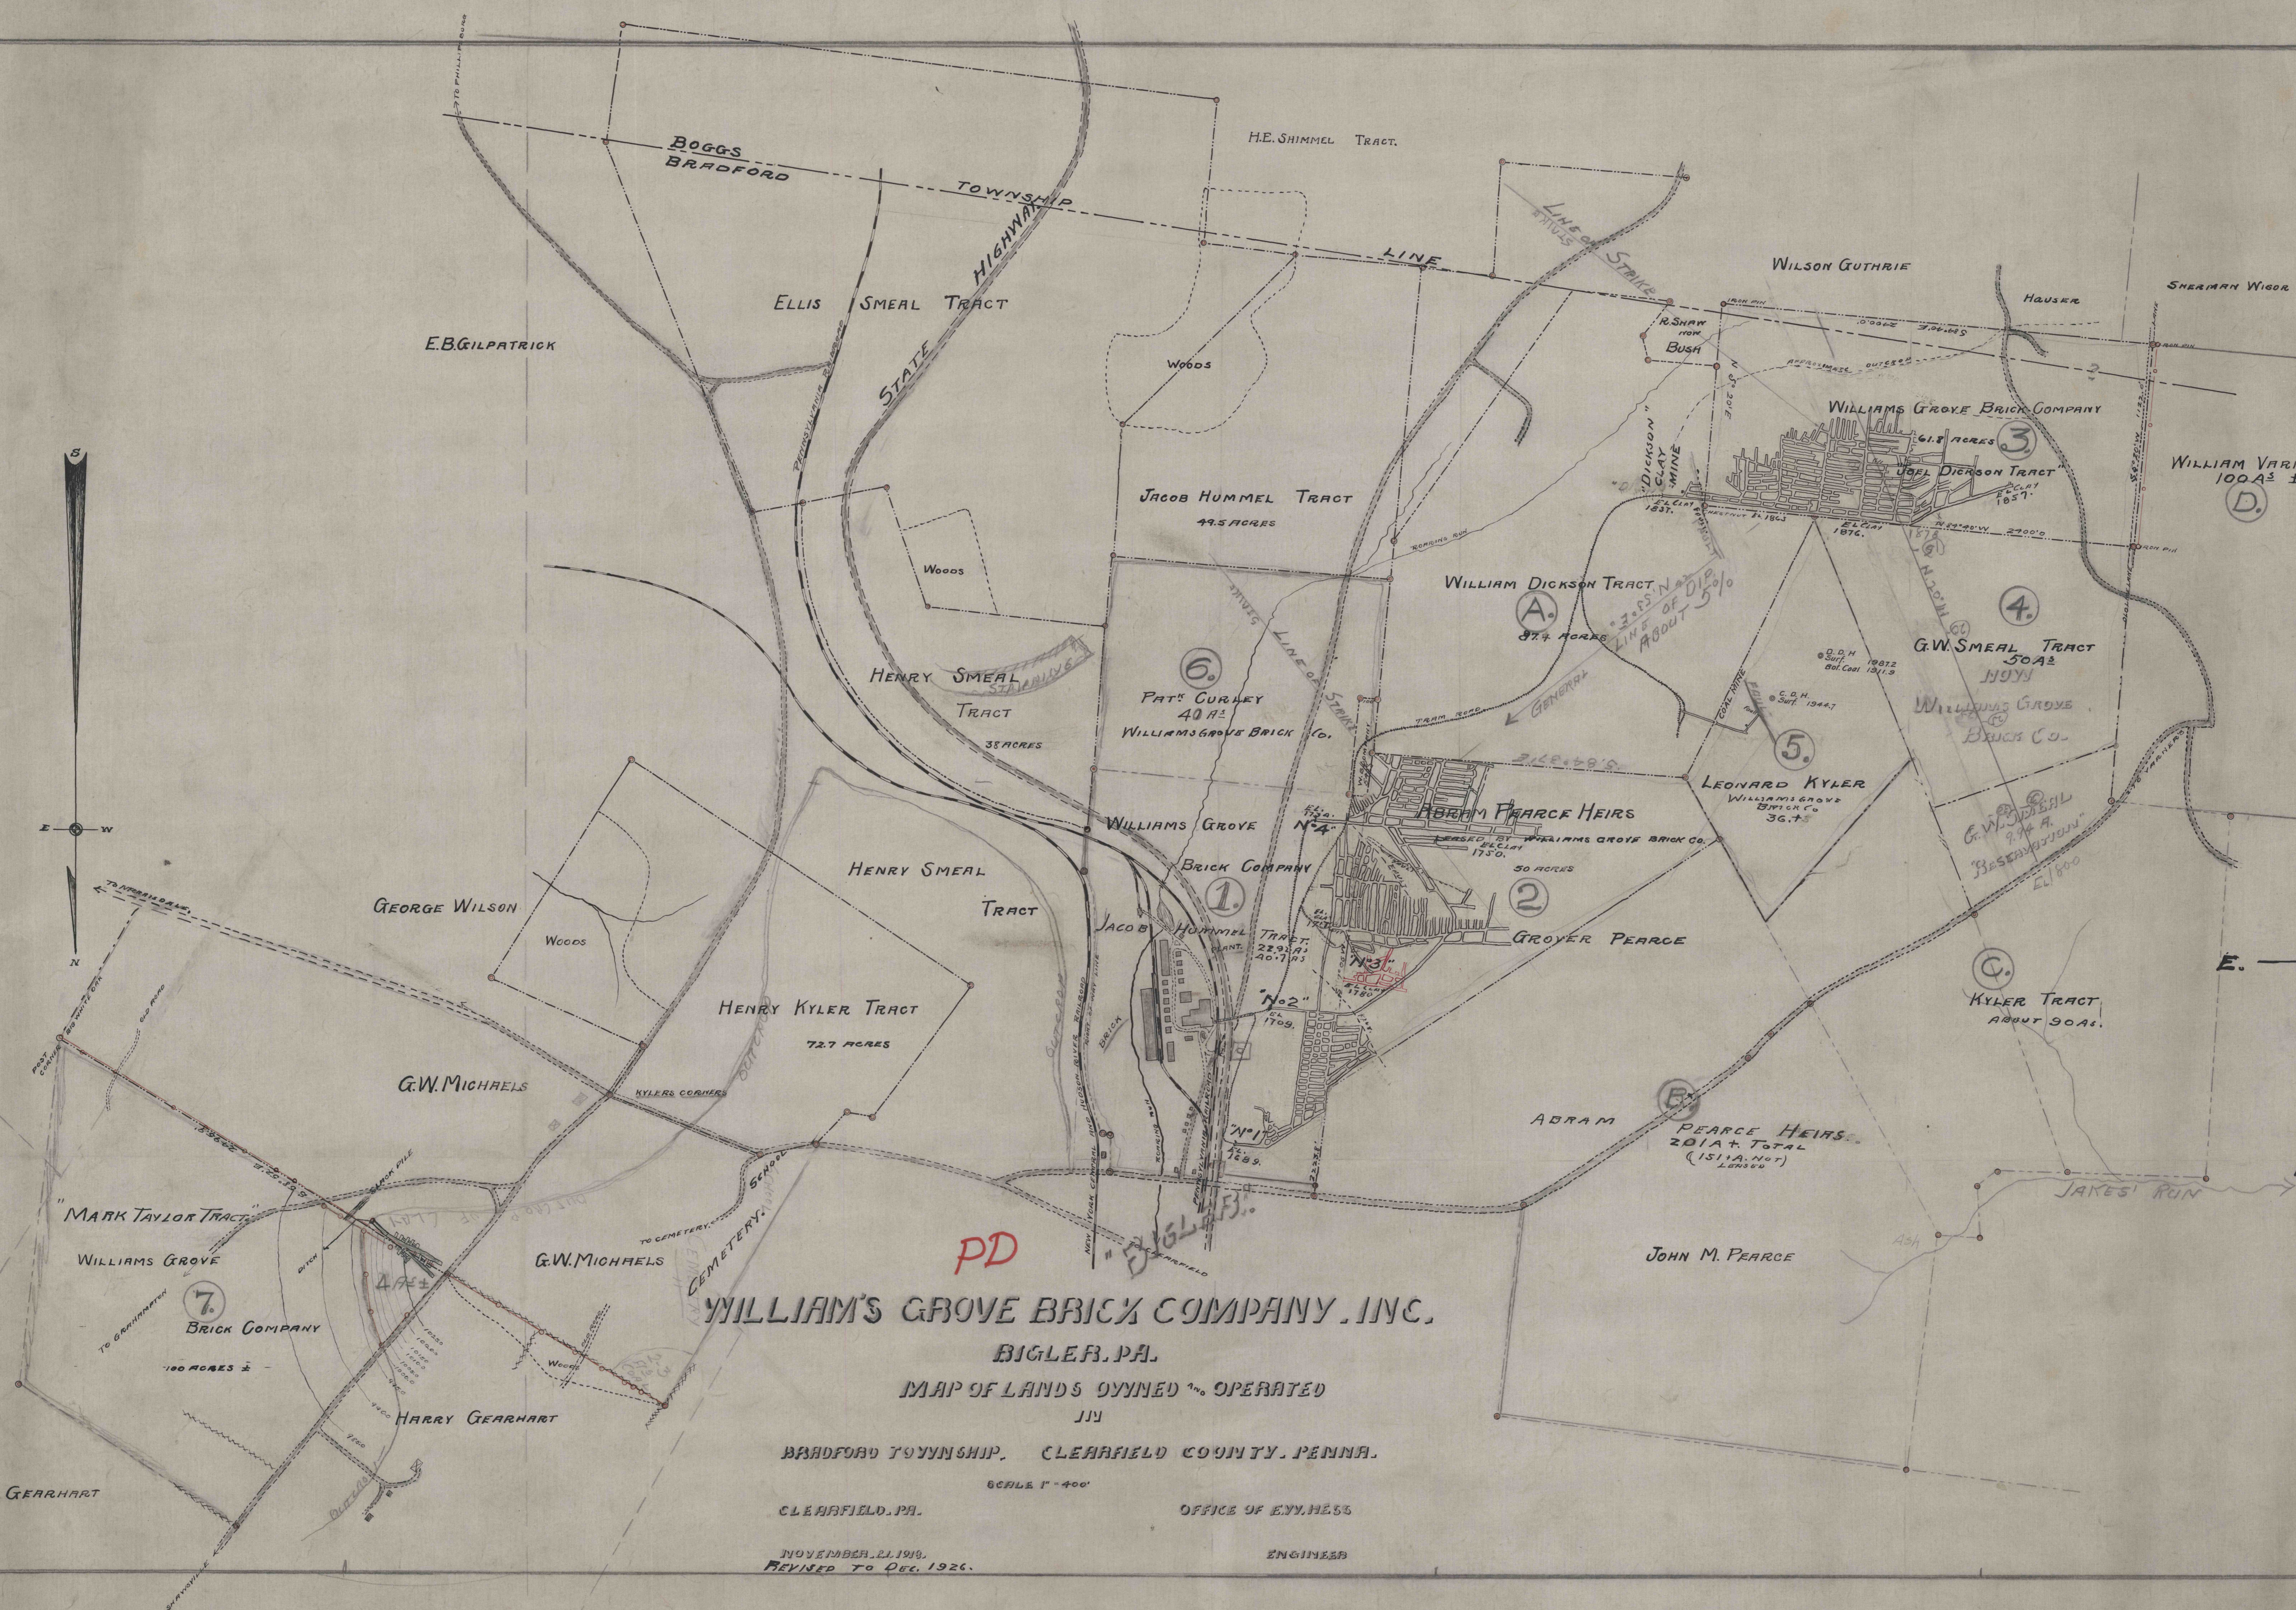

WILLIAM'S GROVE BRICK COMPANY, INC.

BIGLER, PA.

MAP OF LANDS OWNED AND OPERATED

JUN

BRADFORD TOWNSHIP, CLEARFIELD COUNTY, PENNA.

CLEARFIELD, PA.

OFFICE OF EYMHESSE

NOVEMBER 21, 1919,
REVISED TO DEC. 1926.

ENGINEER

PD

1512