

PM

# CAVALIER COAL CO.

Map of  
Strippings on the Lehigh Valley Coal Co. Lease  
Snow Shoe Twp., Centre Co., Penna.

SCALE - 1 in. = 400 ft.

July 21, 1949

Engineering Offices

Clearfield, Pa.

NB 270

P 26

Yost, Bramfield & Hess


1381A

Area Affected - 29.73 Acres  
(from which overburden has been removed)

Spoil

- based on 135 tons per inch -Acres-

LEHIGH VALLEY COAL CO.

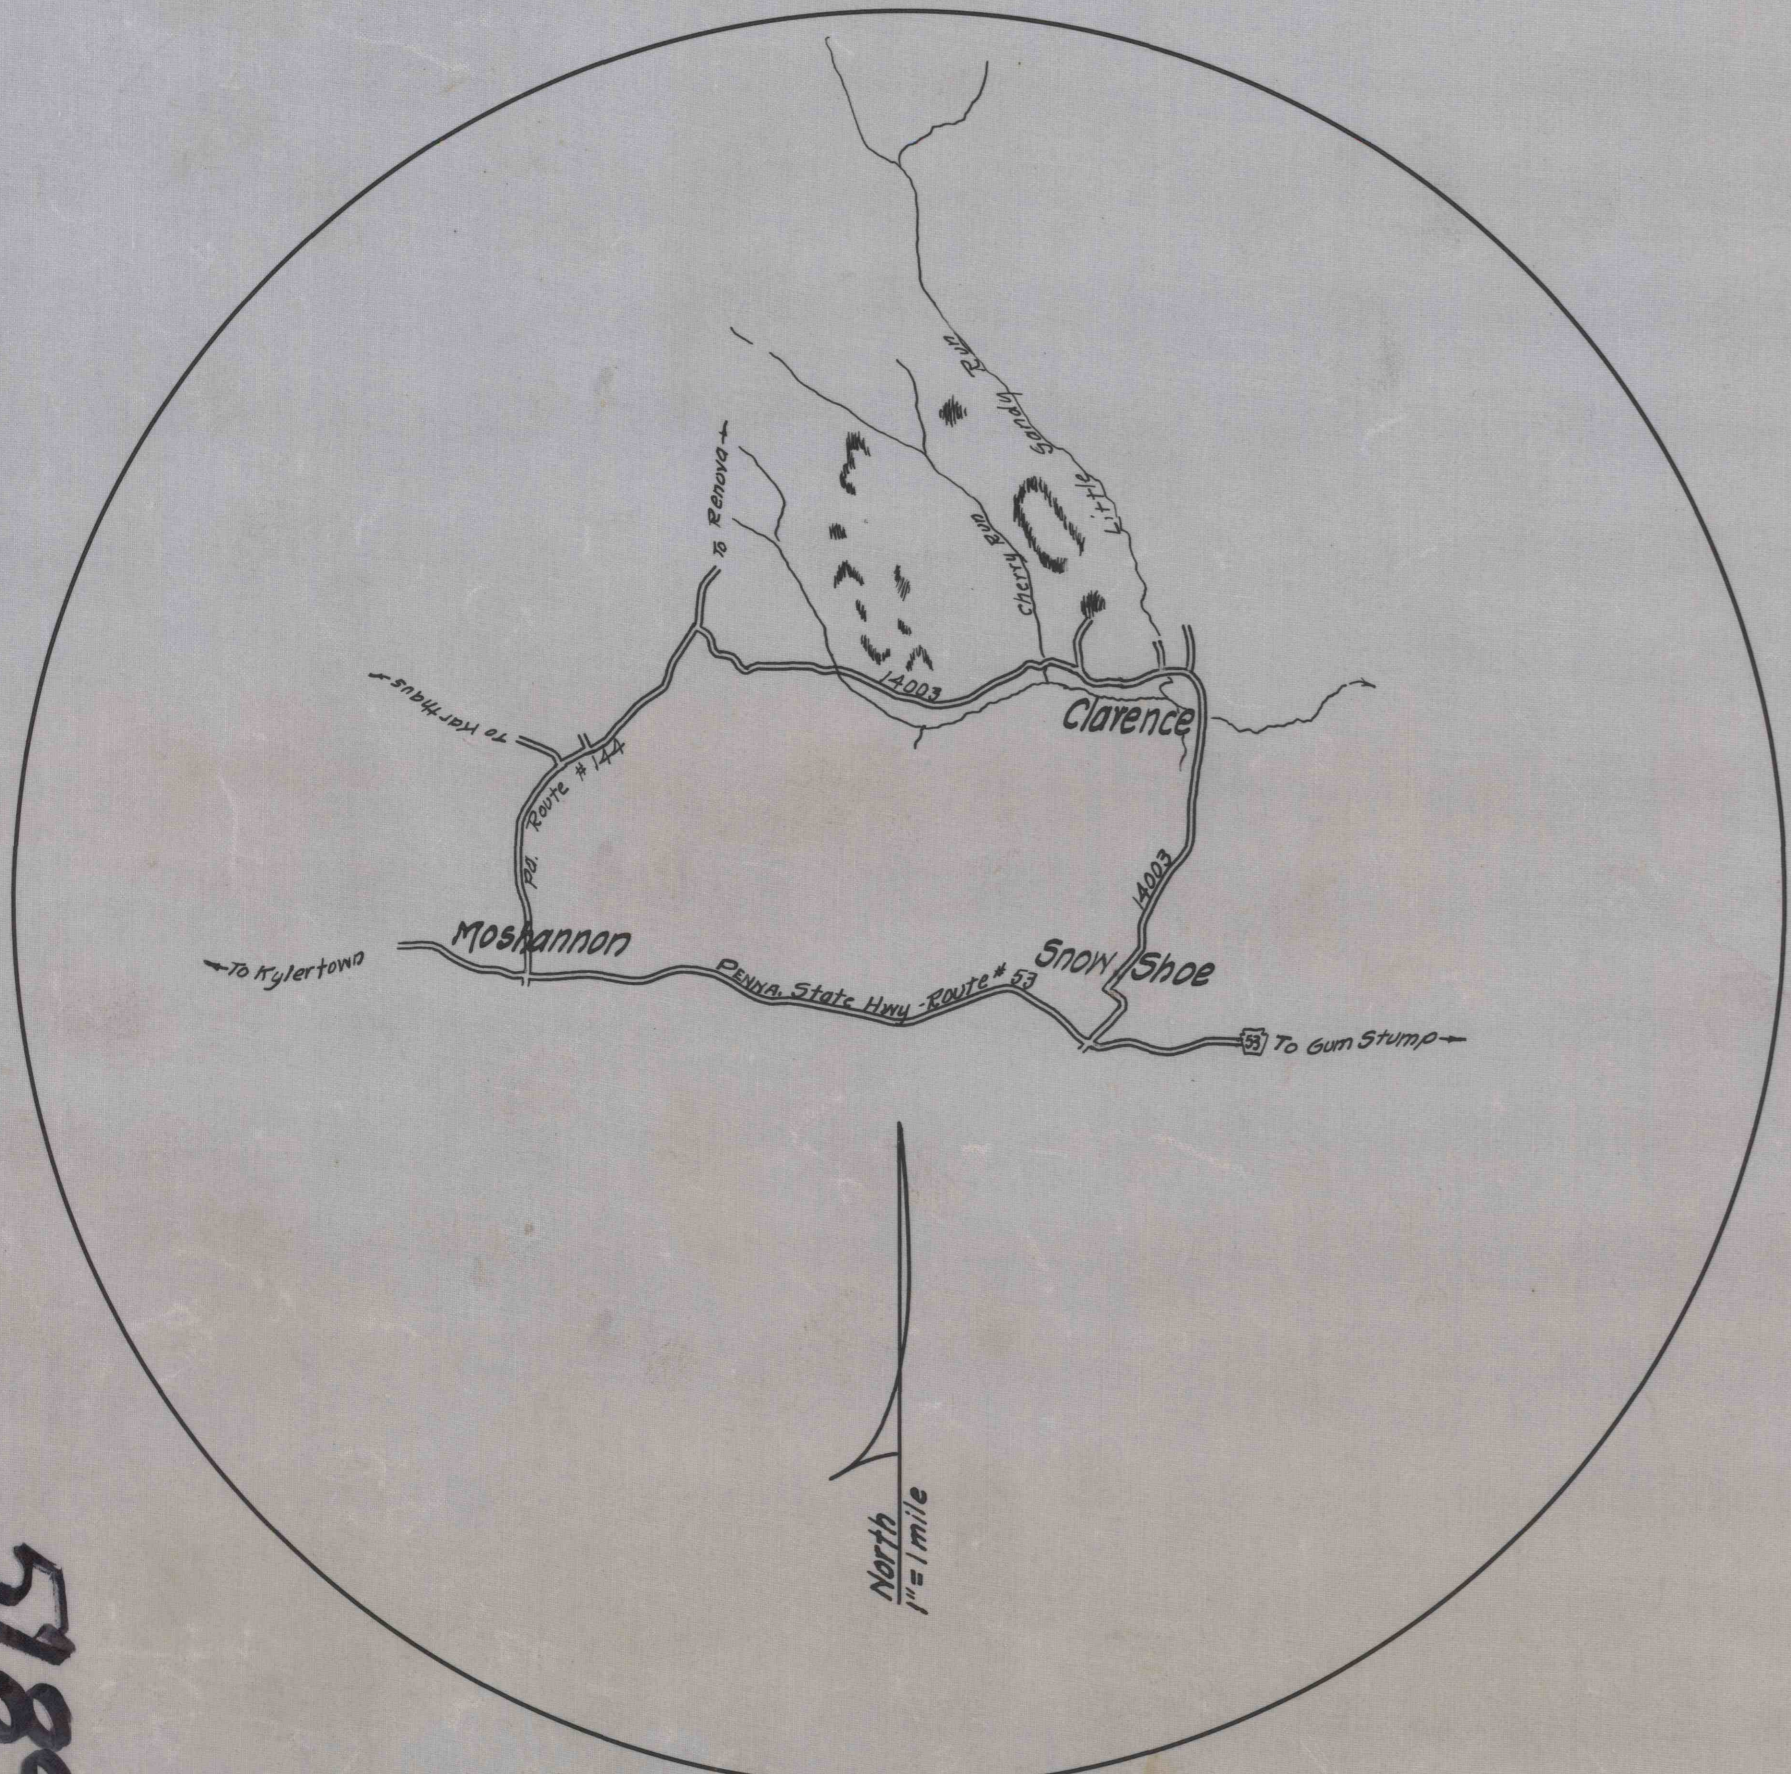

North  
1/2=400'

"CLARENCE"

1381A

5187

1381A

1381A