


REFERENCE DATA

CRESCENT REFRACTORIES CO.
CURWENSVILLE, CLEARFIELD COUNTY, PA.
ENGINEERING DEPARTMENT
LOCATION OF DRILL HOLES.
ON JOSEPH KIRK LAND
LUMBER CITY PA.

ENV. NO. *A2*
SHEET NO. *62*
55-3-110

DATE 2-24-19.

SCALE 1" = 400'

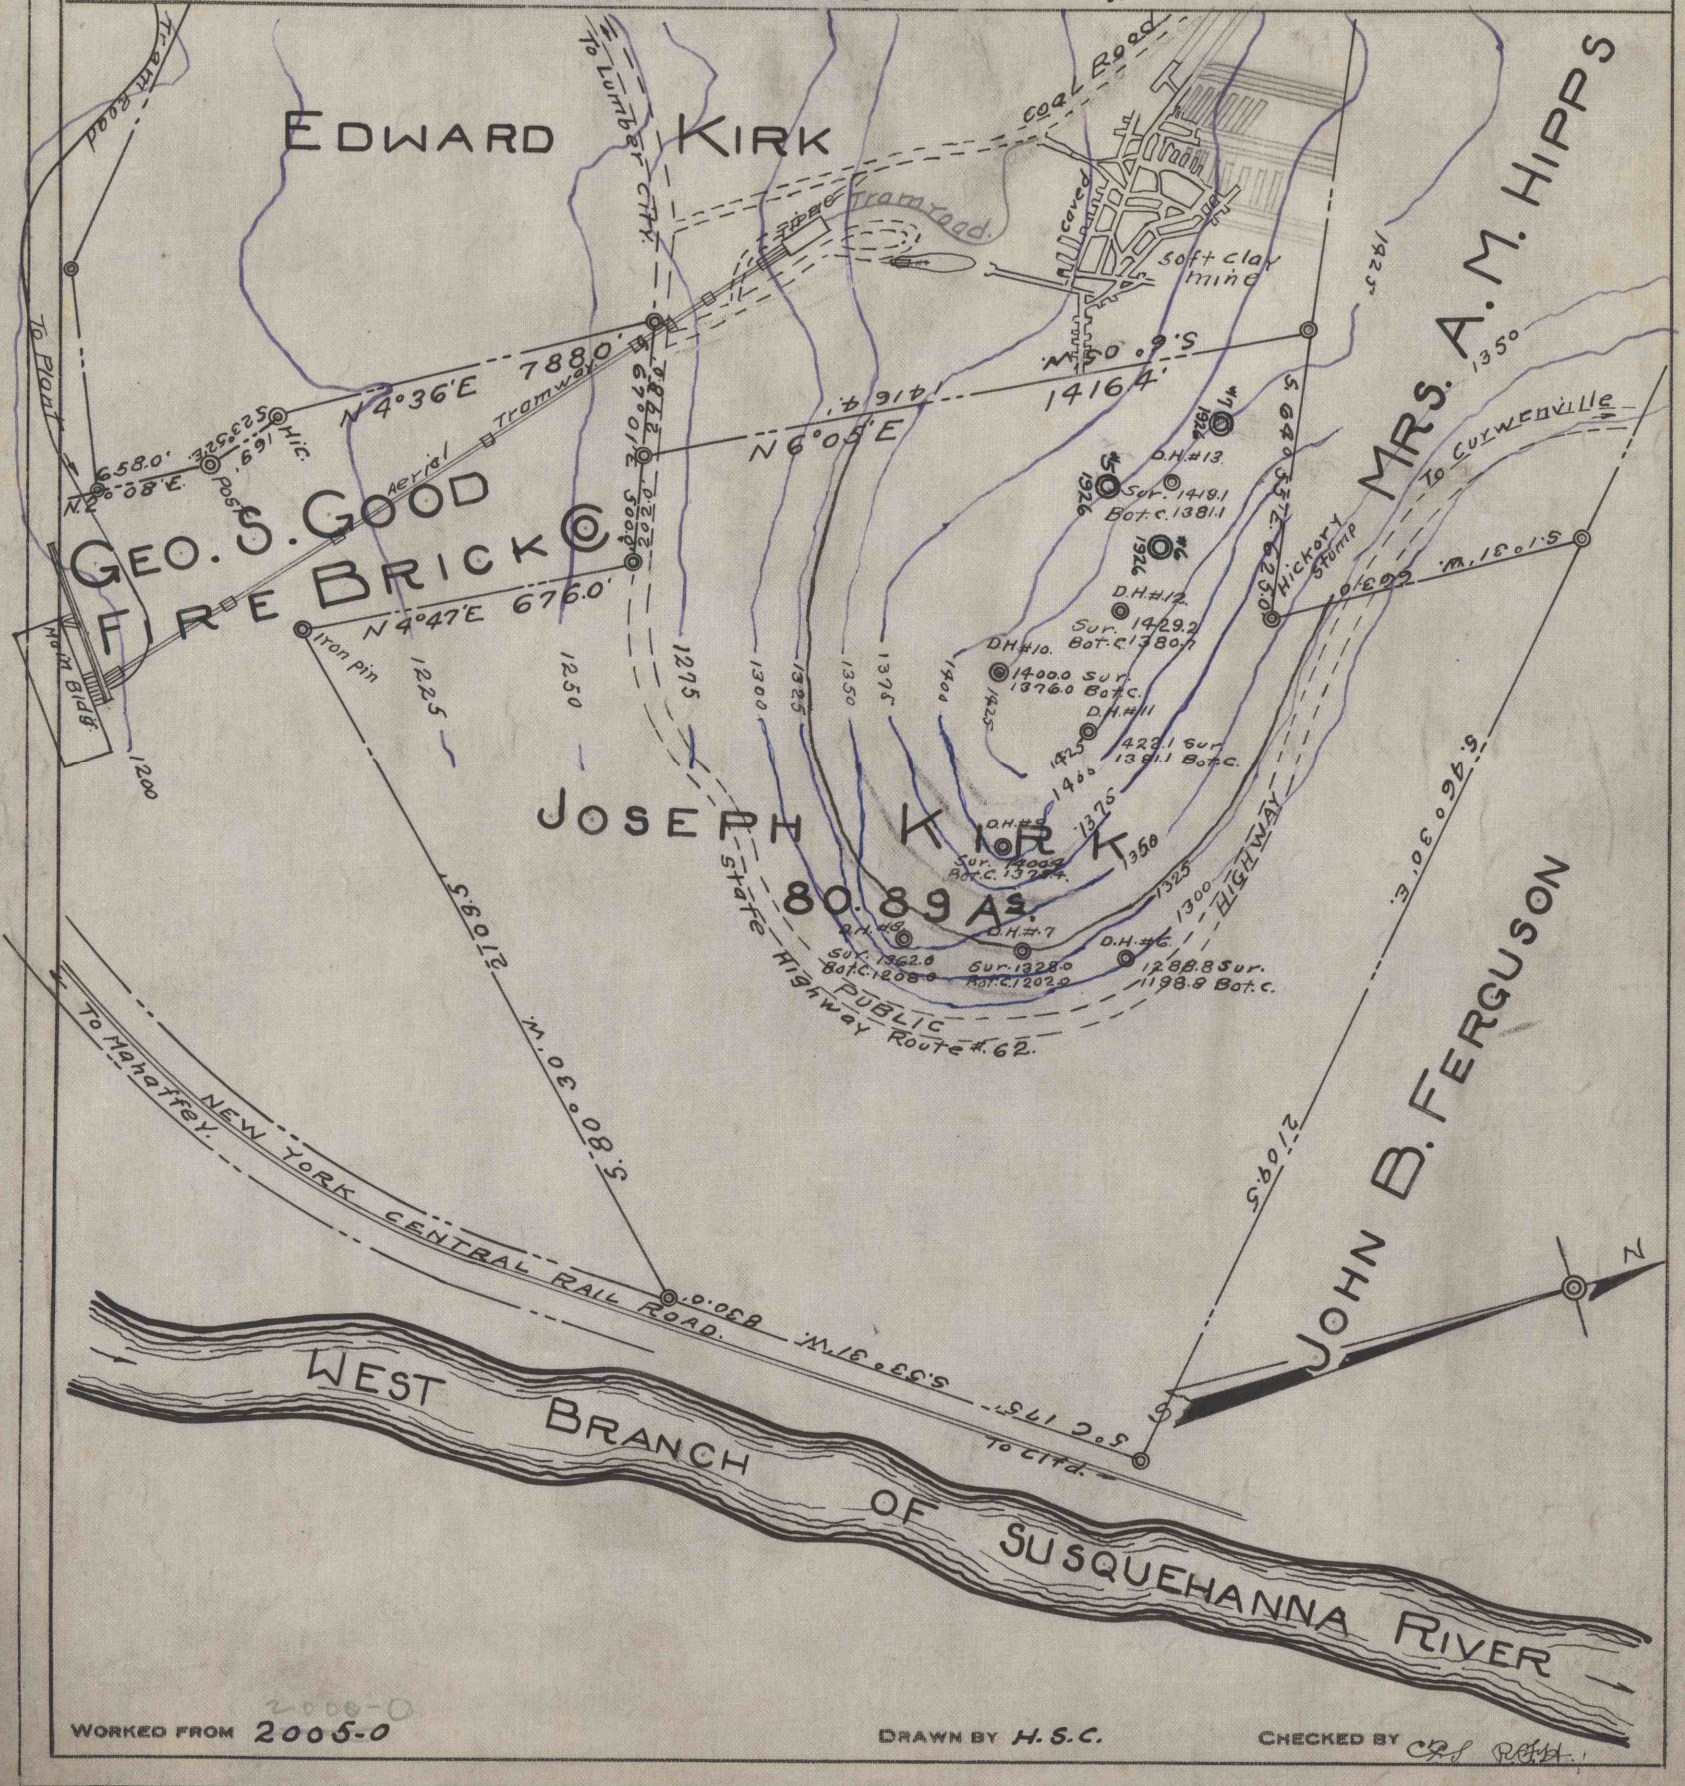

WORKED FROM *2005-0*
2005-0

DRAWN BY H. S. C.

CHECKED BY *CRJ REHA*