


REFERENCE DATA

CRESCENT REFRACTORIES CO.  
CURWENSVILLE, CLEARFIELD COUNTY, PA.  
ENGINEERING DEPARTMENT  
CHAS. AND JAS. M. CALDWELL TRACTS  
SHOWING OUTCROP, "D" COAL

ENV. No. *M2*  
SHEET No. *66*  
*55-3-134*

SCALE 1" = 400'

DATE 2-25-19

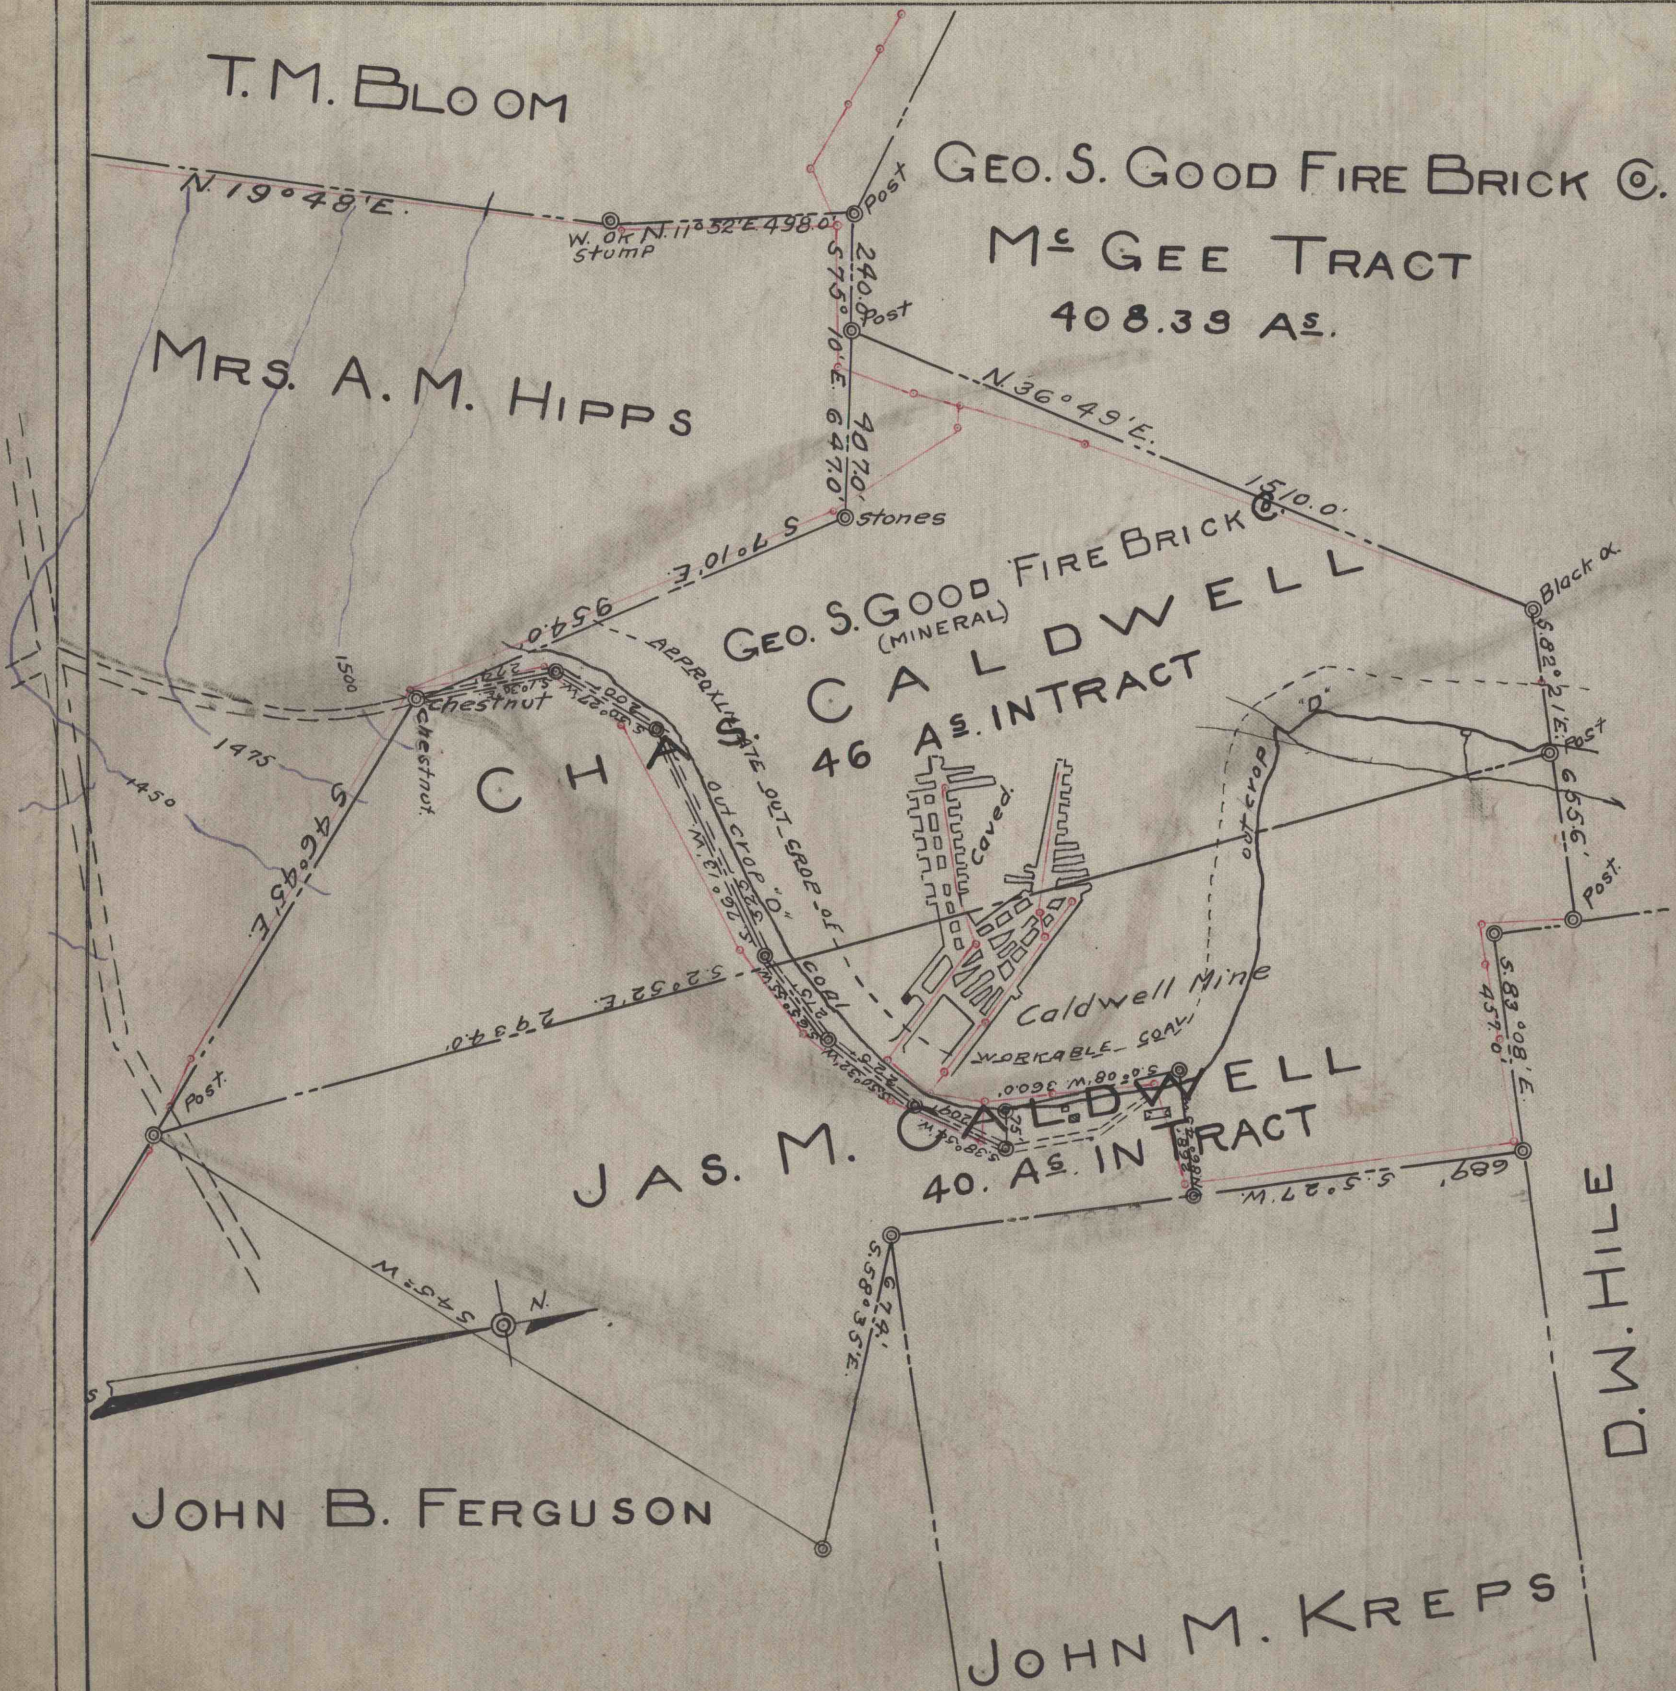

2009-0  
WORKED FROM 2005-0

DRAWN BY H. S. C.

CHECKED BY *R. H. H.*  
*C. J. S.*

2000-0