

REFERENCE DATA

CRESCENT REFRACTORIES CO.

CURWENSVILLE, CLEARFIELD COUNTY, PA.

ENGINEERING DEPARTMENT

Map Showing Area and Workings of the Kirk Soft Clay Mine


ENV. No. 01

SHEET No. 79

57-2-10

DATE May 31, 1922

SCALE $1" = 400'$

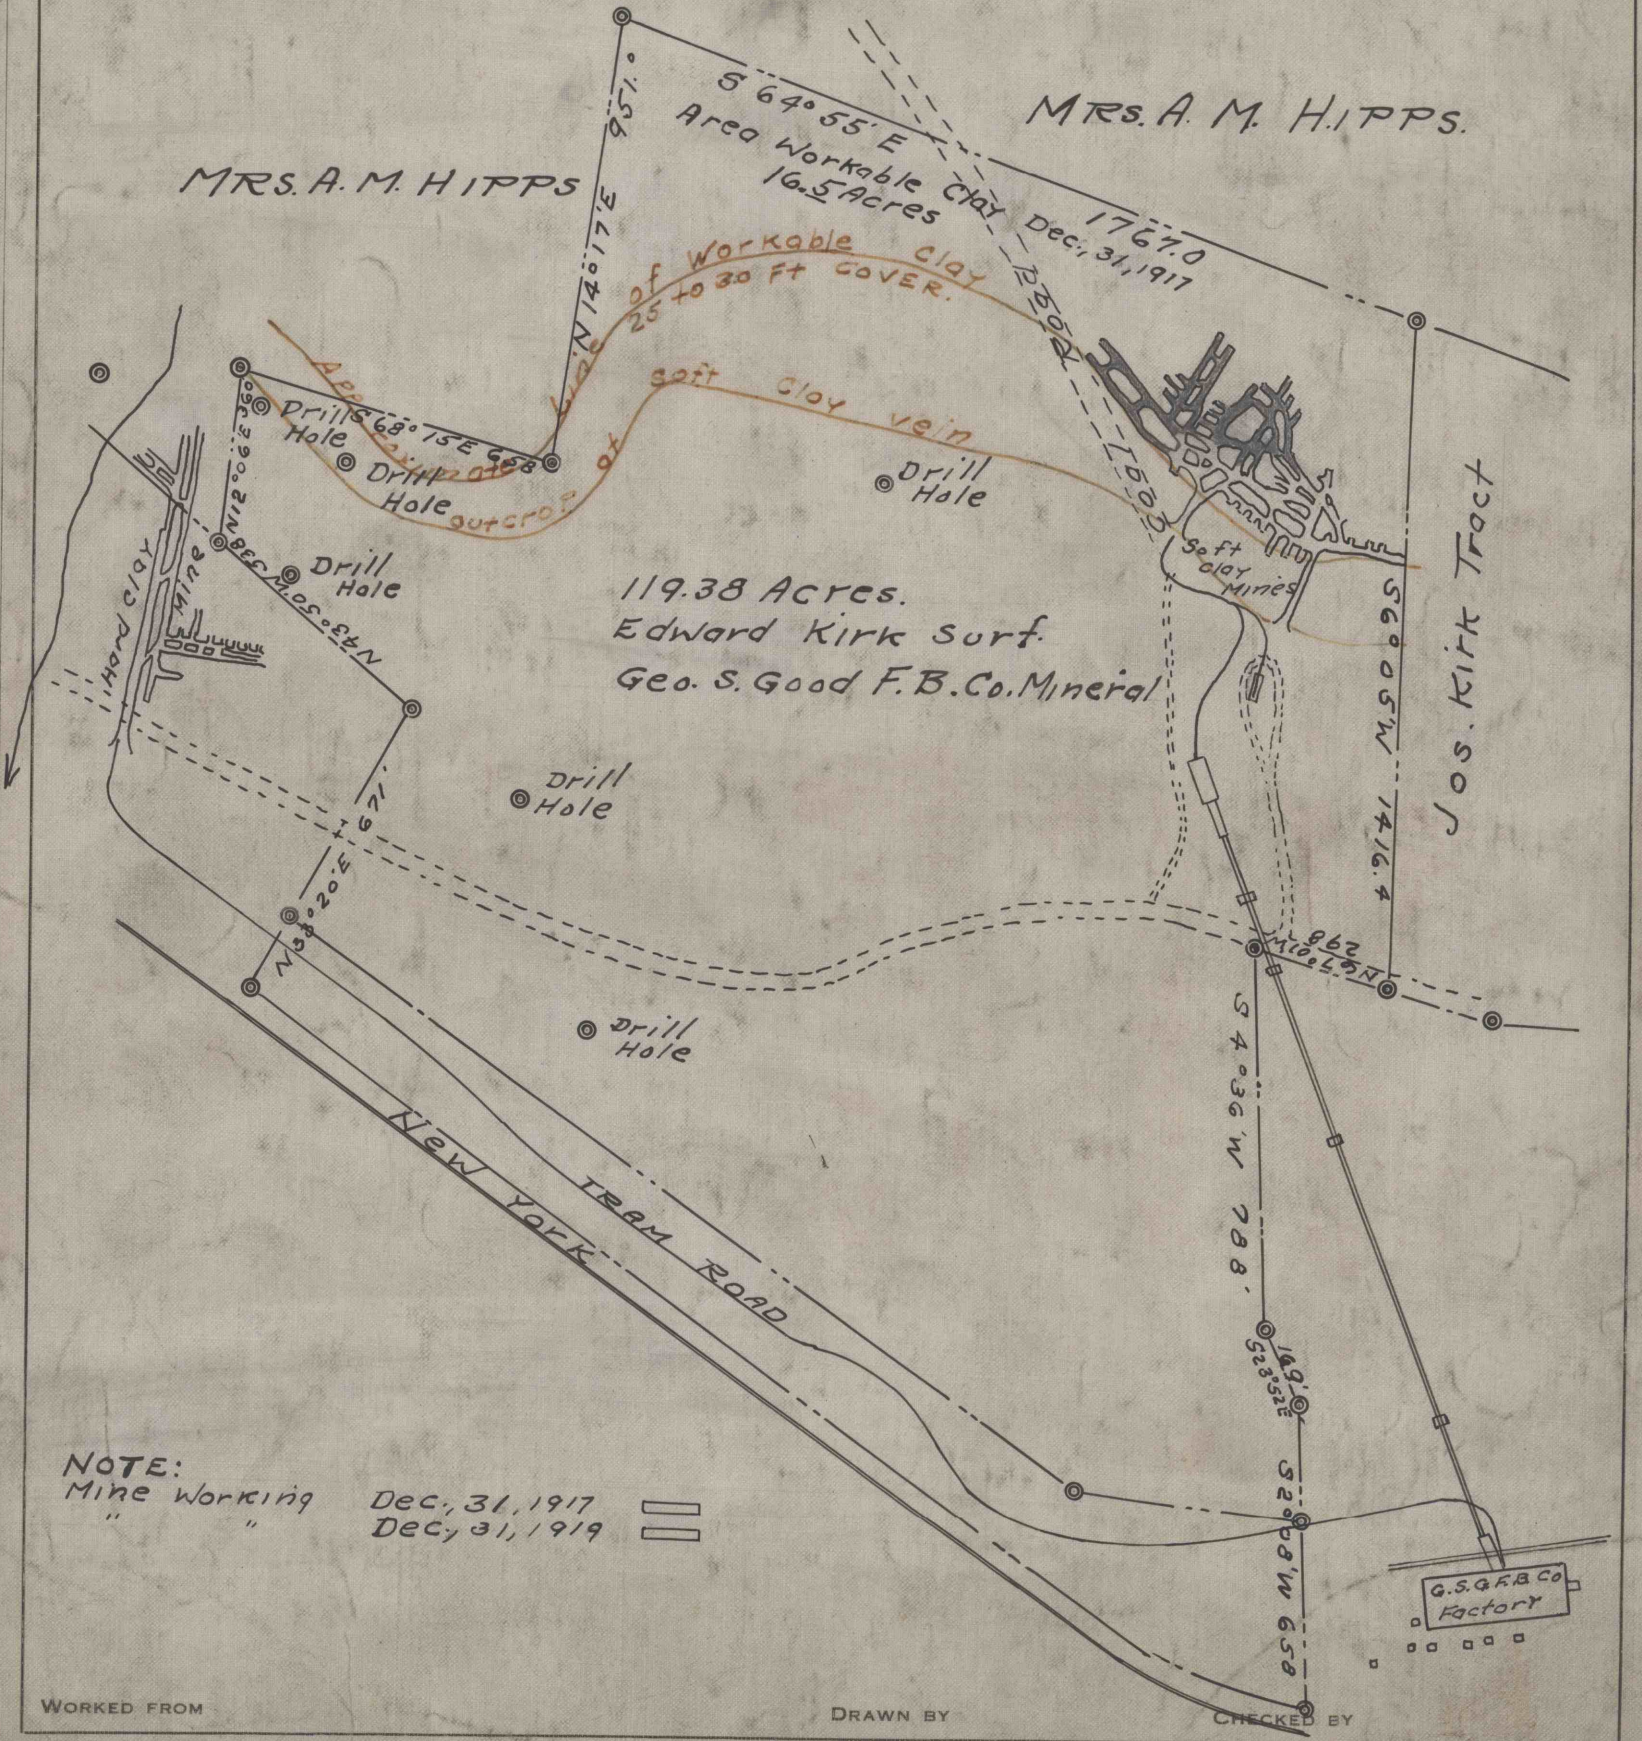

NOTE:
 Mine Working Dec, 31, 1917
 " " Dec, 31, 1919

WORKED FROM

DRAWN BY

CHECKED BY