

CRESCENT REFRACTORIES CO.

CURWENSVILLE, CLEARFIELD COUNTY, PA.
ENGINEERING DEPARTMENT

ENV. No. 172

SHEET NO. 60


57-2-14

EDWARD KIRK

LUMBER CITY SOFT CLAY MINE

DATE 2-29-19

SCALE 1" = 400'

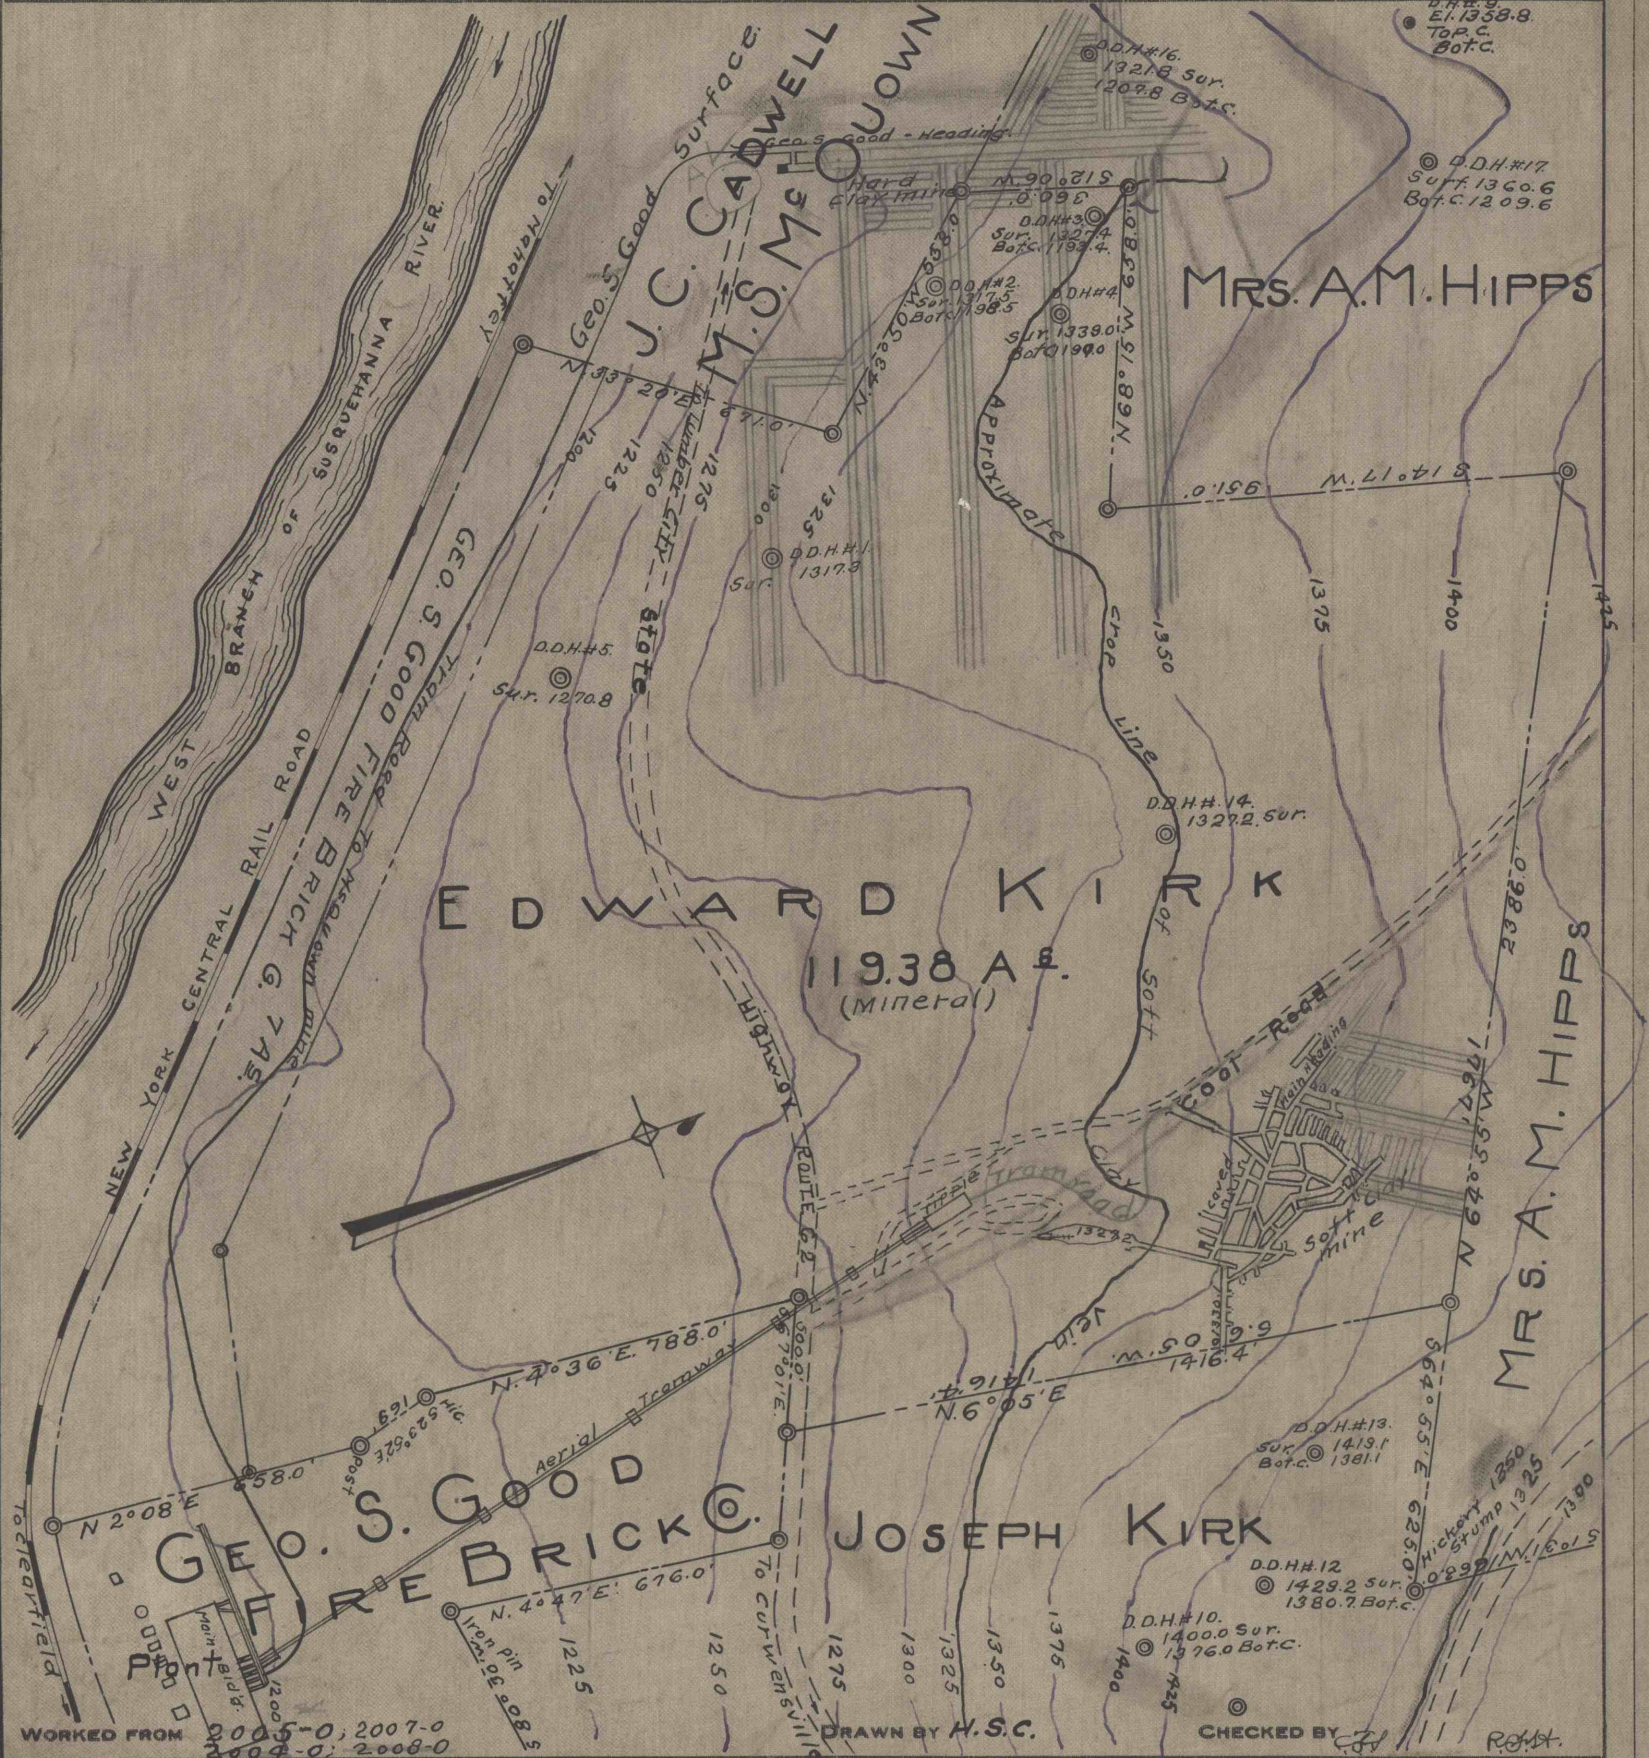

WORKED FROM 2005-0, 2007-0
2008-0, 2008-0

DRAWN BY H.S.C.

CHECKED BY R.H.H.

R.H.H.