

REFERENCE DATA

CRESCENT REFRACTORIES CO.

CURWENSVILLE, CLEARFIELD COUNTY, PA.

ENGINEERING DEPARTMENT

SOFT CLAY MINE

EDWARD KIRK TRACT

AS OF DATE OF PURCHASE MAY, 26, 1917


ENV. No. 01

SHEET No. 76

57-2-2

DATE 5-10-21

SCALE 1" = 400'

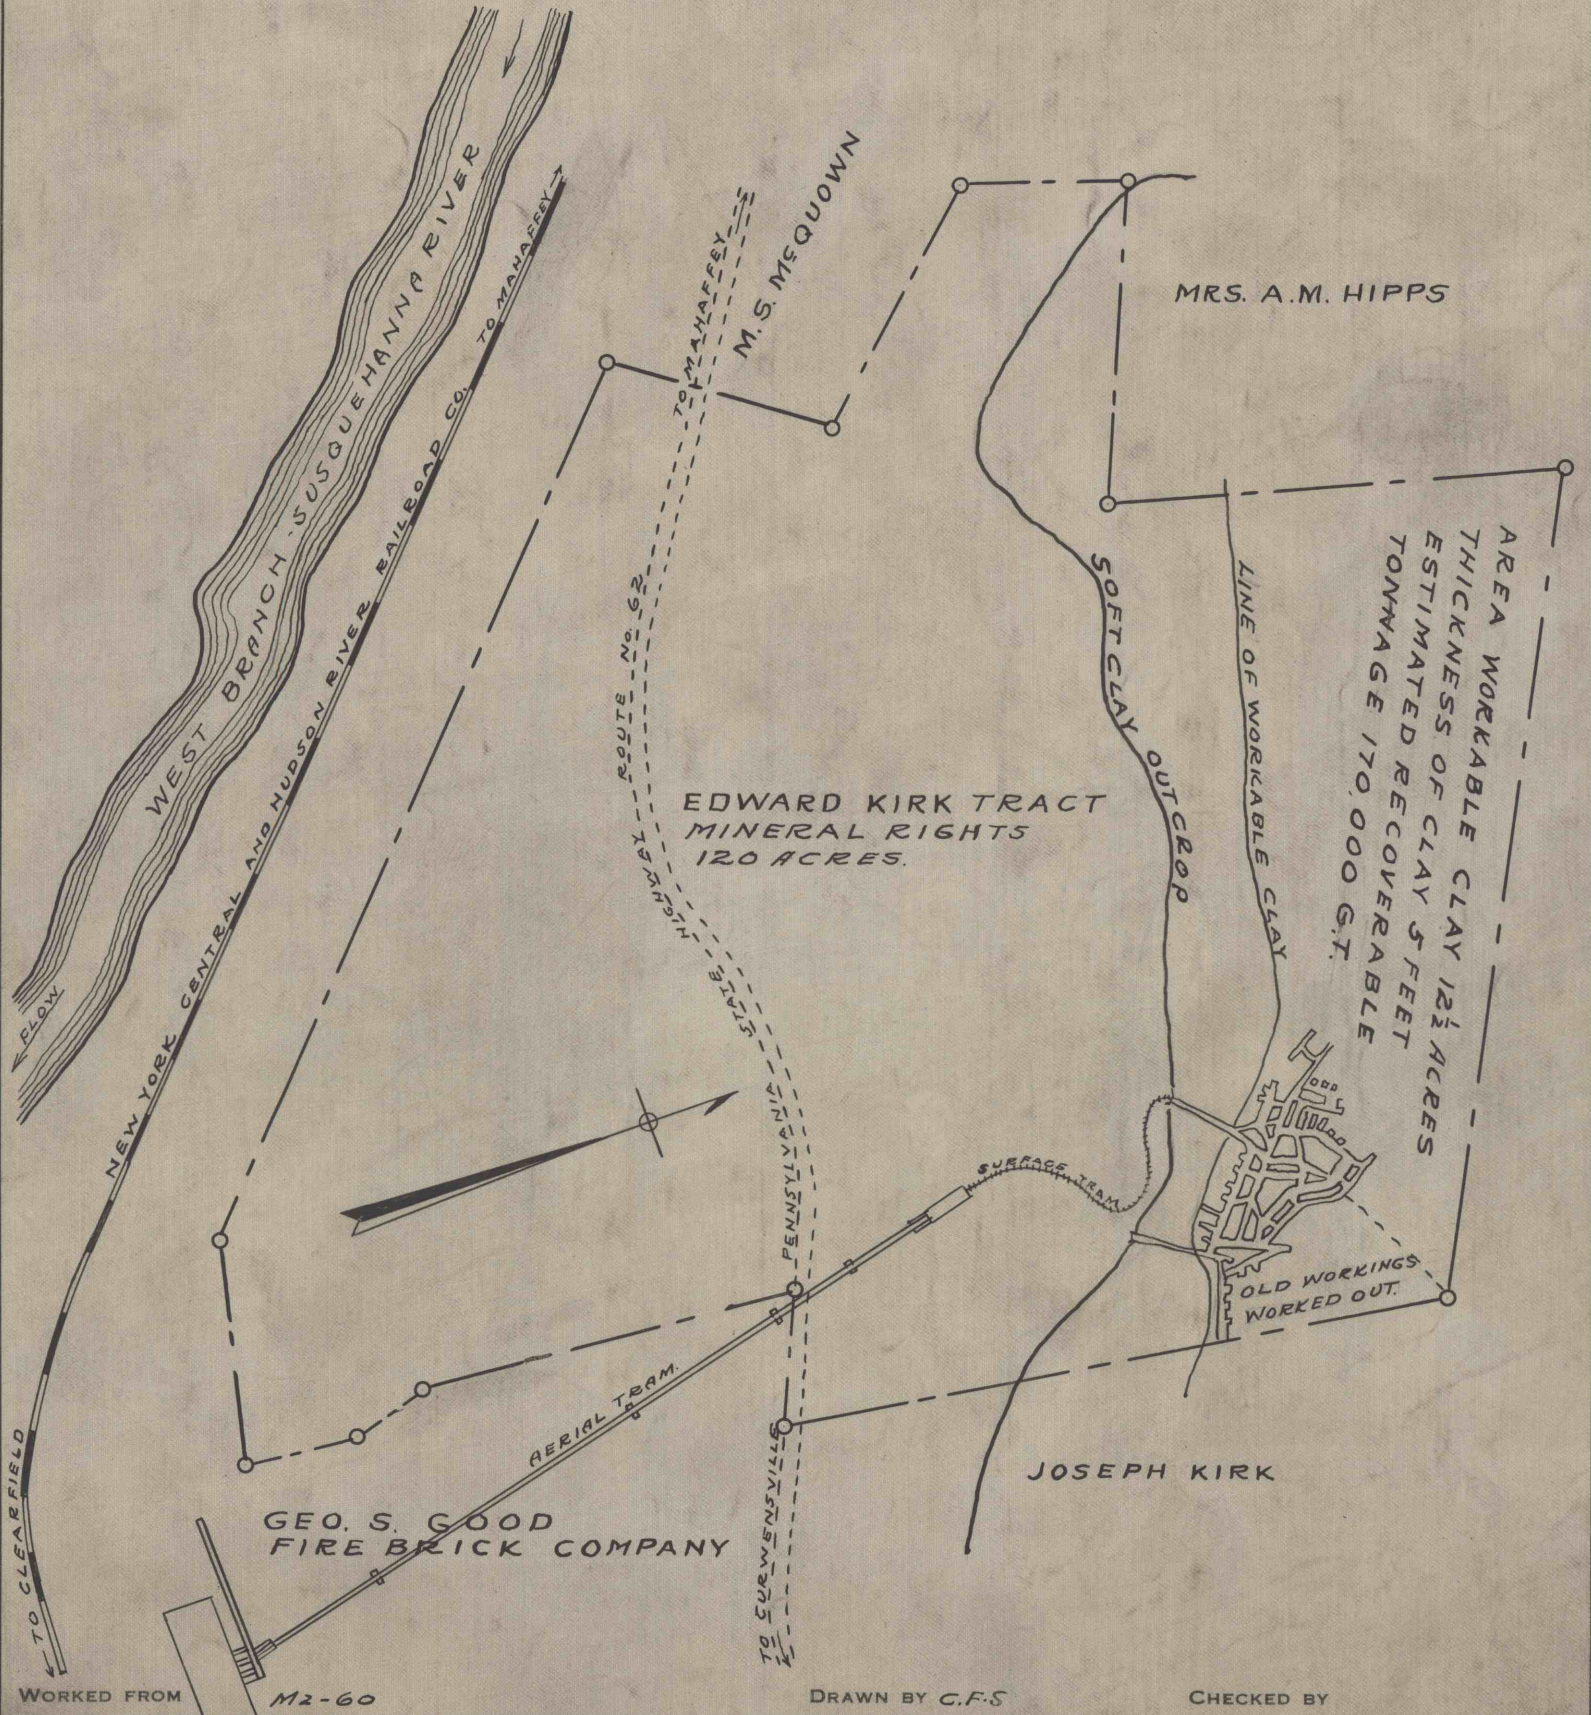

WORKED FROM

M2-60

DRAWN BY C.F.S

CHECKED BY