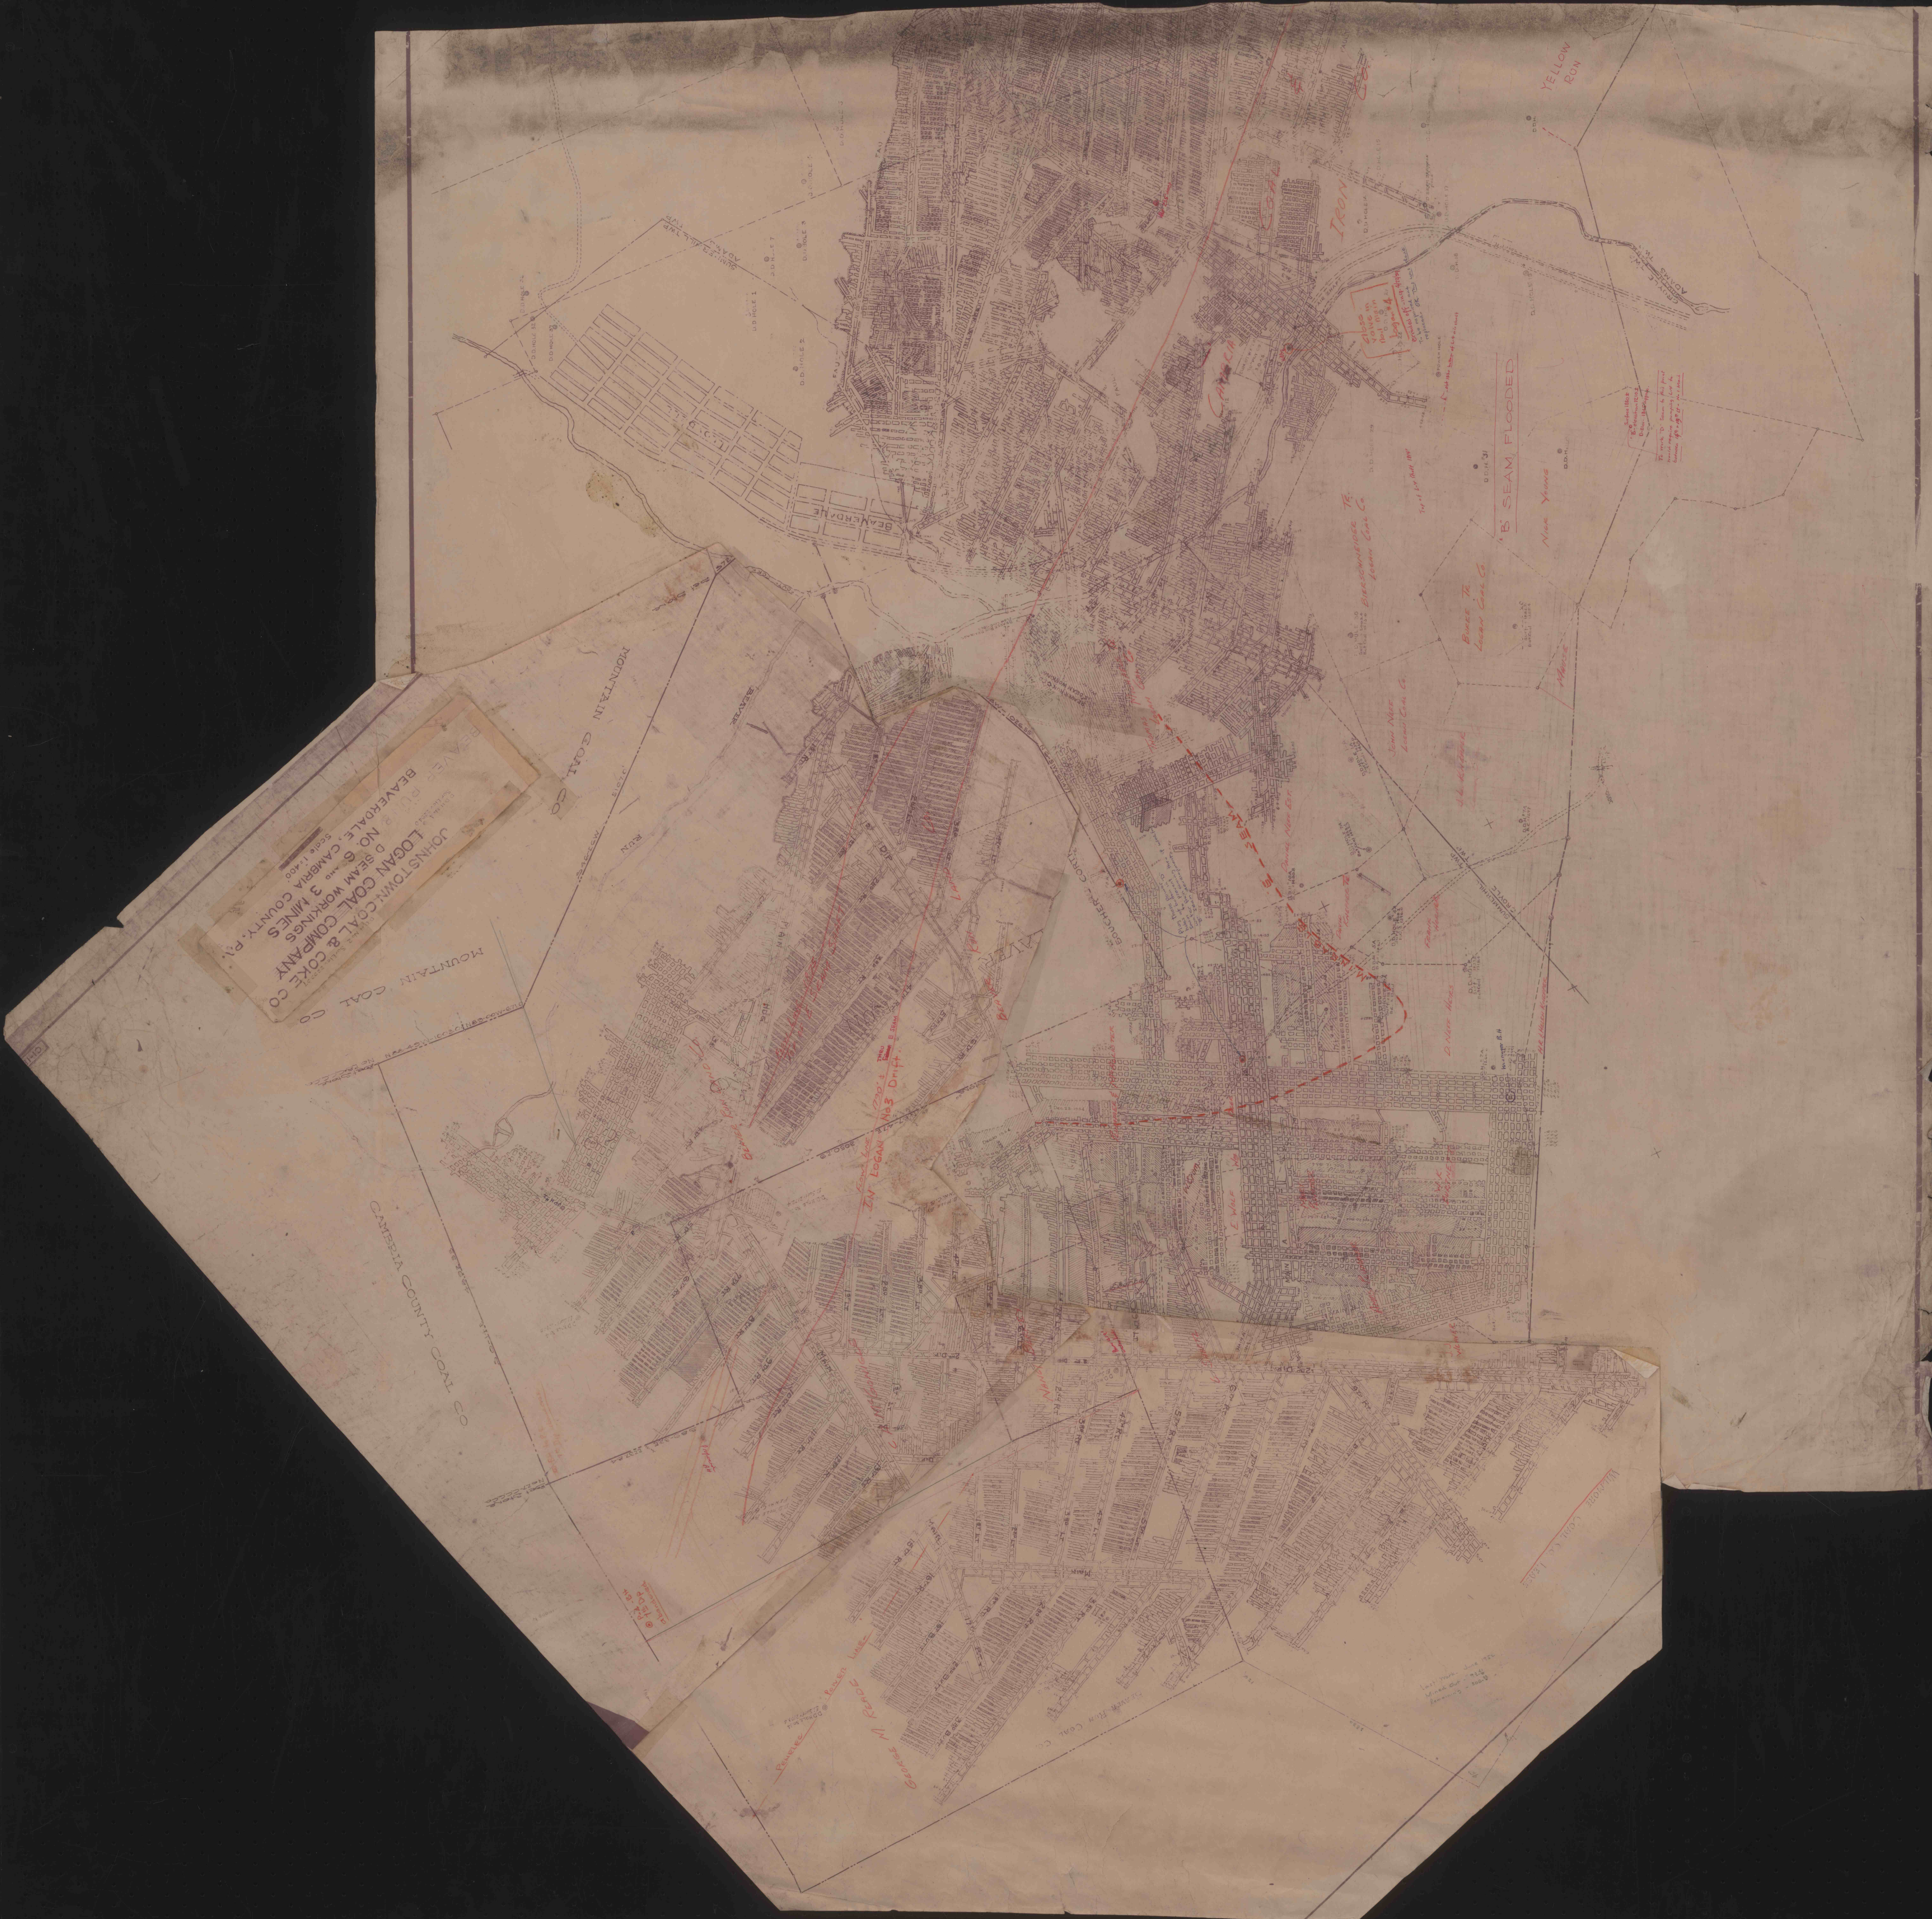
JOHNSTOWN COAL & COKE CO
LOGAN COAL COMPANY
D SEAM WORKINGS
NO. 6 AND 3 MINES
BEAVERDALE, CAMBRIA COUNTY, PA.
Scale 1:400
MOUNTAIN COAL CO
CAMBRIA COUNTY COAL CO
BEAVERDALE
YELLOW RUN
"B" SEAM FLOODED
NICK YOUNG
BURKE TR. LOGAN COAL CO.
BIERSCHNEIDER TR. LOGAN COAL CO.
JOHN NEFF LOGAN COAL CO.
J.L. KNEPPER
D NEFF HEIRS
IRON
CAMBRIA
BOUCHER CORNER
ADAMS TWP.
CROYLE TWP.
SUMMERHILL TWP.
POWER LINE
GEORGE M READE
IN LOGAN NO3 DRIFT
WILMORE COAL CO. LEASE
Last Work - June 1952