


MOUNTAIN GOAL CO.

BOUCHER-CORRIGAN  
OF SEAM  
OPERATION ON D. SEAM

Scale 1"=400'

Prepared by  
C. A. Hughes & Co.  
Cincinnati, Ohio

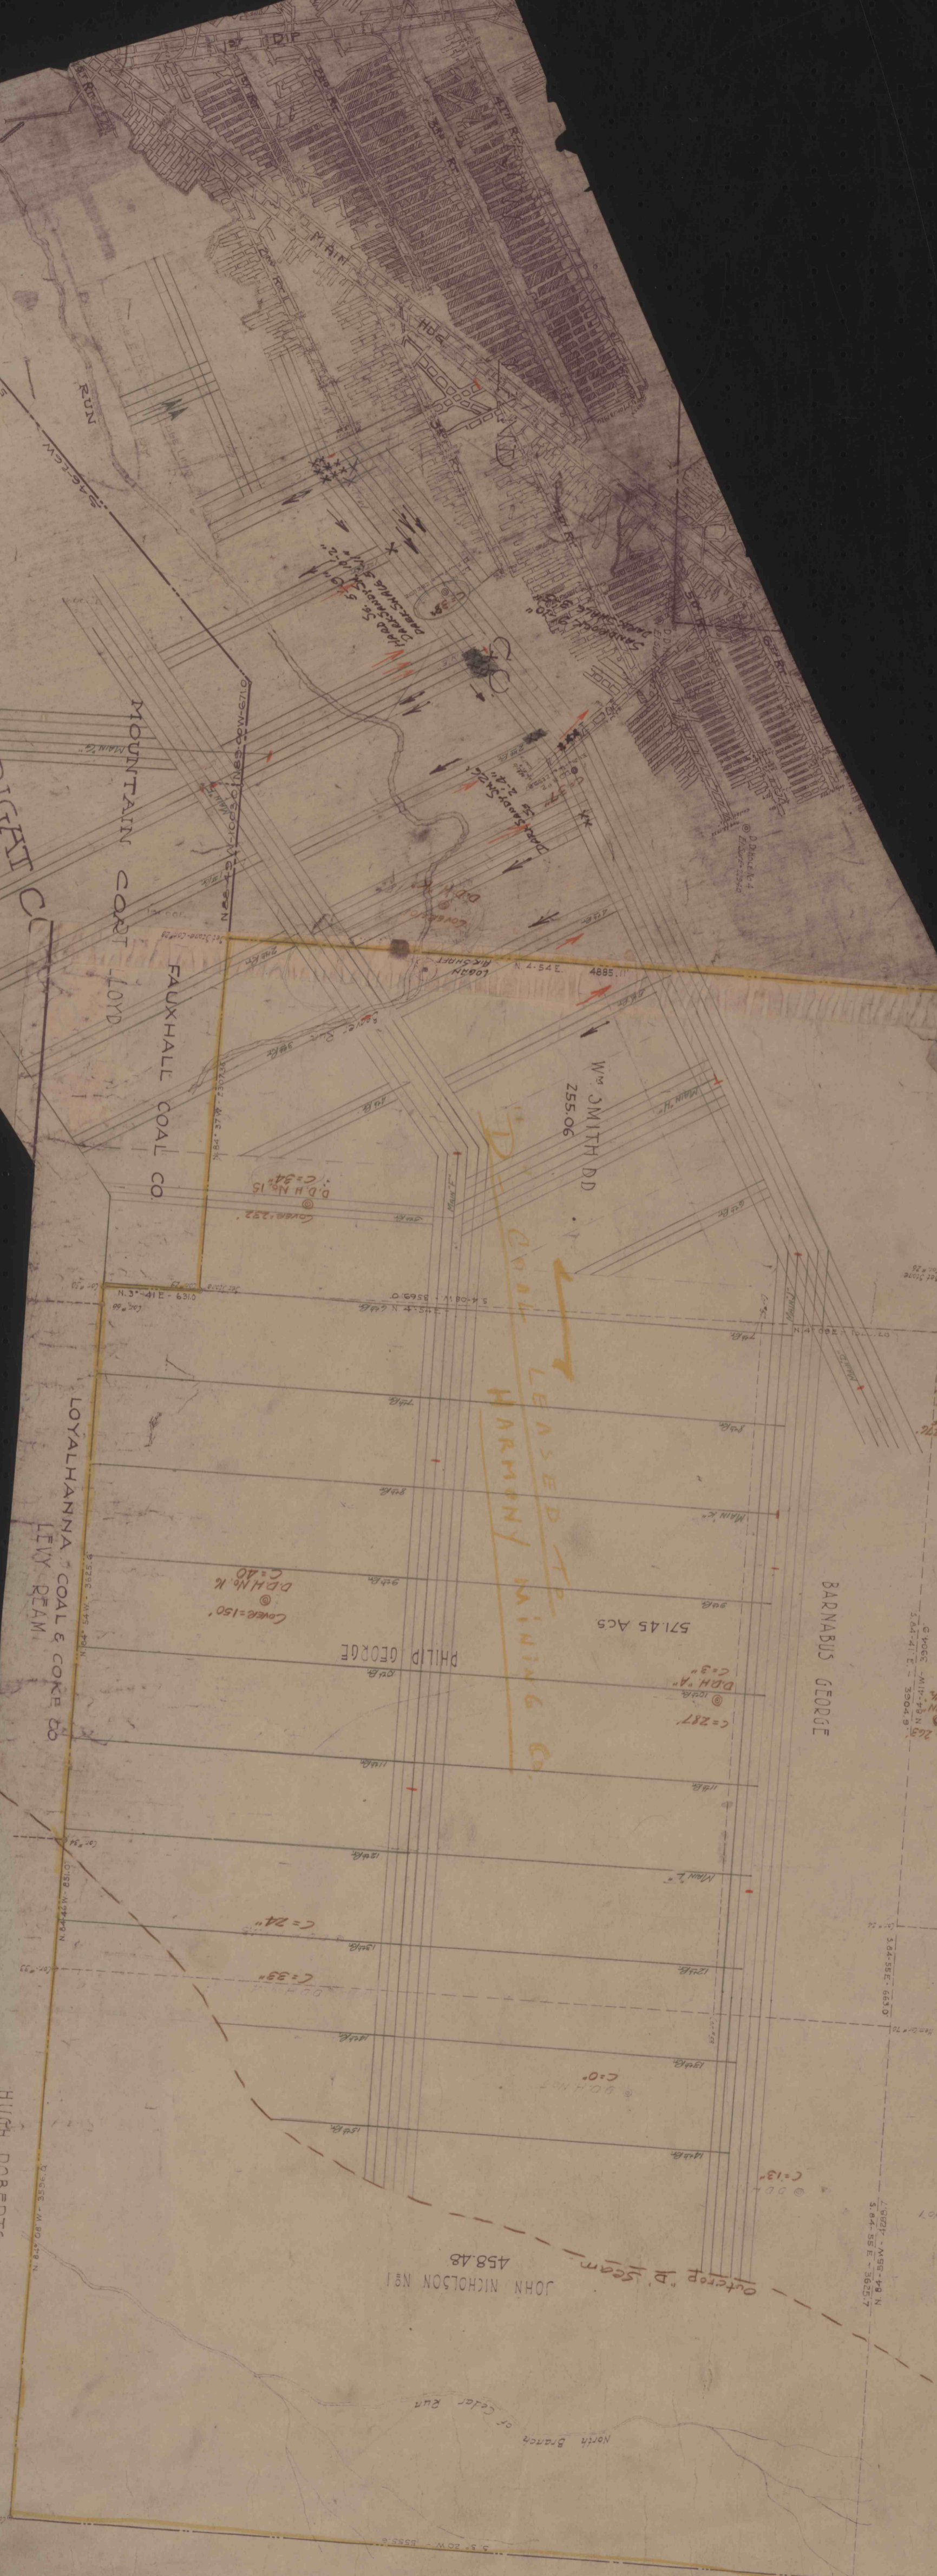

COAL LEASED TO  
HARMONY MINING CO.

MOUNTAIN GOAL COYD

FAUXHALL COAL CO

LOYALHANNA COAL & COKE CO  
LIVY BEAM

HUGH ROBERTS

JOHN NICHOLSON NO 1  
458.48

BARNABUS GEORGE

Wm SMITH DD  
255.06

PHILIP GEORGE

571.45 ACS

Outcrop "D" Seam  
458.48

