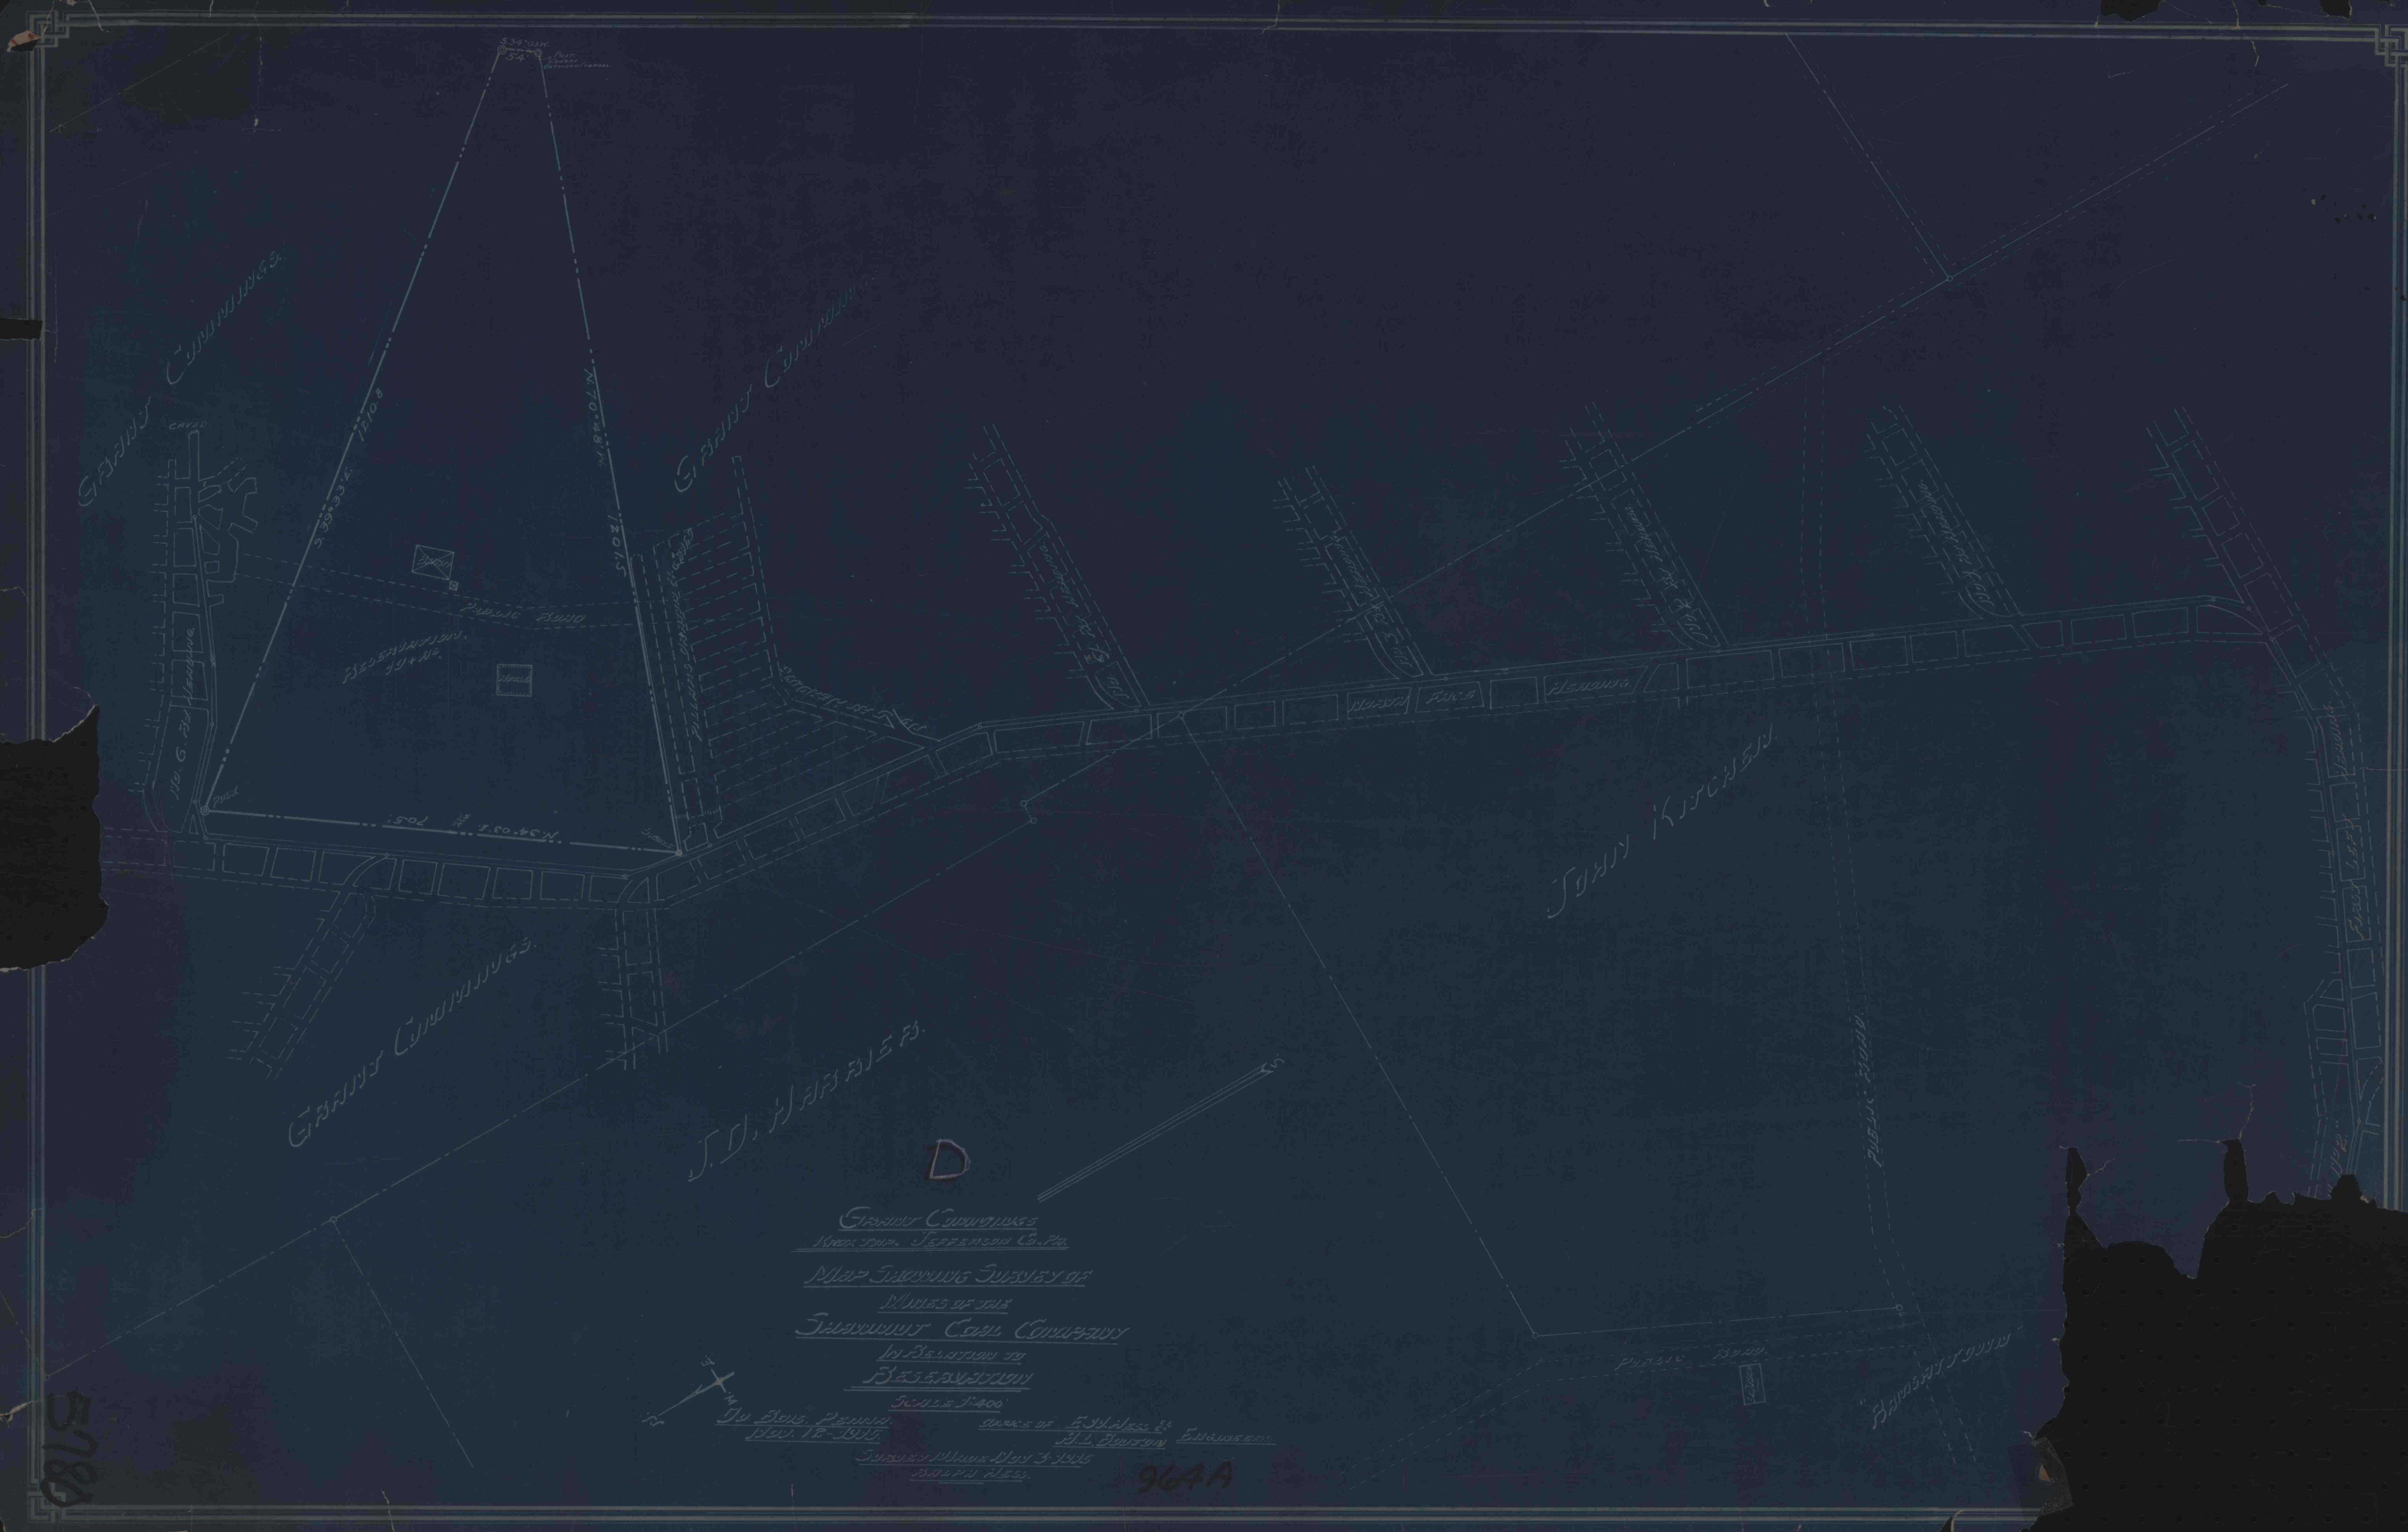
Grant Cummings
Grant Cummings
Grant Cummings
Grant Cummings
S.34°03'W.
54'
Post
N.70°48'W.
1201.5
S.39°33'E.
1210.8
Caved
No. 6 Bt. Heading
Barn
Public Road
Reservation
19+ Ac.
House
Post
705'
N.34°03'E.
No. 4 Bt. Heading
No. 3 Bt. Heading
North Face Heading
John Kitchen
J. D. Harrie Fs.
Public Road
Public Road
"Ramsey Town"
D
Grant Cummings
Knox Twp. Jefferson Co. Pa.
Map Showing Survey of
Mines of the
Shawmut Coal Company
In Relation to
Reservation
Scale 1"=400'
Du Bois, Penna.
Nov. 12-1915.
Office of E. W. Hess &
H. L. Bouton Engineers
Survey Made Nov 3-1915
Ralph Hess.
964A
5780