


59050R
10233

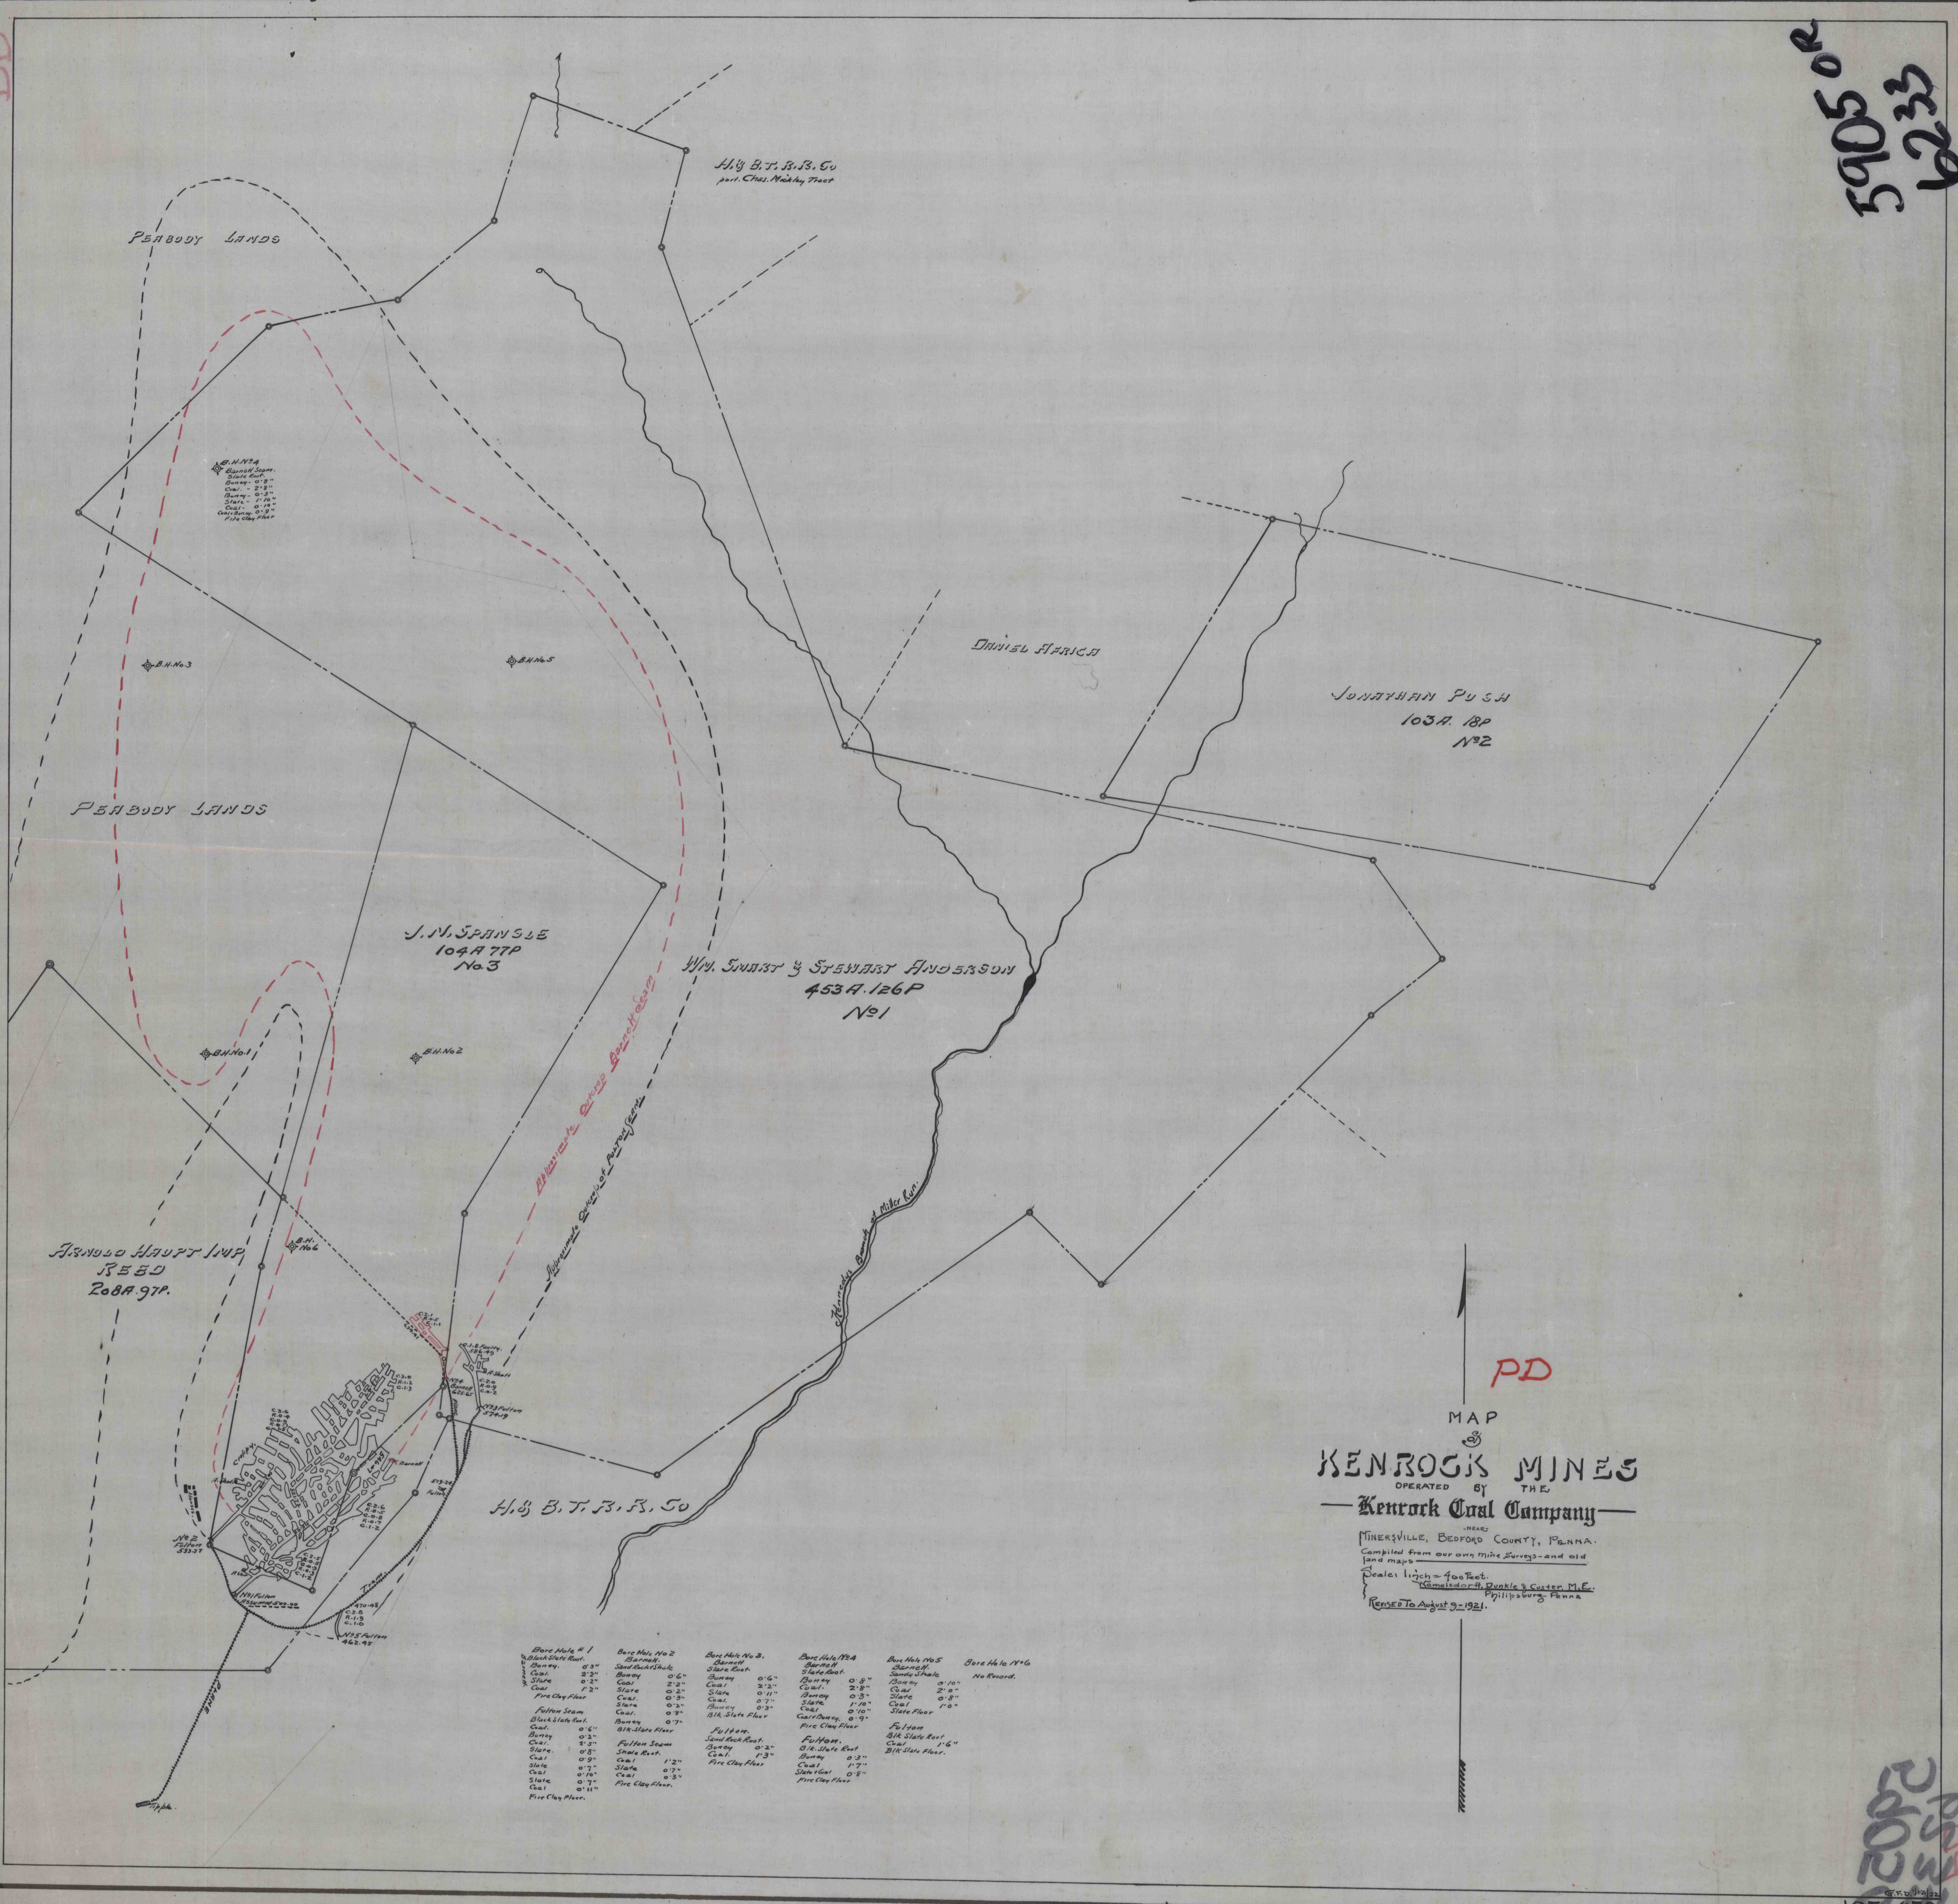

PD

MAP
&
KENROCK MINES
OPERATED BY
THE
Kenrock Coal Company

MINERSVILLE, BEDFORD COUNTY, PENNA.
Compiled from our own mine surveys and old
land maps
Scale: 1 inch = 400 feet
Name(s) of Surveyors: Dunkle & Custer, M.E.
Phillipsburg, Penna.
Revised to August 9, 1921.

Bore Hole No. 1	Bore Hole No. 2	Bore Hole No. 3	Bore Hole No. 4	Bore Hole No. 5	Bore Hole No. 6
Blank Slate Roof	Barnett	Blank Slate Roof	Blank Slate Roof	Blank Slate Roof	No Record
Burney 0.3"	Sandstone Shale	Burney 0.6"	Burney 0.3"	Burney 0.10"	
Coal 2.2"	Coal 2.2"	Coal 2.2"	Coal 2.2"	Coal 2.0"	
Slate 0.2"	Coal 0.3"	Coal 0.3"	Coal 0.3"	Slate 0.8"	
Coal 1.2"	Slate 0.3"	Slate 0.3"	Slate 0.3"	Coal 1.0"	
Fire Clay Floor	Coal 0.3"	Coal 0.3"	Coal 0.3"	Slate Floor	
Fulton Seam	Slate 0.3"	Blank Slate Floor	Fire Clay Floor	Coal 0.9"	
Blank Slate Roof	Burney 0.7"	Fulton Seam	Fulton Seam	Blank Slate Roof	
Coal 0.6"	Blank Slate Floor	Blank Slate Roof	Blank Slate Roof	Coal 1.6"	
Burney 0.3"	Burney 0.3"	Coal 0.2"	Burney 0.3"	Blank Slate Floor	
Coal 2.3"	Slate 0.3"	Slate 0.3"	Coal 1.3"		
Slate 0.8"	Coal 1.2"	Fire Clay Floor	Coal 1.7"		
Coal 0.9"	Slate 0.7"		Slate 0.8"		
Slate 0.7"	Coal 0.3"		Fire Clay Floor		
Coal 0.70"	Coal 0.3"				
Slate 0.7"	Coal 0.3"				
Coal 0.11"	Fire Clay Floor				

59050R
10233