


0929  
6529

0929  
6529

### GLOVER RUN OPERATIONS

SHOWING MINED AREA OF C SEAM WORKINGS DRIFTS \*2-4-6-8-10-12-14-16,  
AND  
MINED AREA OF D SEAM WORKINGS DRIFTS \*1-3-5-7-9  
SITUATED IN BELL TOWNSHIP CLEARFIELD CO. PA.  
OPERATED BY MADEIRA HILL COAL MINING CO.  
SCALE 1:2400 OCT 1920

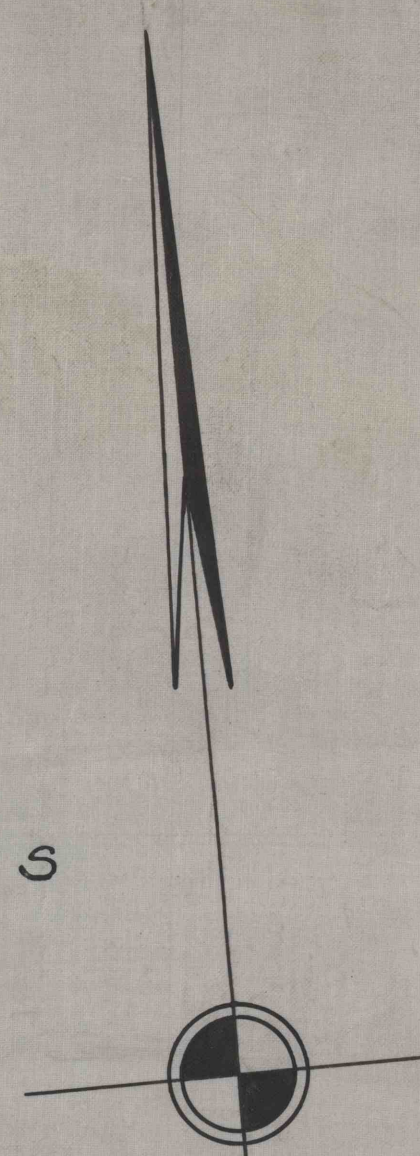

Stiemmer Heirs

A. C. Hopkins

E.A. Irvin & EIK Tanning Co.

Warrant # 5620.

Warrant # 5764.

J. M. London

Jas McAninch Miller & Simpson

Herry Lu Re.

Tract #1

Parcel #1

E. A. Irvin

Charlotte Korb

Parcel #9 Lot #13

Contains 50A 8 1/2 P.

Peter Krapp

100 A.

Warrant # 5904.

Lot #1

1065A. 106 P.

Lot #15

Parcel #16 Lot #19

Siman Steffey

Contains 50 A.

E.A. Irvin

Parcel #8 Lot #12

Luther Lowe

Contains 50A.

100 A.

Tract #2

Parcel #1

Parcel #14

Lot #18

Craig Mc Gee

Contains 116.5A.

Warrant # 5906

Lot #2

735A. 25P

M. E. Freedline

Henry L. Peace

Containing

Lot #10.

Know

Lot

Contains 109A.

Lot #1

Noak Miller

Geo. C. Miresell Heirs

Chas Shields

Lot #21

6509 A.

E. Daisher

K. Rupert

64A 38P.

Shields

Parcel #13

Lot #17 2358A

J. A. Duff

Jas. Mc Marious

Part of Warrant 5907.

Contains 715A. 117P.

Parcel #10

40A.

Foster Dorakue

John Bouck

Lot #14.

Warrant 5909

Jefferson County  
County  
Clearfield

