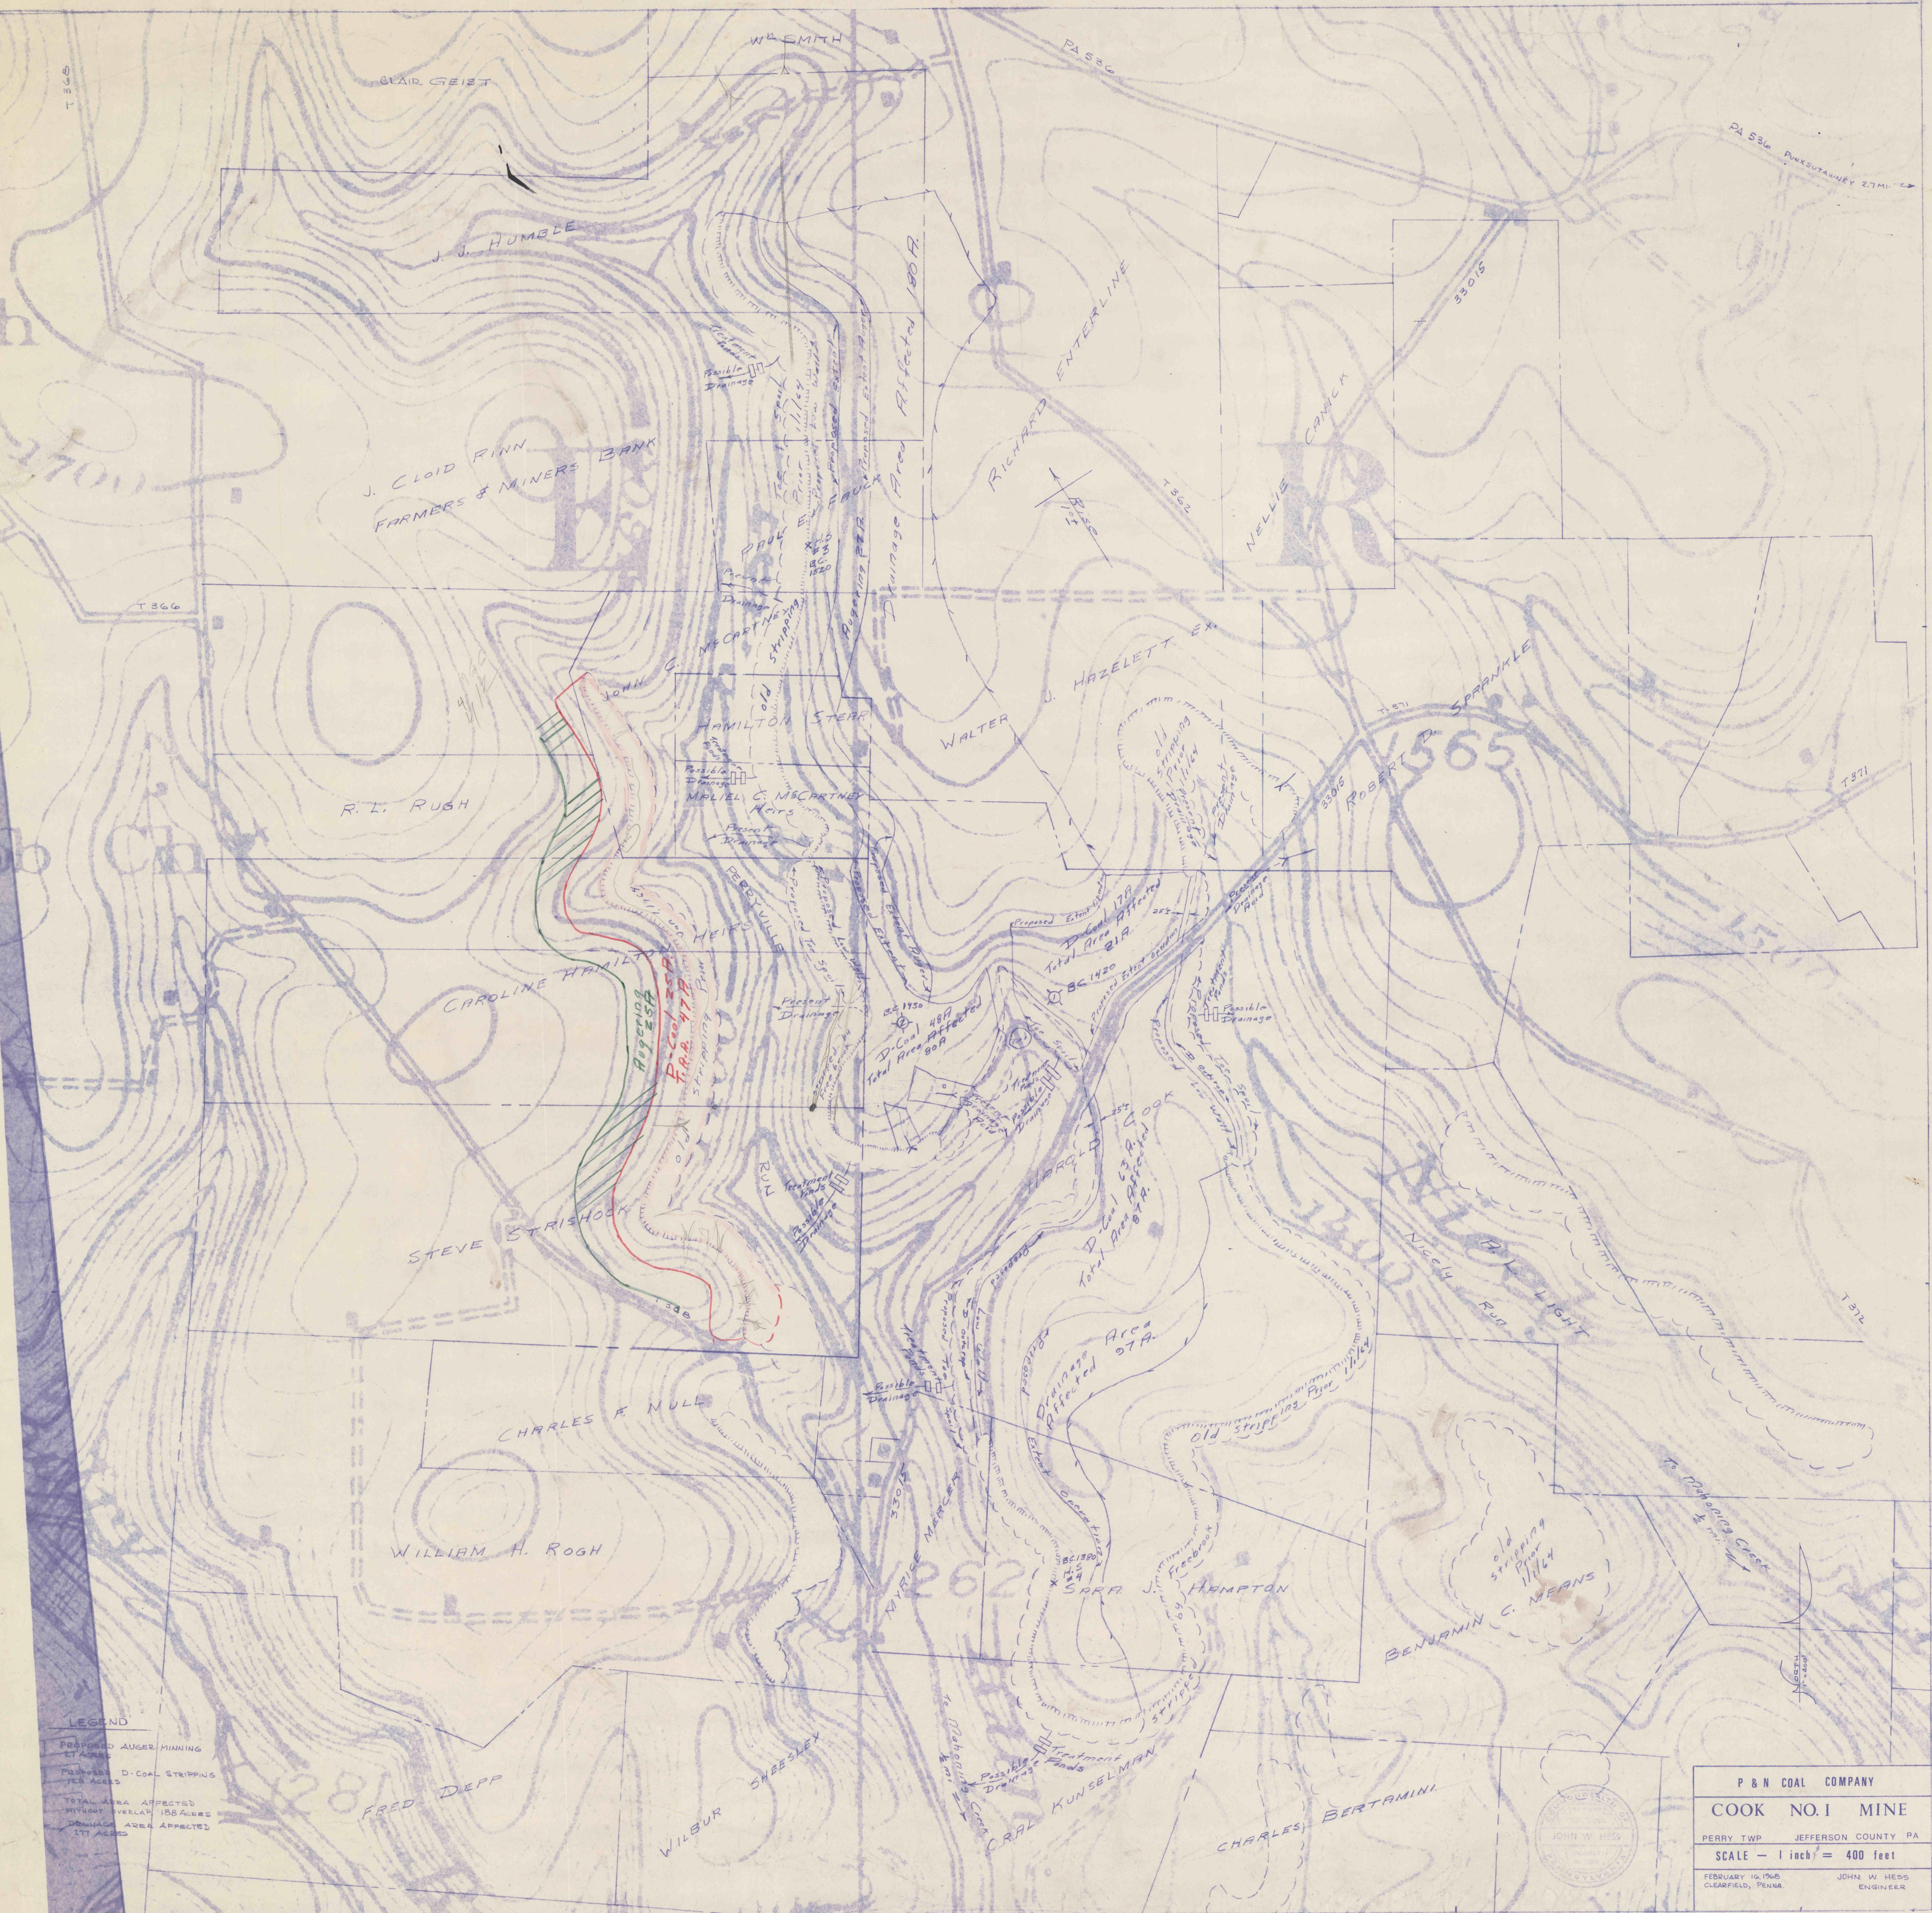


PC29

6539

PT
8063
P&N Cook #1