
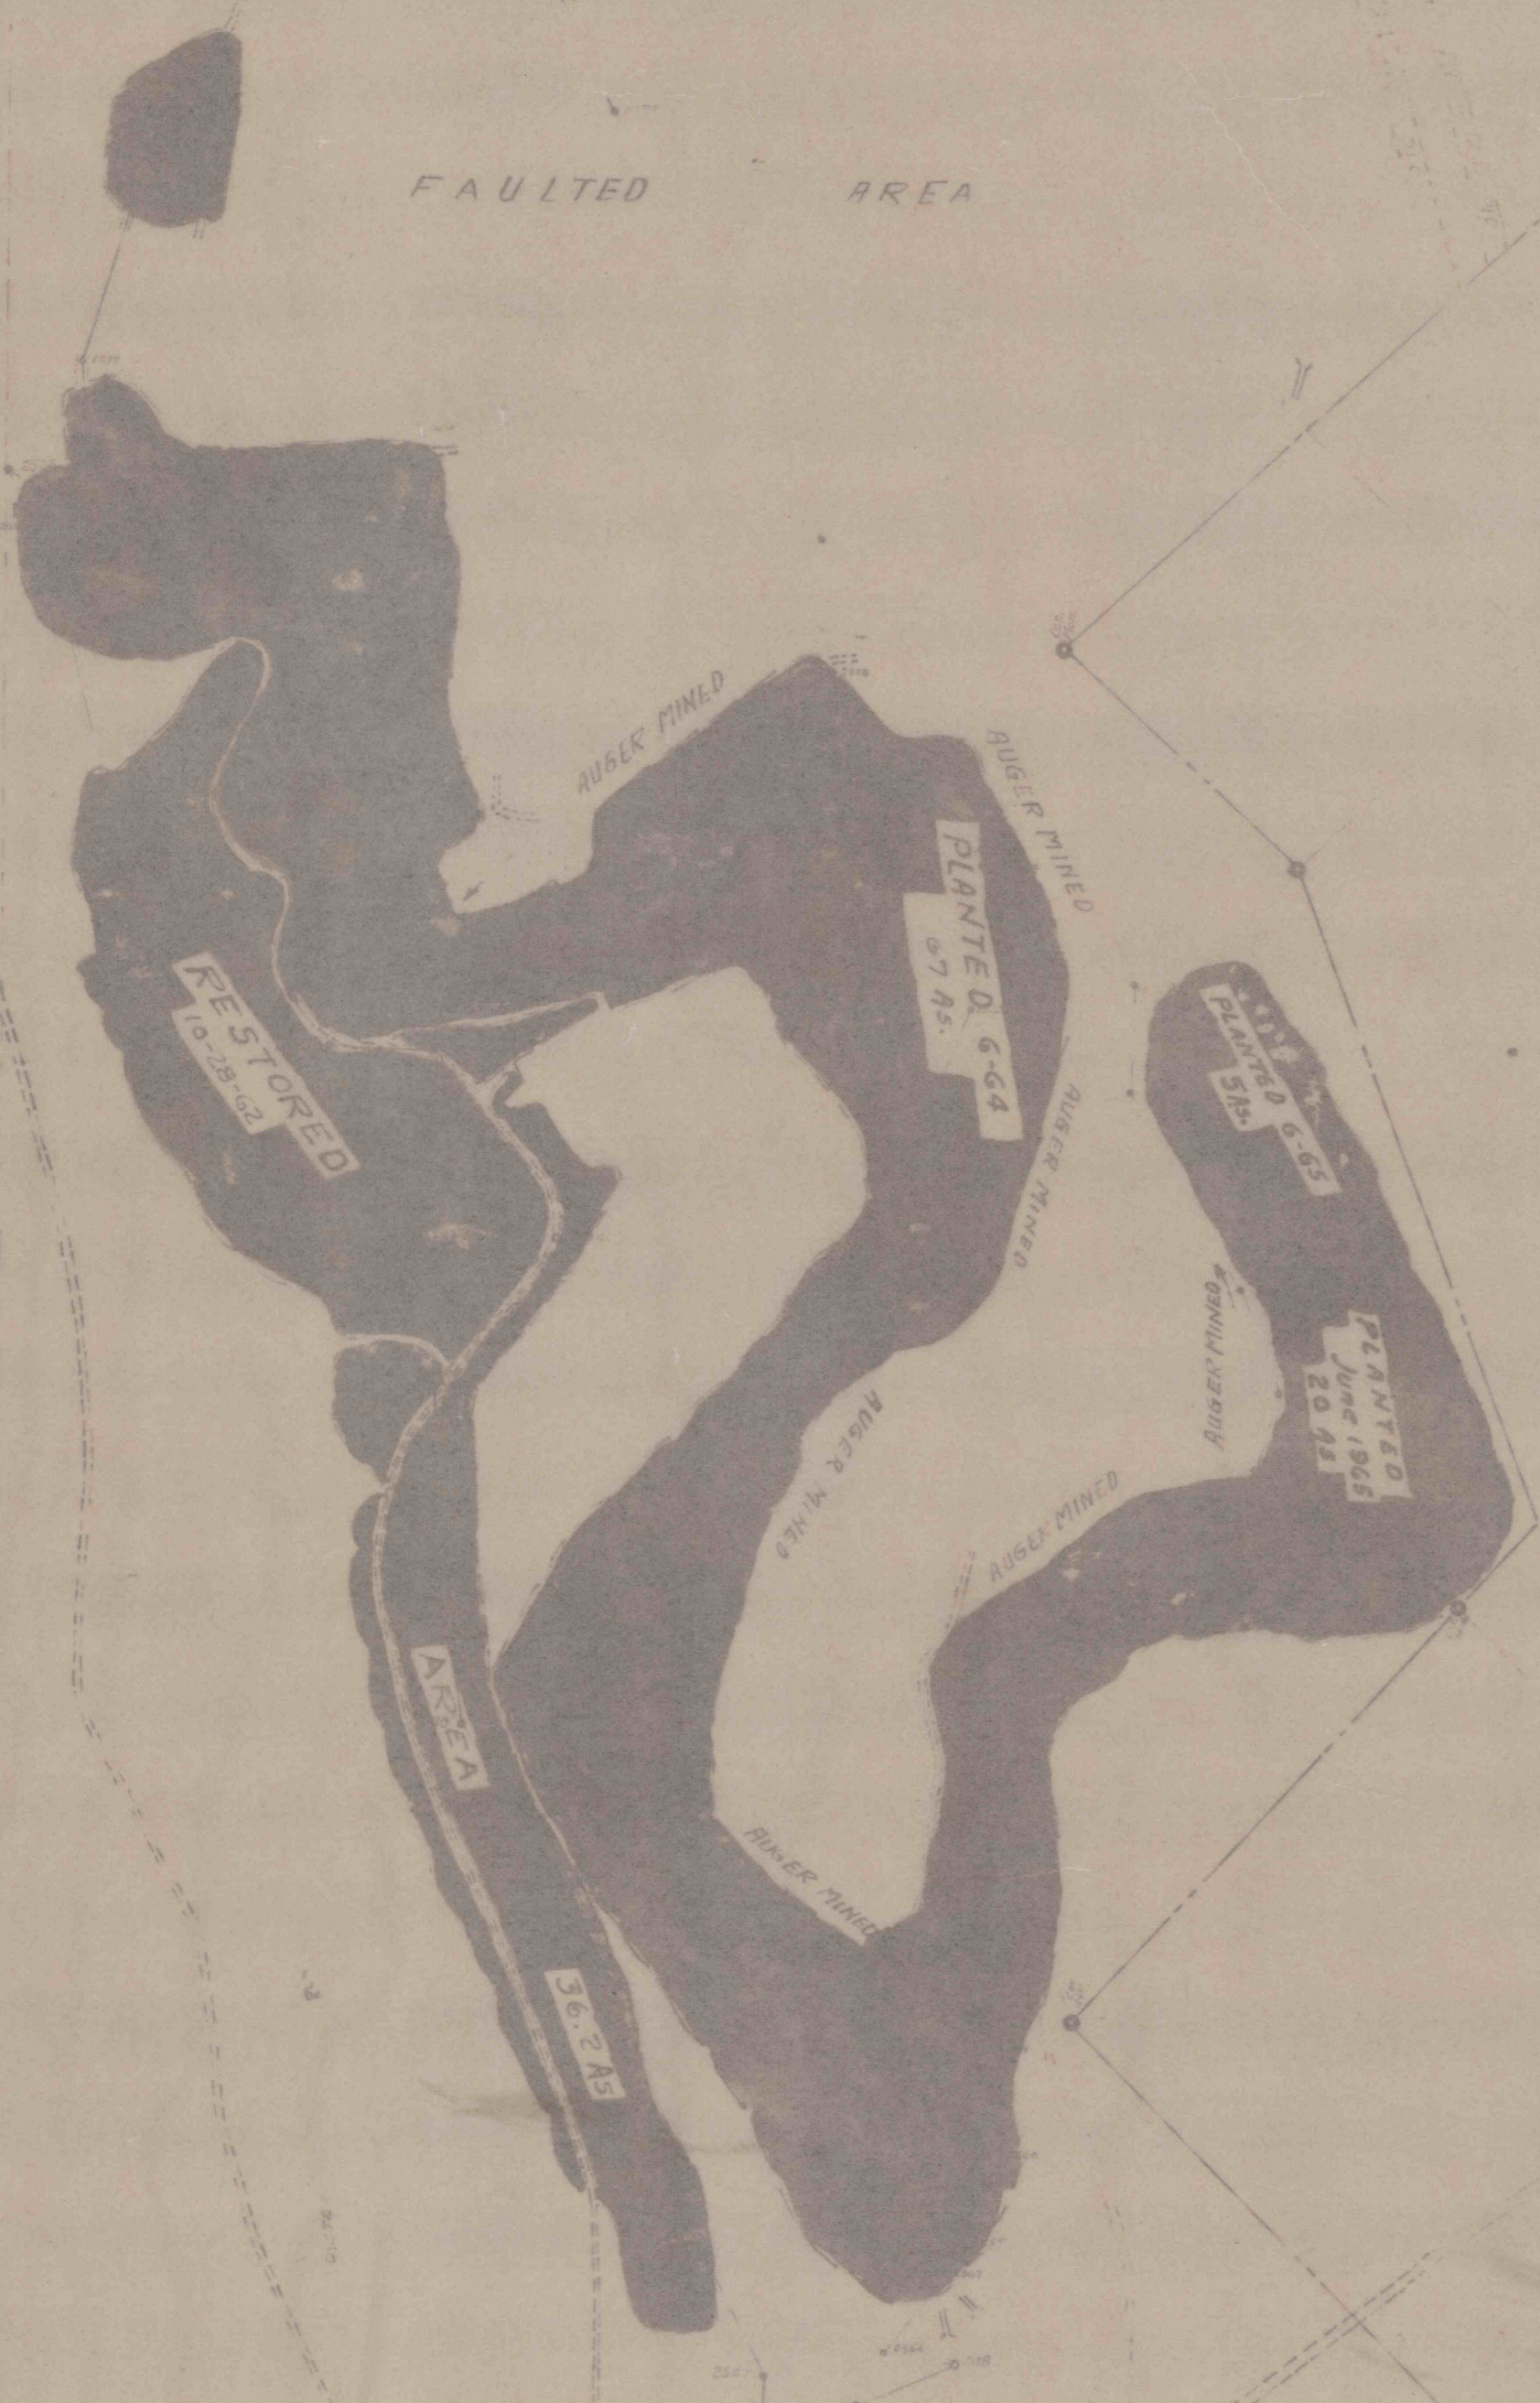


2080
X

NEW SHAWMUT MINING CO. FEE

NEW SHAWMUT MINING CO. Min.

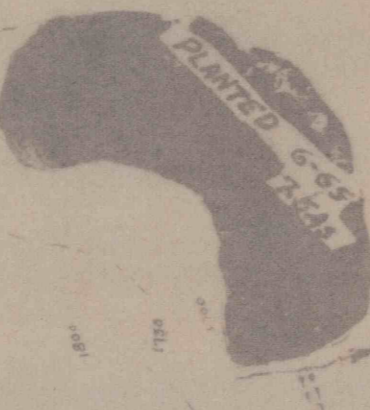

FAULTED AREA

FAULTED AREA

NORTHWESTERN MINING & EXCHANGE CO.
FEE
1061.92

NORTHWESTERN MINING & EX. CO. Min.

LESLIE BODEROCO Surf

43.11 AS

NORTHWESTERN MINING & EX. CO. Min.

LESLIE BODEROCO Surf

63.11 AS

FRANK J. FRANCISCO Surf

2.00 AS

EDWARD KOSCIUSKO Surf

JOE R. DUNBARCO Min

89 AS

JOE R. DUNBARCO FEE




NORTHWESTERN MINING & EX. CO. Min.

JOHN CUNEO Surf

NORTHWESTERN MINING & EX. CO. Min.

NORTHWESTERN MINING & EX. CO. Min.

NEW SHAWMUT MINING CO. Min.

LOUIS STARR Sr. Fee


BLUSEA COAL COMPANY
NO. 1 STRIP MINE

HORTON TWP ELK CO.

Scale 1" = 400' Oct. 28-60

Surveyed by *Eric Wilson* Reg. Eng.

Revised July 30, 1963
" Oct. 1, 1963
" Jan 1, 1964
" June 15, 1964
" Jan 1, 1965

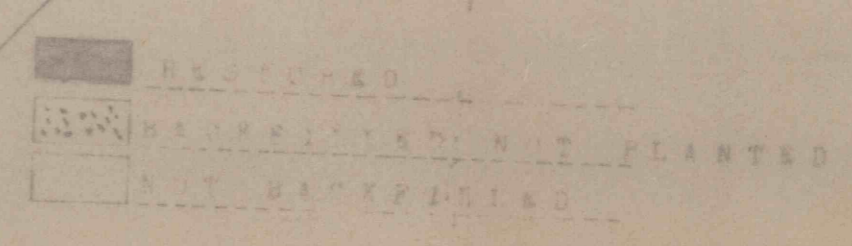

6566