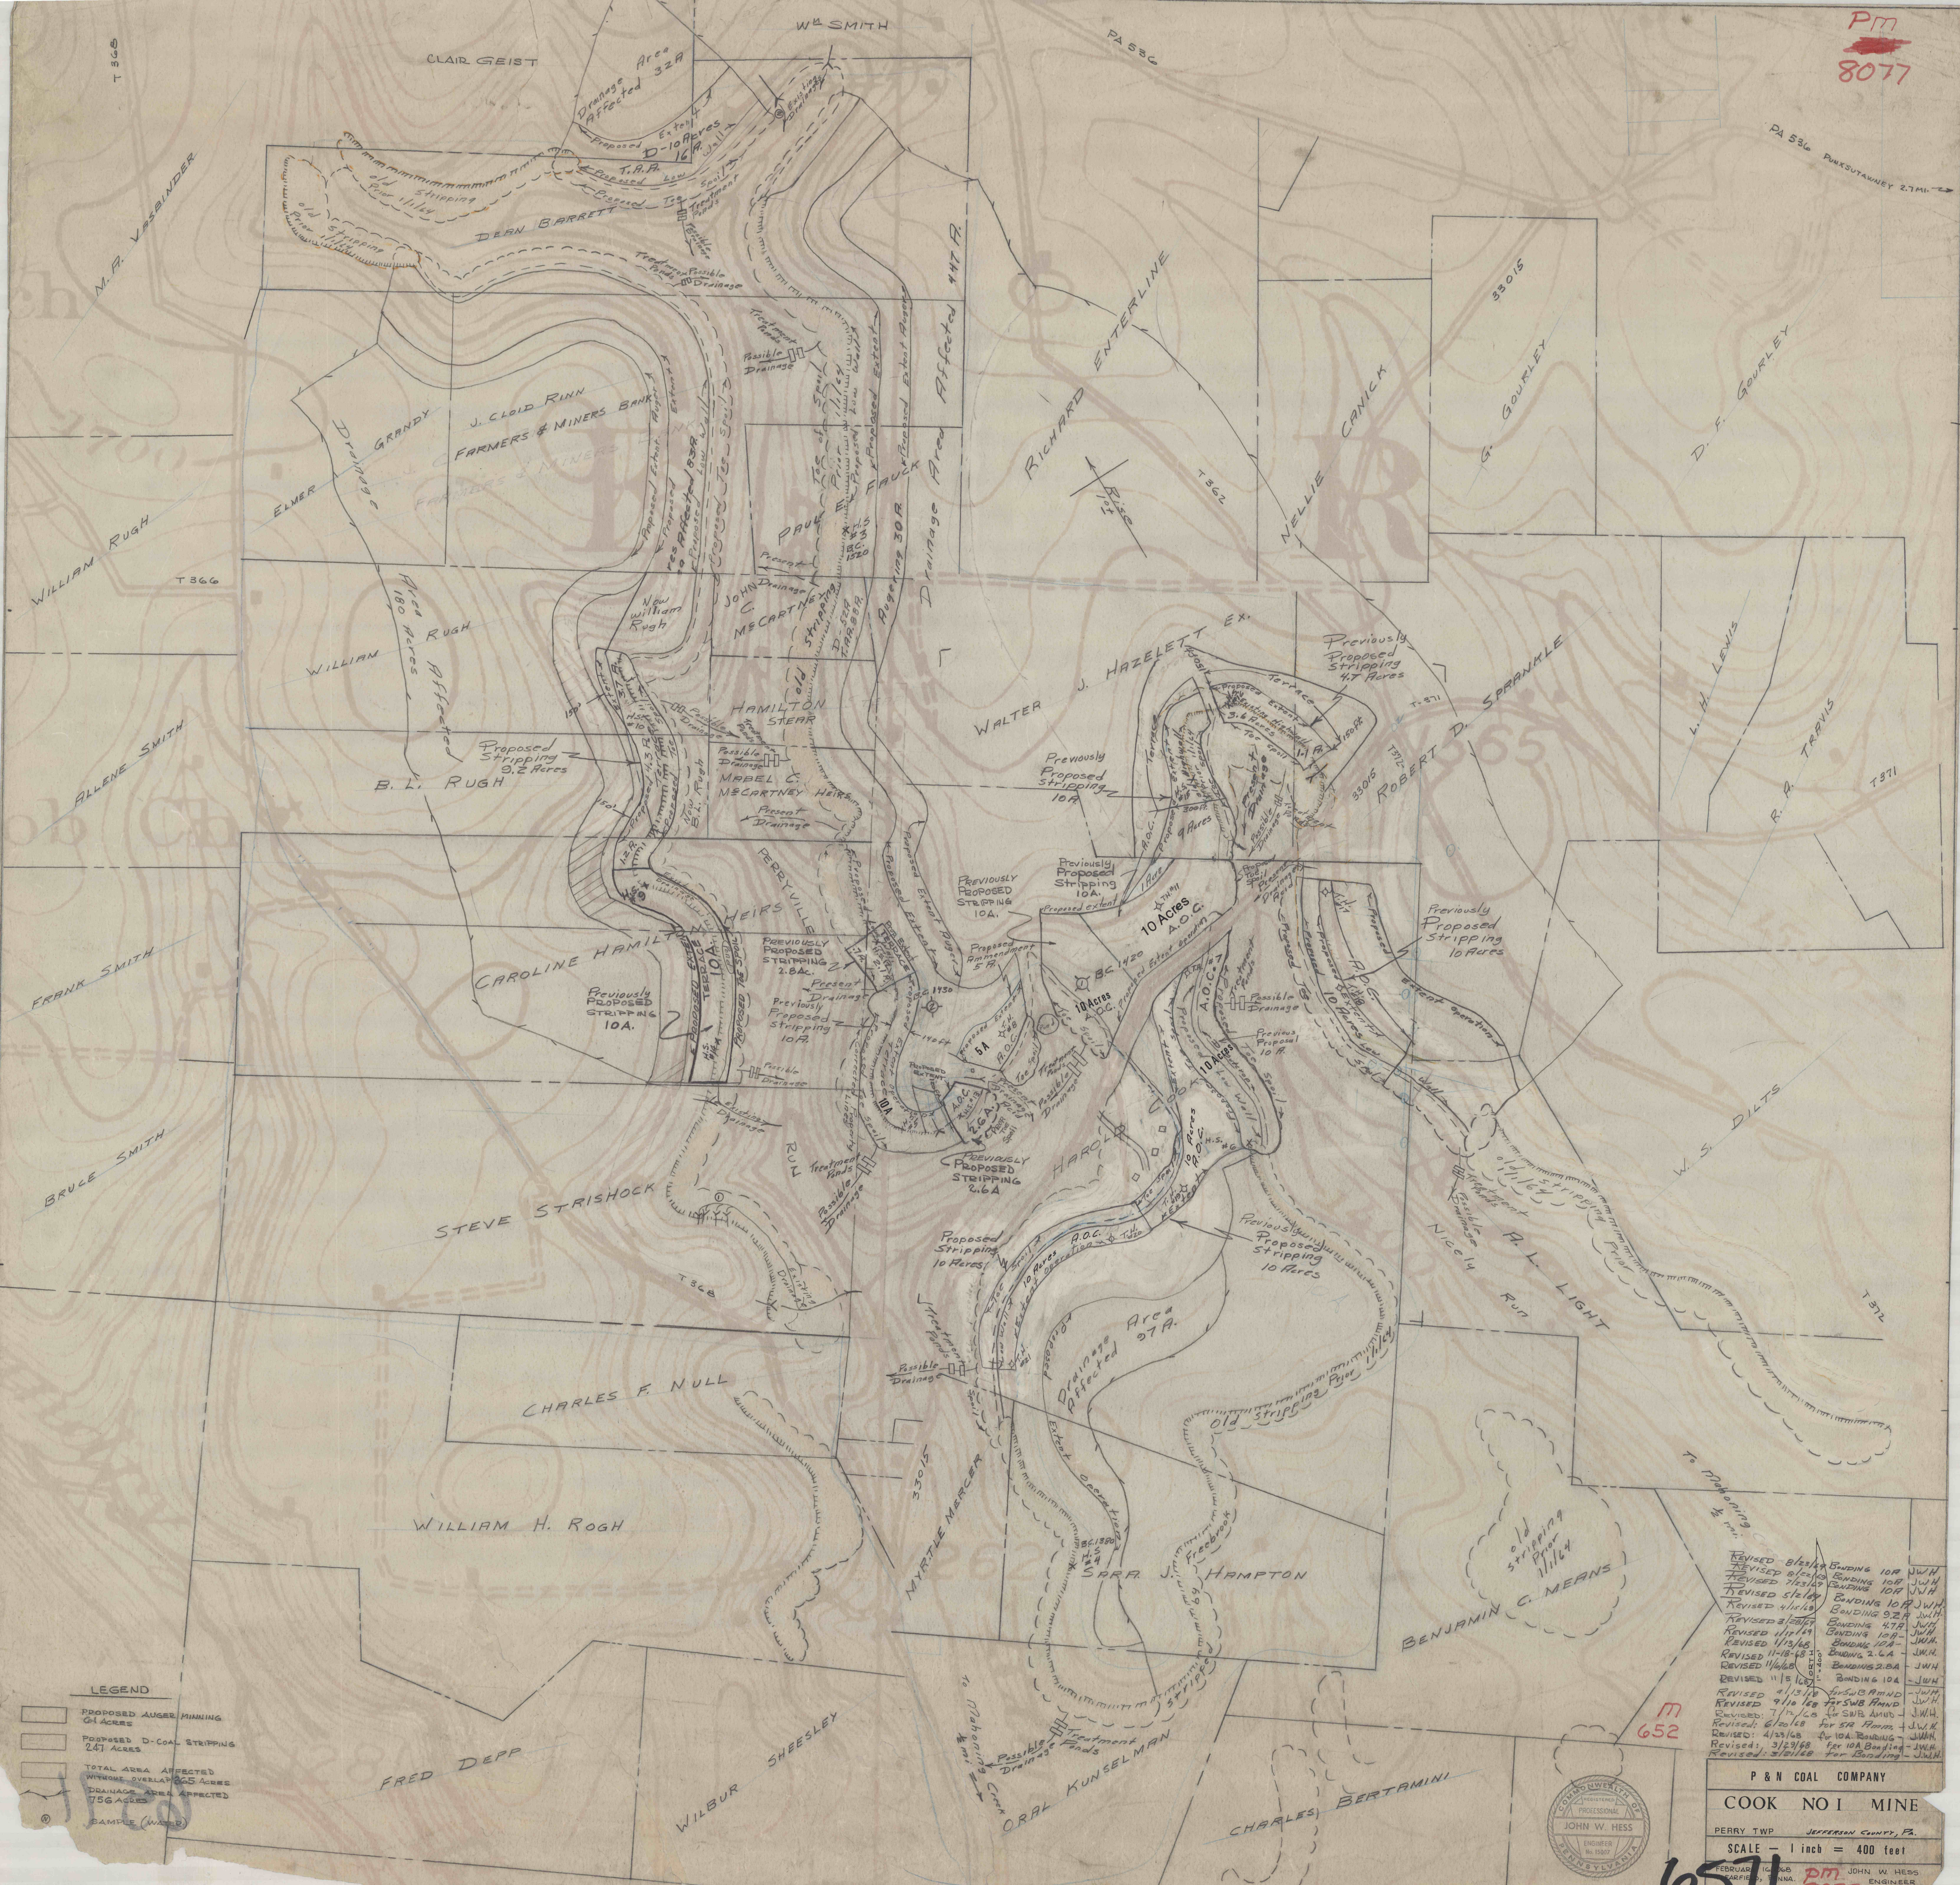
Pm 8077
CLAIR GEIST
Wm SMITH
PA 536
PA 536 PUNXSUTAWNEY 2.7 MI.
T 368
M. A. VASBINDER
Drainage Area Affected 32A
Proposed Extent
D-10 Acres 16 A.
T.A.A.
Proposed Low Wall
Proposed Toe Spoil
Treatment Ponds
Possible Drainage
Existing Drainage
old stripping Prior 1/1/64
DEAN BARRETT
J. CLOID RINN
FARMERS & MINERS BANK
ELMER GRANDY
Drainage Area 180 Acres Affected
WILLIAM RUGH
T 366
Now william Rugh
Proposed Extent Auger
Proposed Extent
Acres Affected 83A
Proposed Low Wall
Proposed Toe Spoil
PAUL E. FAUCK
H.S. #3 B.C. 1520
Present Drainage
JOHN C. McCARTNEY
old stripping
D-52A T.A.A. 88A
Augering 30 A.
Drainage Area Affected 447 A.
RICHARD ENTERLINE
Rise 1 to 1
T 362
NELLIE CANICK
33015
G. GOURLEY
D. F. GOURLEY
ALLENE SMITH
Proposed Stripping 9.2 Acres
B. L. RUGH
HAMILTON STEAR
MABEL C. McCARTNEY HEIRS
Now B.L. Rugh
WALTER J. HAZELETT EX.
Previously Proposed Stripping 10 A.
Previously Proposed Stripping 4.7 Acres
Terrace
Proposed Extent
Existing Highwall
3.6 Acres
Toe Spoil
1.1 A.
150 ft.
T-371
T372
ROBERT D. SPRANKLE
L. H. LEWIS
R. A. TRAVIS
T371
FRANK SMITH
CAROLINE HAMILTON HEIRS
PERRYVILLE
Previously Proposed Stripping 10A.
PROPOSED EXTENT TERRACE 10A.
PROPOSED TOE SPOIL
H.S. #14
PREVIOUSLY PROPOSED STRIPPING 2.8Ac.
Previously Proposed Stripping 10 A.
B.C. 1430
Proposed Ammendment 5 A.
10 Acres A.O.C.
B.C. 1420
Proposed Extent Operation
5A A.O.C.
2.6A.
PREVIOUSLY PROPOSED STRIPPING 2.6A
A.O.C. #7
Previous Proposal 10 A.
Previously Proposed Stripping 10 Acres
Extent Operation
HAROLD COOK
H.S. #6
Proposed Stripping 10 Acres
BRUCE SMITH
STEVE STRISHOCK
RUN
T 368
Drainage Affected Area 97 A.
Old Stripping Prior 1/1/64
W. S. DILTS
A. L. LIGHT
Nicely Run
T 372
CHARLES F. NULL
33015
MYRTLE MERCER
B.C. 1380 H.S. #4
SARA J. HAMPTON
Freebrook
WILLIAM H. ROGH
To Mahoning Creek 1/2 mi.
To Mahoning 1/2 mi.
old stripping Prior 1/1/64
BENJAMIN C. MEANS
FRED DEPP
WILBUR SHEESLEY
ORAL KUNSELMAN
CHARLES BERTAMINI
LEGEND
PROPOSED AUGER MINNING 61 ACRES
PROPOSED D-COAL STRIPPING 247 ACRES
TOTAL AREA AFFECTED WITHOUT OVERLAP 365 ACRES
DRAINAGE AREA AFFECTED 756 ACRES
SAMPLE (WATER)
Revised 8/23/69 Bonding 10A JWH
Revised 8/22/69 Bonding 10A JWH
Revised 7/23/69 Bonding 10A JWH
Revised 5/2/69 Bonding 10A JWH
Revised 4/15/69 Bonding 9.2A JWH
Revised 3/28/69 Bonding 4.7A JWH
Revised 1/17/69 Bonding 10A JWH
Revised 1/13/68 Bonding 10A J.W.H.
Revised 11-18-68 Bonding 2.6A J.W.H.
Revised 11/6/68 Bonding 2.8A JWH
Revised 11/5/68 Bonding 10A JWH
Revised 9/13/68 for SWB AMND J.W.H.
Revised 9/10/68 for SWB AMND J.W.H.
Revised: 7/12/68 for SWB AMND J.W.H.
Revised: 6/20/68 for 5A Amm. J.W.H.
Revised: 4/23/68 for 10A Bonding J.W.H.
Revised: 3/29/68 for 10A Bonding J.W.H.
Revised: 3/21/68 for Bonding J.W.H.
NORTH 1" = 400'
M 652
P & N COAL COMPANY
COOK NO I MINE
PERRY TWP JEFFERSON COUNTY, PA.
SCALE — 1 inch = 400 feet
FEBRUARY 16, 1968 CLEARFIELD, PENNA.
JOHN W. HESS ENGINEER
COMMONWEALTH OF PENNSYLVANIA REGISTERED PROFESSIONAL JOHN W. HESS ENGINEER No. 15007
6571