

D




A. E. WOOLRIDGE  
WOOLRIDGE CANNEL COAL CO.  
MAP OF COAL LANDS

IN  
BRADFORD TWP. CLEARFIELD CO., PA.  
NOV. 18, 1919

SCALE 1" = 400'

OFFICE OF E. W. HESS  
ENGINEER

CGO

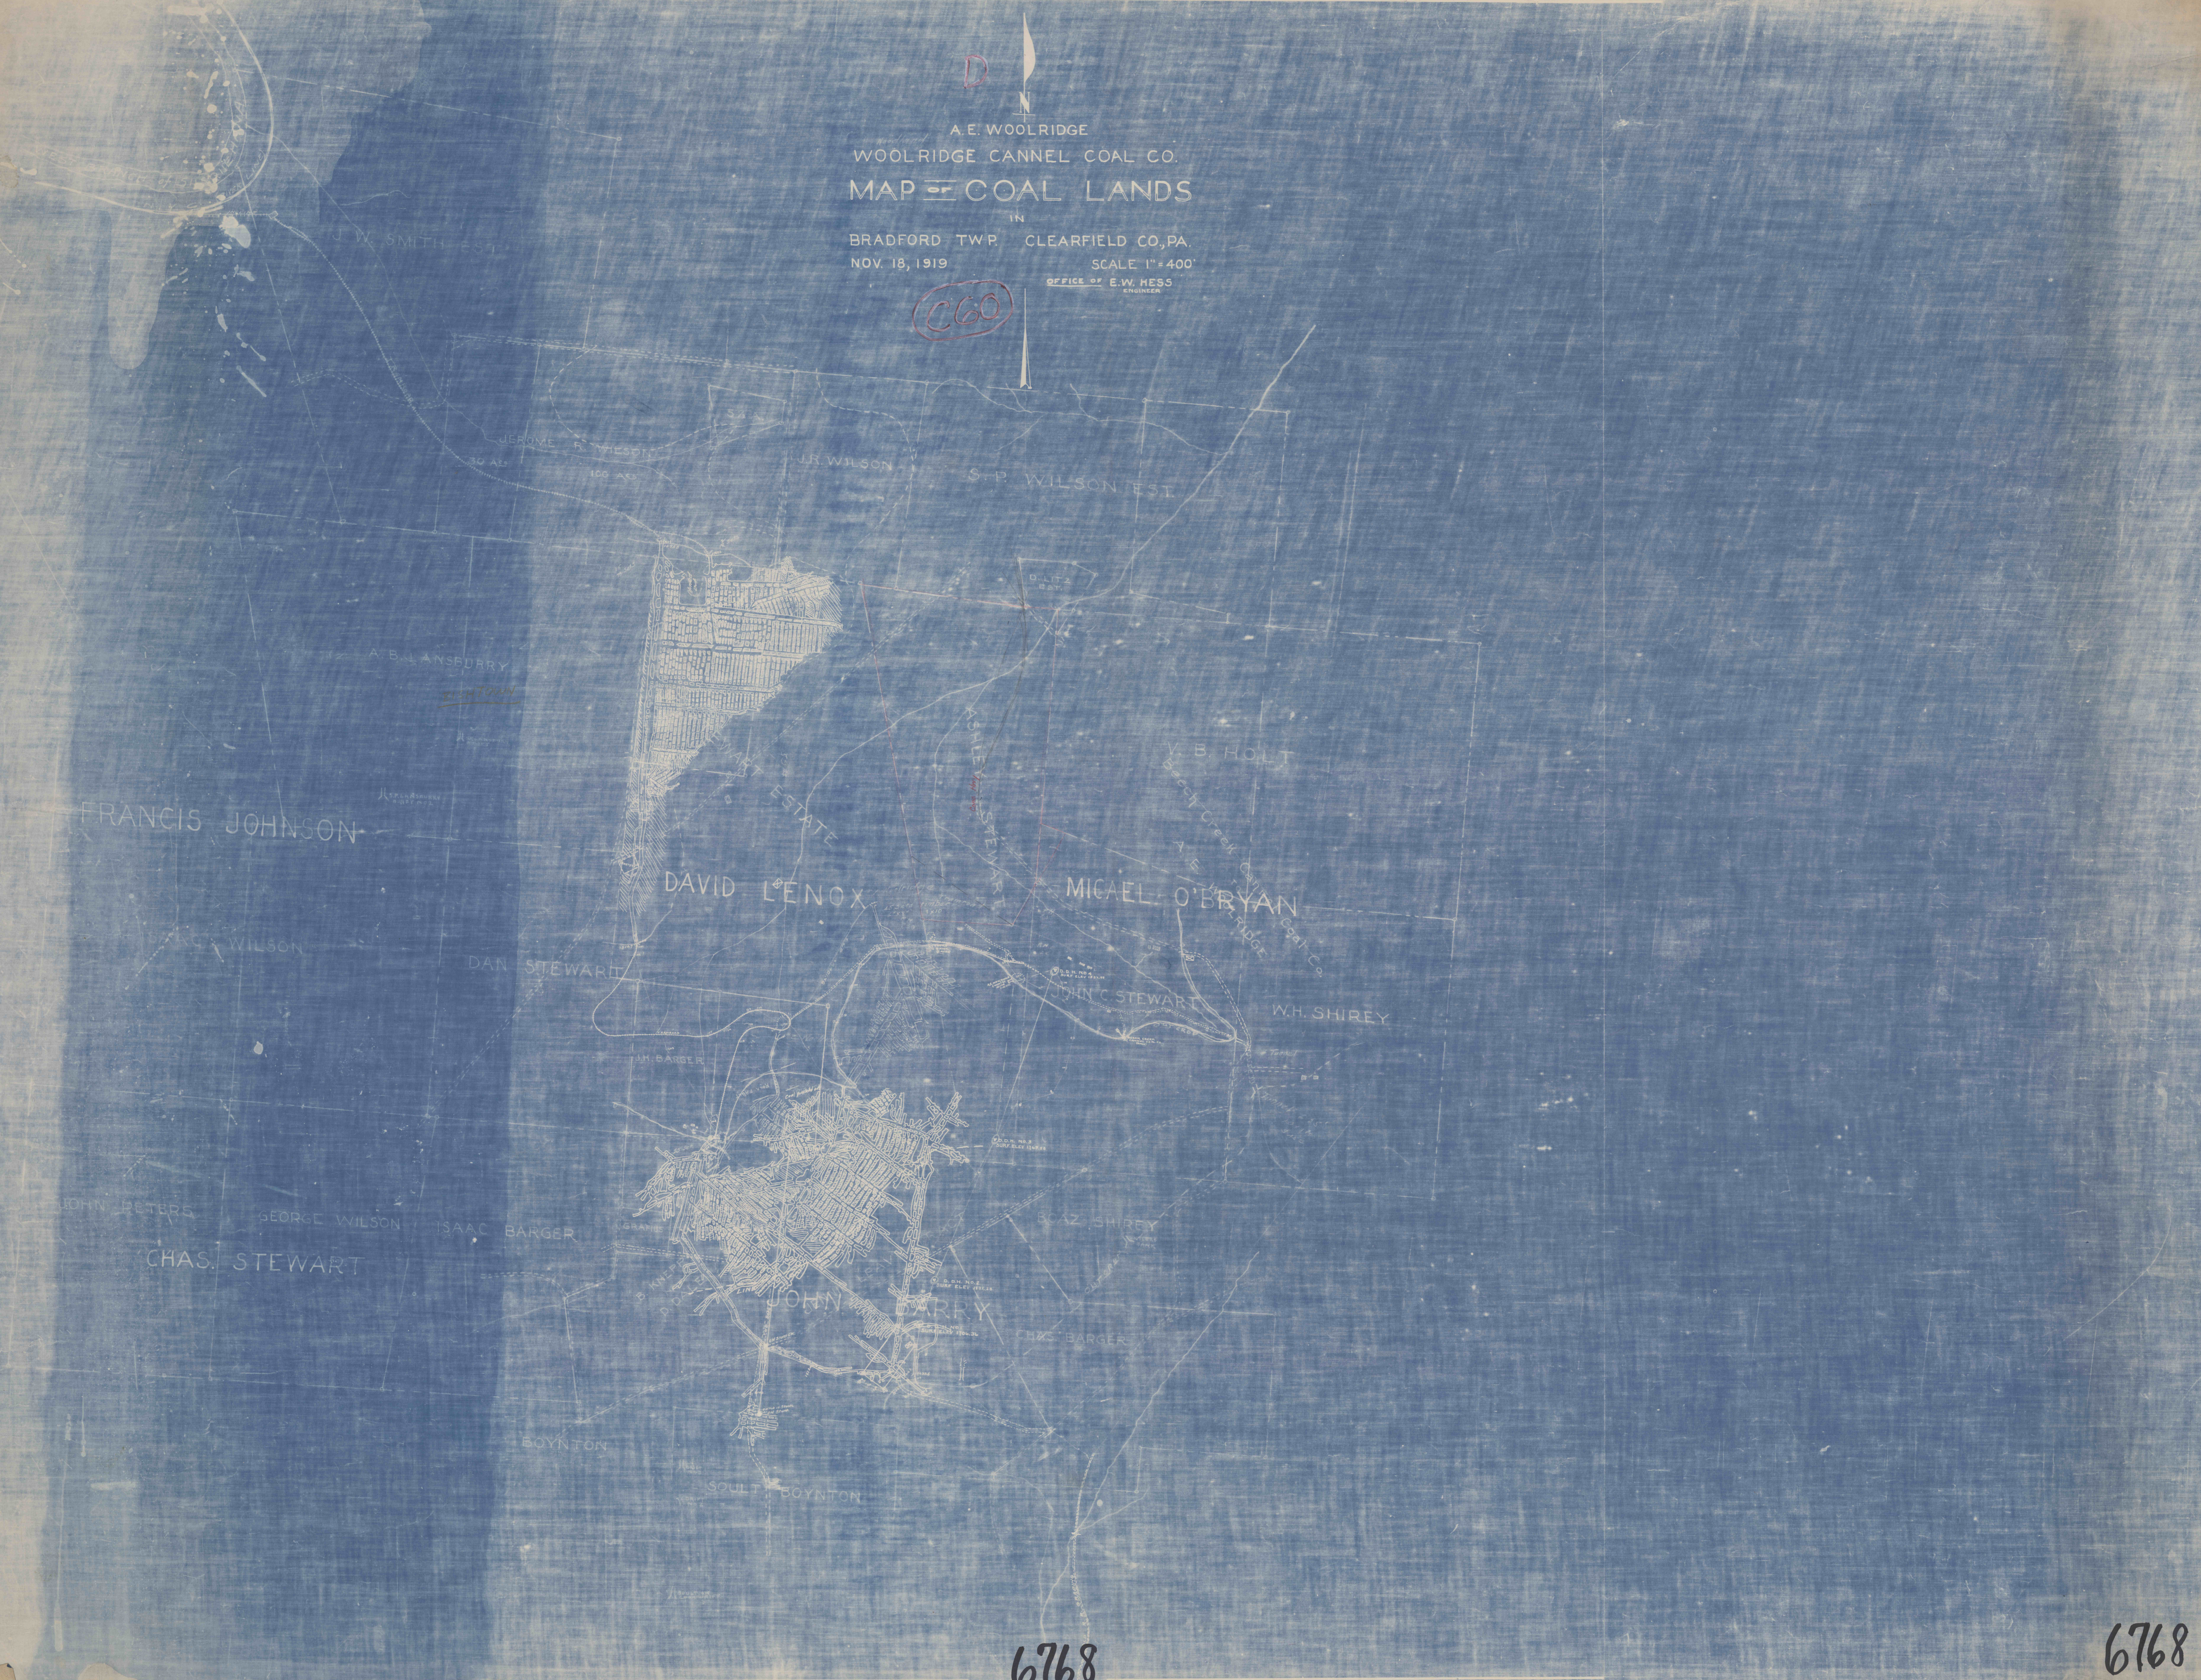

6768

6768