


LOYAL HANNA
COAL AND COKE CO.
PA.

MAP OF LANDS OF THE LOYAL HANNA COAL AND COKE CO.

LOCATED AT
ONNALINDA, CAMBRIA CO., PA.

SCALE: 1"=400'

Civil and Mining Engineers,
ALTOONA, PA.

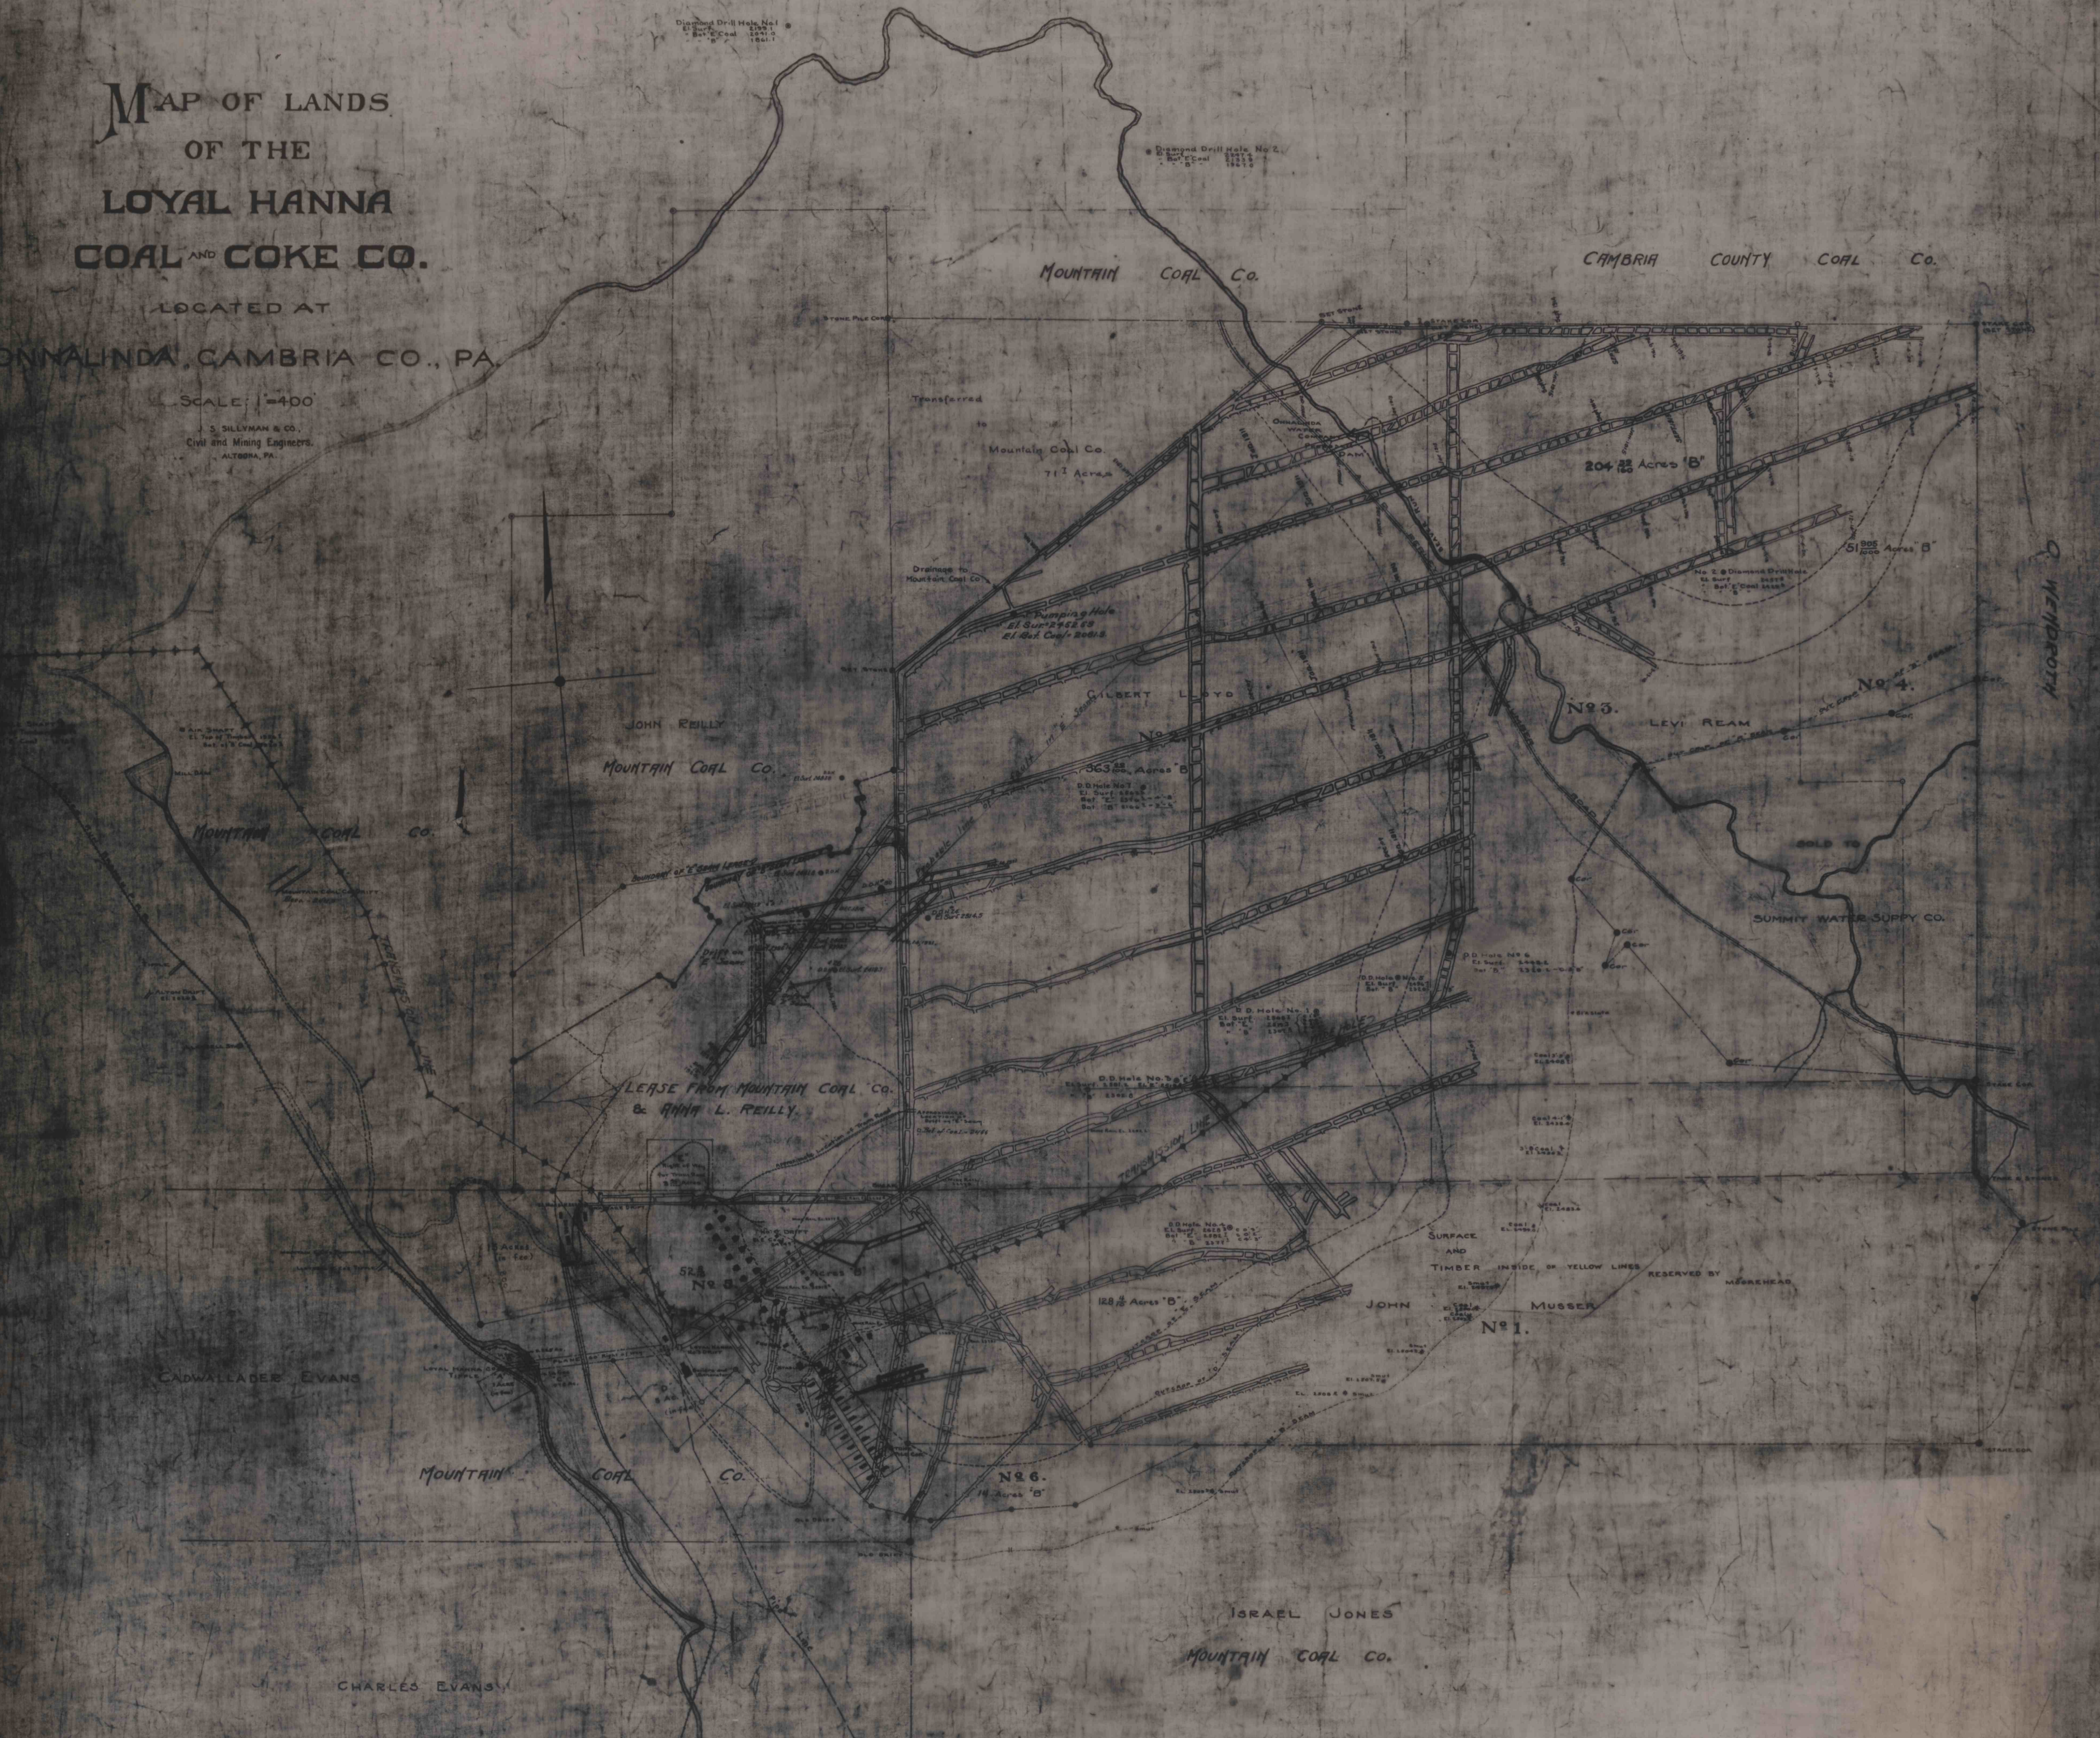

MOUNTAIN COAL Co.

CAMBRIA COUNTY COAL Co.

JOHN REILLY
MOUNTAIN COAL Co.

GILBERT LLOYD
No. 3
363.25 Acres B

No. 5
LEVI REAM

LEASE FROM MOUNTAIN COAL Co.
& ANNA L. REILLY

JOHN MUSSEY
No. 1

MOUNTAIN COAL Co.

No. 6
18.25 Acres B

ISRAEL JONES
MOUNTAIN COAL Co.

CHARLES EVANS

CADWALLADER EVANS

