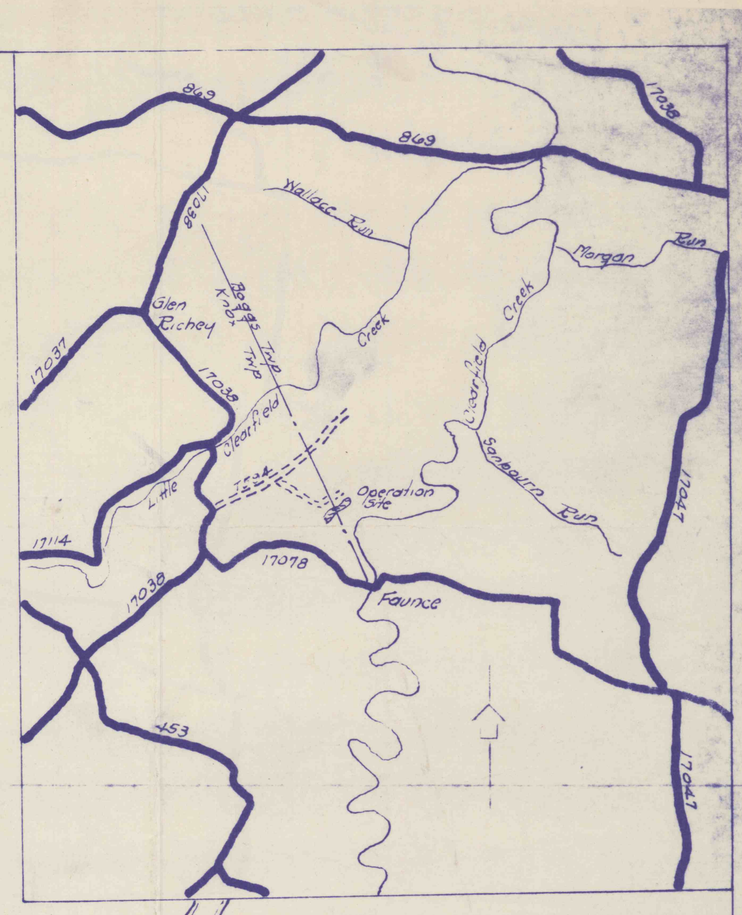

Ryan Bros.

A & L. Thompson

Kelly

Edward

Little Clearfield Creek

To L.R. 17038

T594

Test hole

James B. Graham Heirs
433A-153P.
(Isabelle Jordan Wt.)

Knox Boggs Twp.

Old Stripping

John M. Chase Estate
And
Smith Coal Company

Area Of Application - After 6/1/67
New Terrace
Existing Highwall
Prior To 6/1/67
Old Terrace
NO!
after 6-7-67
was not under
original Permit

C' Outcrop

DELETE FROM PERMIT 0.70 A.

Drainage Ditch

Proposed Highwall

Highwall Meas

Drainage Area Affected 53.30 Acres

3.05 A.

Existing Stripping

6.80 Acres

6.94 Acres

Outer Toe Of Spoil

19.30 A.
3-8-74

John M. Chase Jr. Heirs

John M. Chase Estate
&
Smith Coal Co.
440A ±

Nathaniel McDonald Wt.

PROPOSED AMENDED PERMIT PLUS 15% BOND

ORIGINAL PERMIT

HIGHWALL 10.00 A

T.S.A.

APPROX. 4

Old Stripping

Buck Run

Spoil

Rise 2% ±

John M. Chase Estate
Smith Coal Co.

NOTE:
OLD SPOILS BACKFILLED & WILL BE PLANTED BY ROY COAL COMPANY INC. 3.12 ACRES
3-8-74 BACKFILLED & LEVELED 19.30 ACRES
3-8-74 DELETE FROM PERMIT 0.70 ACRES

NOTE:
12-18-74 AMENDED PERMIT 10.00 ACRES PLUS 15% BOND
SP No 113-

Big Clearfield Creek

John M. Chase Sr. Heirs

Strip Mine Permit Plan
ROY COAL COMPANY INC.
Dimeling Operation
Knox And Boggs Twps. Clearfield Co.
March 12, 1968 Scale 1 in. = 400 ft.
Wm W. Yost P.P.E. Clearfield, Pa.
Bernard Lucas Assoc.

7701