
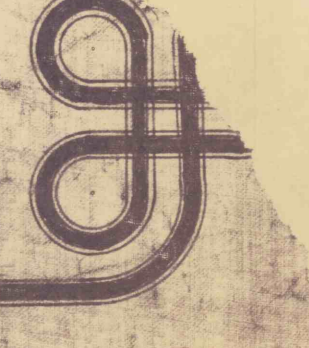


**M.A.P**  
 SHOWING  
 MINING OPERATIONS  
 OF THE  
**SOUTH FORK COAL MINING CO**  
 SOUTH FORK PA.

OCTOBER 25 1901  
 FINAL SURVEY - APRIL 5, 1901  
 S.G. FETTERMAN, C.E.  
 SCALE 400 FT. = 1 IN.

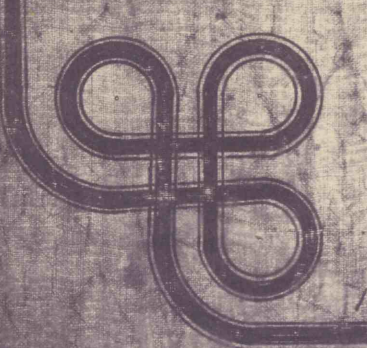

1976-J-119

7827