


817

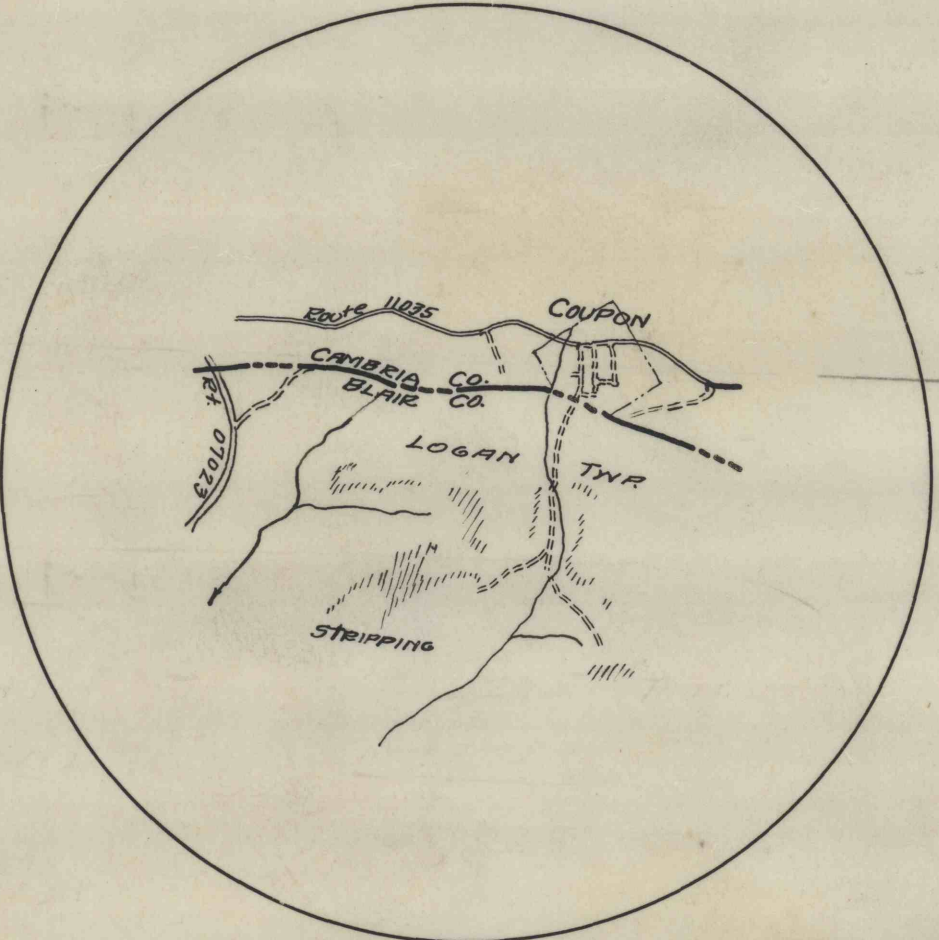

William Horner

1945 Act - Area Affected (Uncovered) - 60.85 Acres

1949 Act - Area Affected (Uncovered) - 24.50 Acres
Disturbed - 0.48 - 24.98 Acres

CAVALIER COAL CO.
COUPON, PA.

Map of
COAL STRIPPINGS
in Logan Twp, Blair Co, Pa.
SCALE - 1 in. = 400 ft.
Clearfield, Pa. Engineering Office
June 4, 1982. Vest, Bramfield & Hesse

1343A

817