

North
1"=400'


Altoona Coal & Coke Co.

Glen White Coal & Lumber Co.

Altoona Coal & Coke Co.

AREA AFFECTED
UPPER A Seam
7.46 Acres

AREA AFFECTED
UPPER A Seam
32.90 Acres

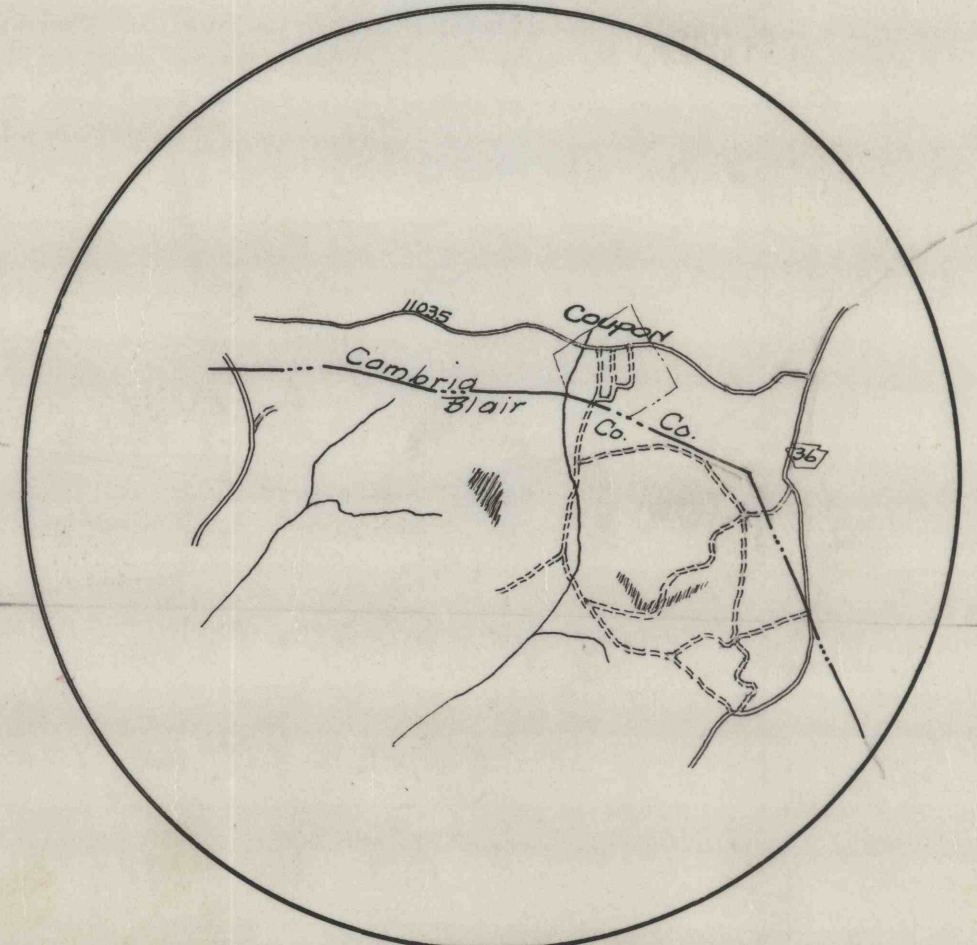

William Herner

CAVALIER COAL CO. INC.
COUPON, PA.

Map of
COAL STRIPPINGS
in Logan Twp., Blair Co., Pa.
SCALE - 1 in. = 400 ft.
Clearfield, Pa. Engineering Office
July 22, 1932. Met. Drafting & Heat.

1343A
27a-53
1343A