

Beaver Run Land
Nichols map
1" = 400'

STONE
POST & STONES

STONE

S 27°-30' E
1507'




SCALE 1" = 400'

U.S.A.
2538-3352
2555-62
2555-62
2555-62
2555-62

JNO.

BEAVER RUN LAND CO. Formerly

NICHOLS

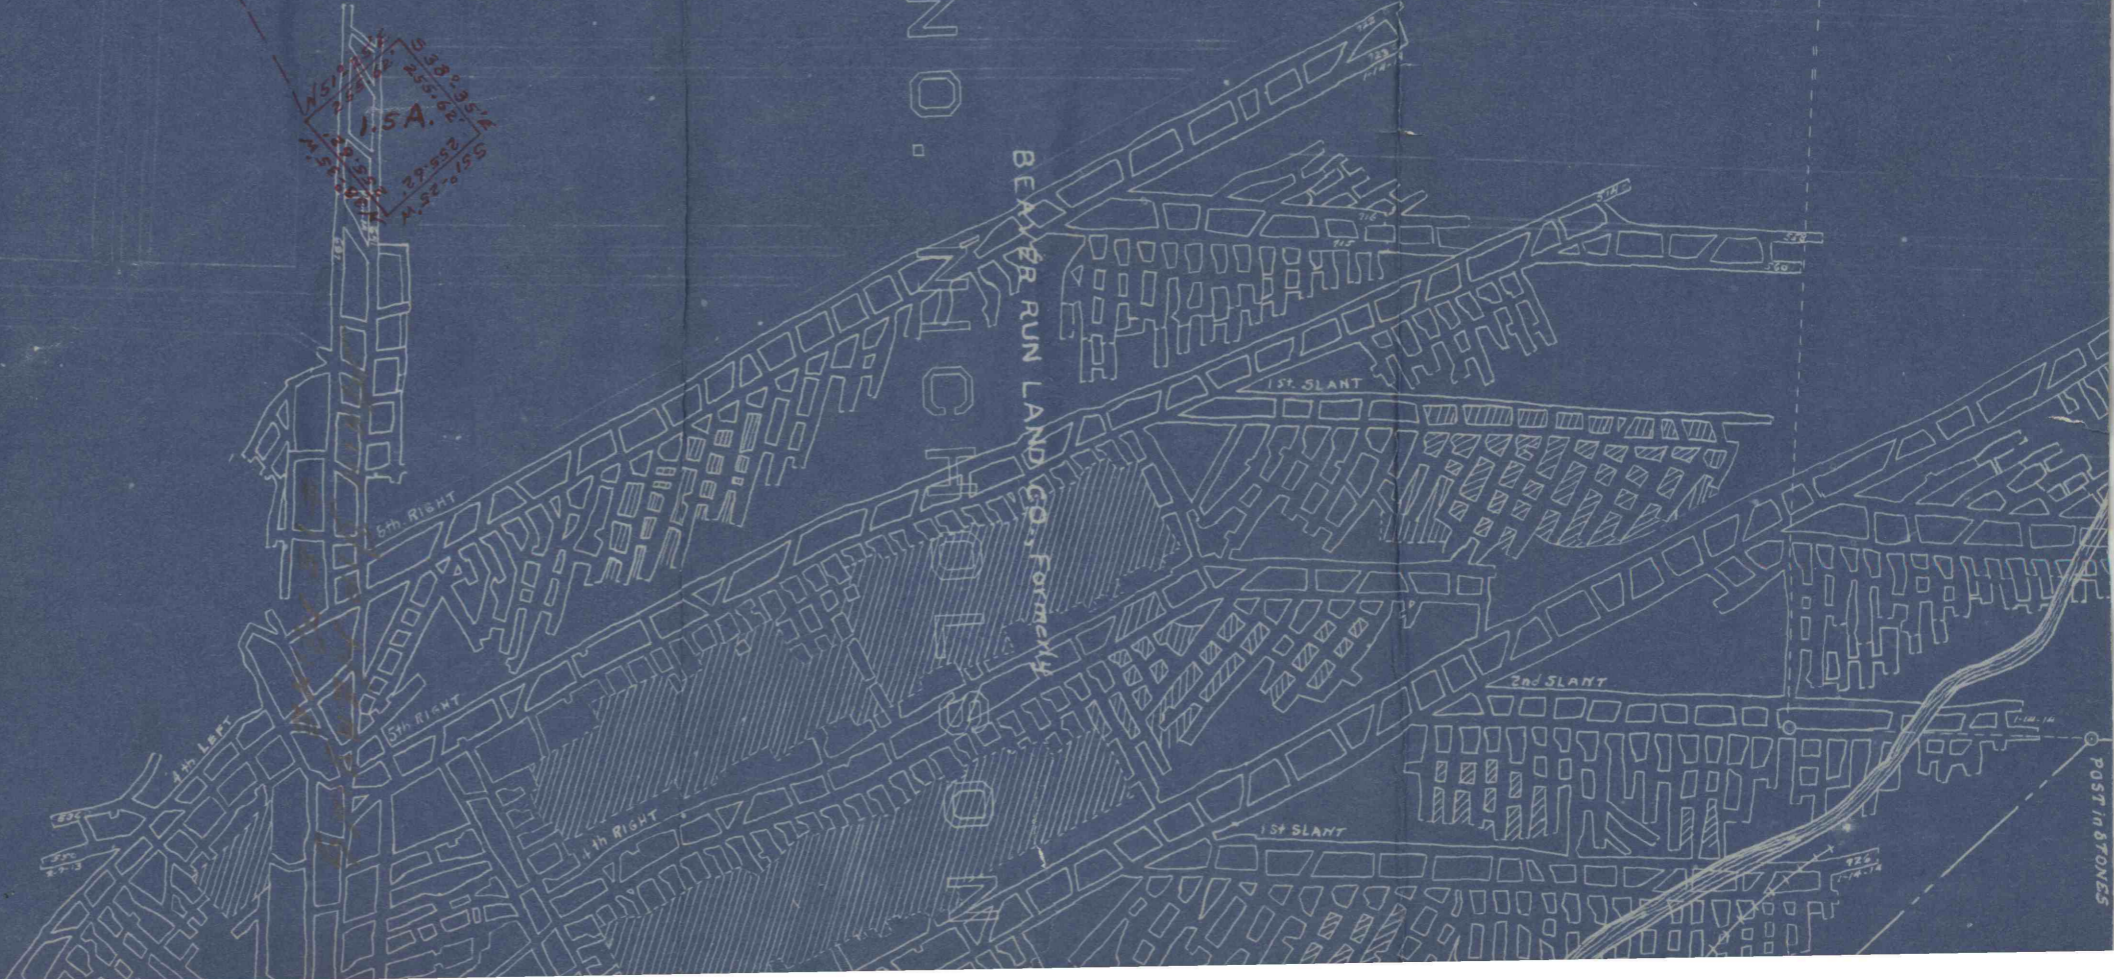

POST IN STONES