


8278
8278

8278
D

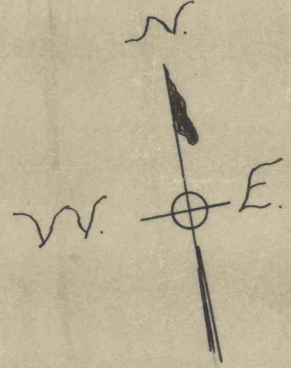

D
8278

MAP SHOWING SURVEY OF COAL MINE
ON THE
JAS. MOORE ESTATE


OPERATED BY
RICHARD FULTON AND W. LITTEN

SCALE 1" = 40'

CLEARFIELD, PA.
DEC. 27, 1913

ENGINEER
OFFICE OF E. J. HESS
525 N. 5th St. Clearfield, Pa.

8669
8278

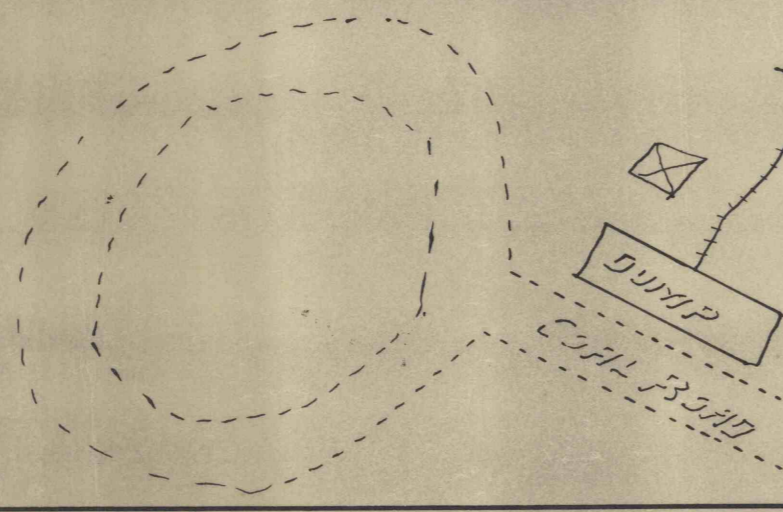

JAS. MOORE EST.

RICHARD DUCKETT

"BISHOP'S CATHOLIC CEMETERY"

JAS. LEAHY EST.

SIGHTS N18°50' E

SIGHTS 107'

SIGHTS 132 FT.

107'

N18°50' E
COAL ROAD

REF.