




1000' - SONMAN "B"	P-5-259
1000' - SONMAN "E"	P-5-258
500' - SONMAN "E"	L-5-262
REFERENCES	DWG. NO.

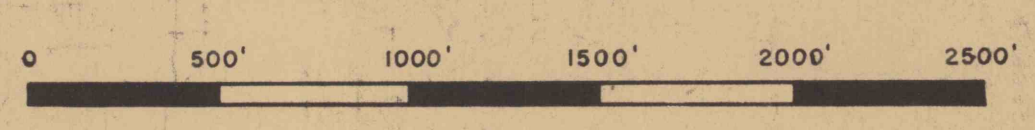

POSTED TO 7-28-49
FINAL POSTING

DRAWN BY	NAME	DATE
	E. E. BRACKEN	4-17-46
REVISED		

EASTERN GAS & FUEL ASSOCIATES
COAL DIVISION
PITTSBURGH, PA.

SONMAN "B" SHAFT MINE
PROJECTION IN "B" OR
LOWER KITTANNING SEAM.

SCALE 1" = 500'
DATE 4-17-46
L-5-261
SHEET 1 OF 2 SHEETS

#265