


KIEL-RUSSELL ESTATE SHOWING
E-SEAM WORKINGS

SCALE 1" = 500'

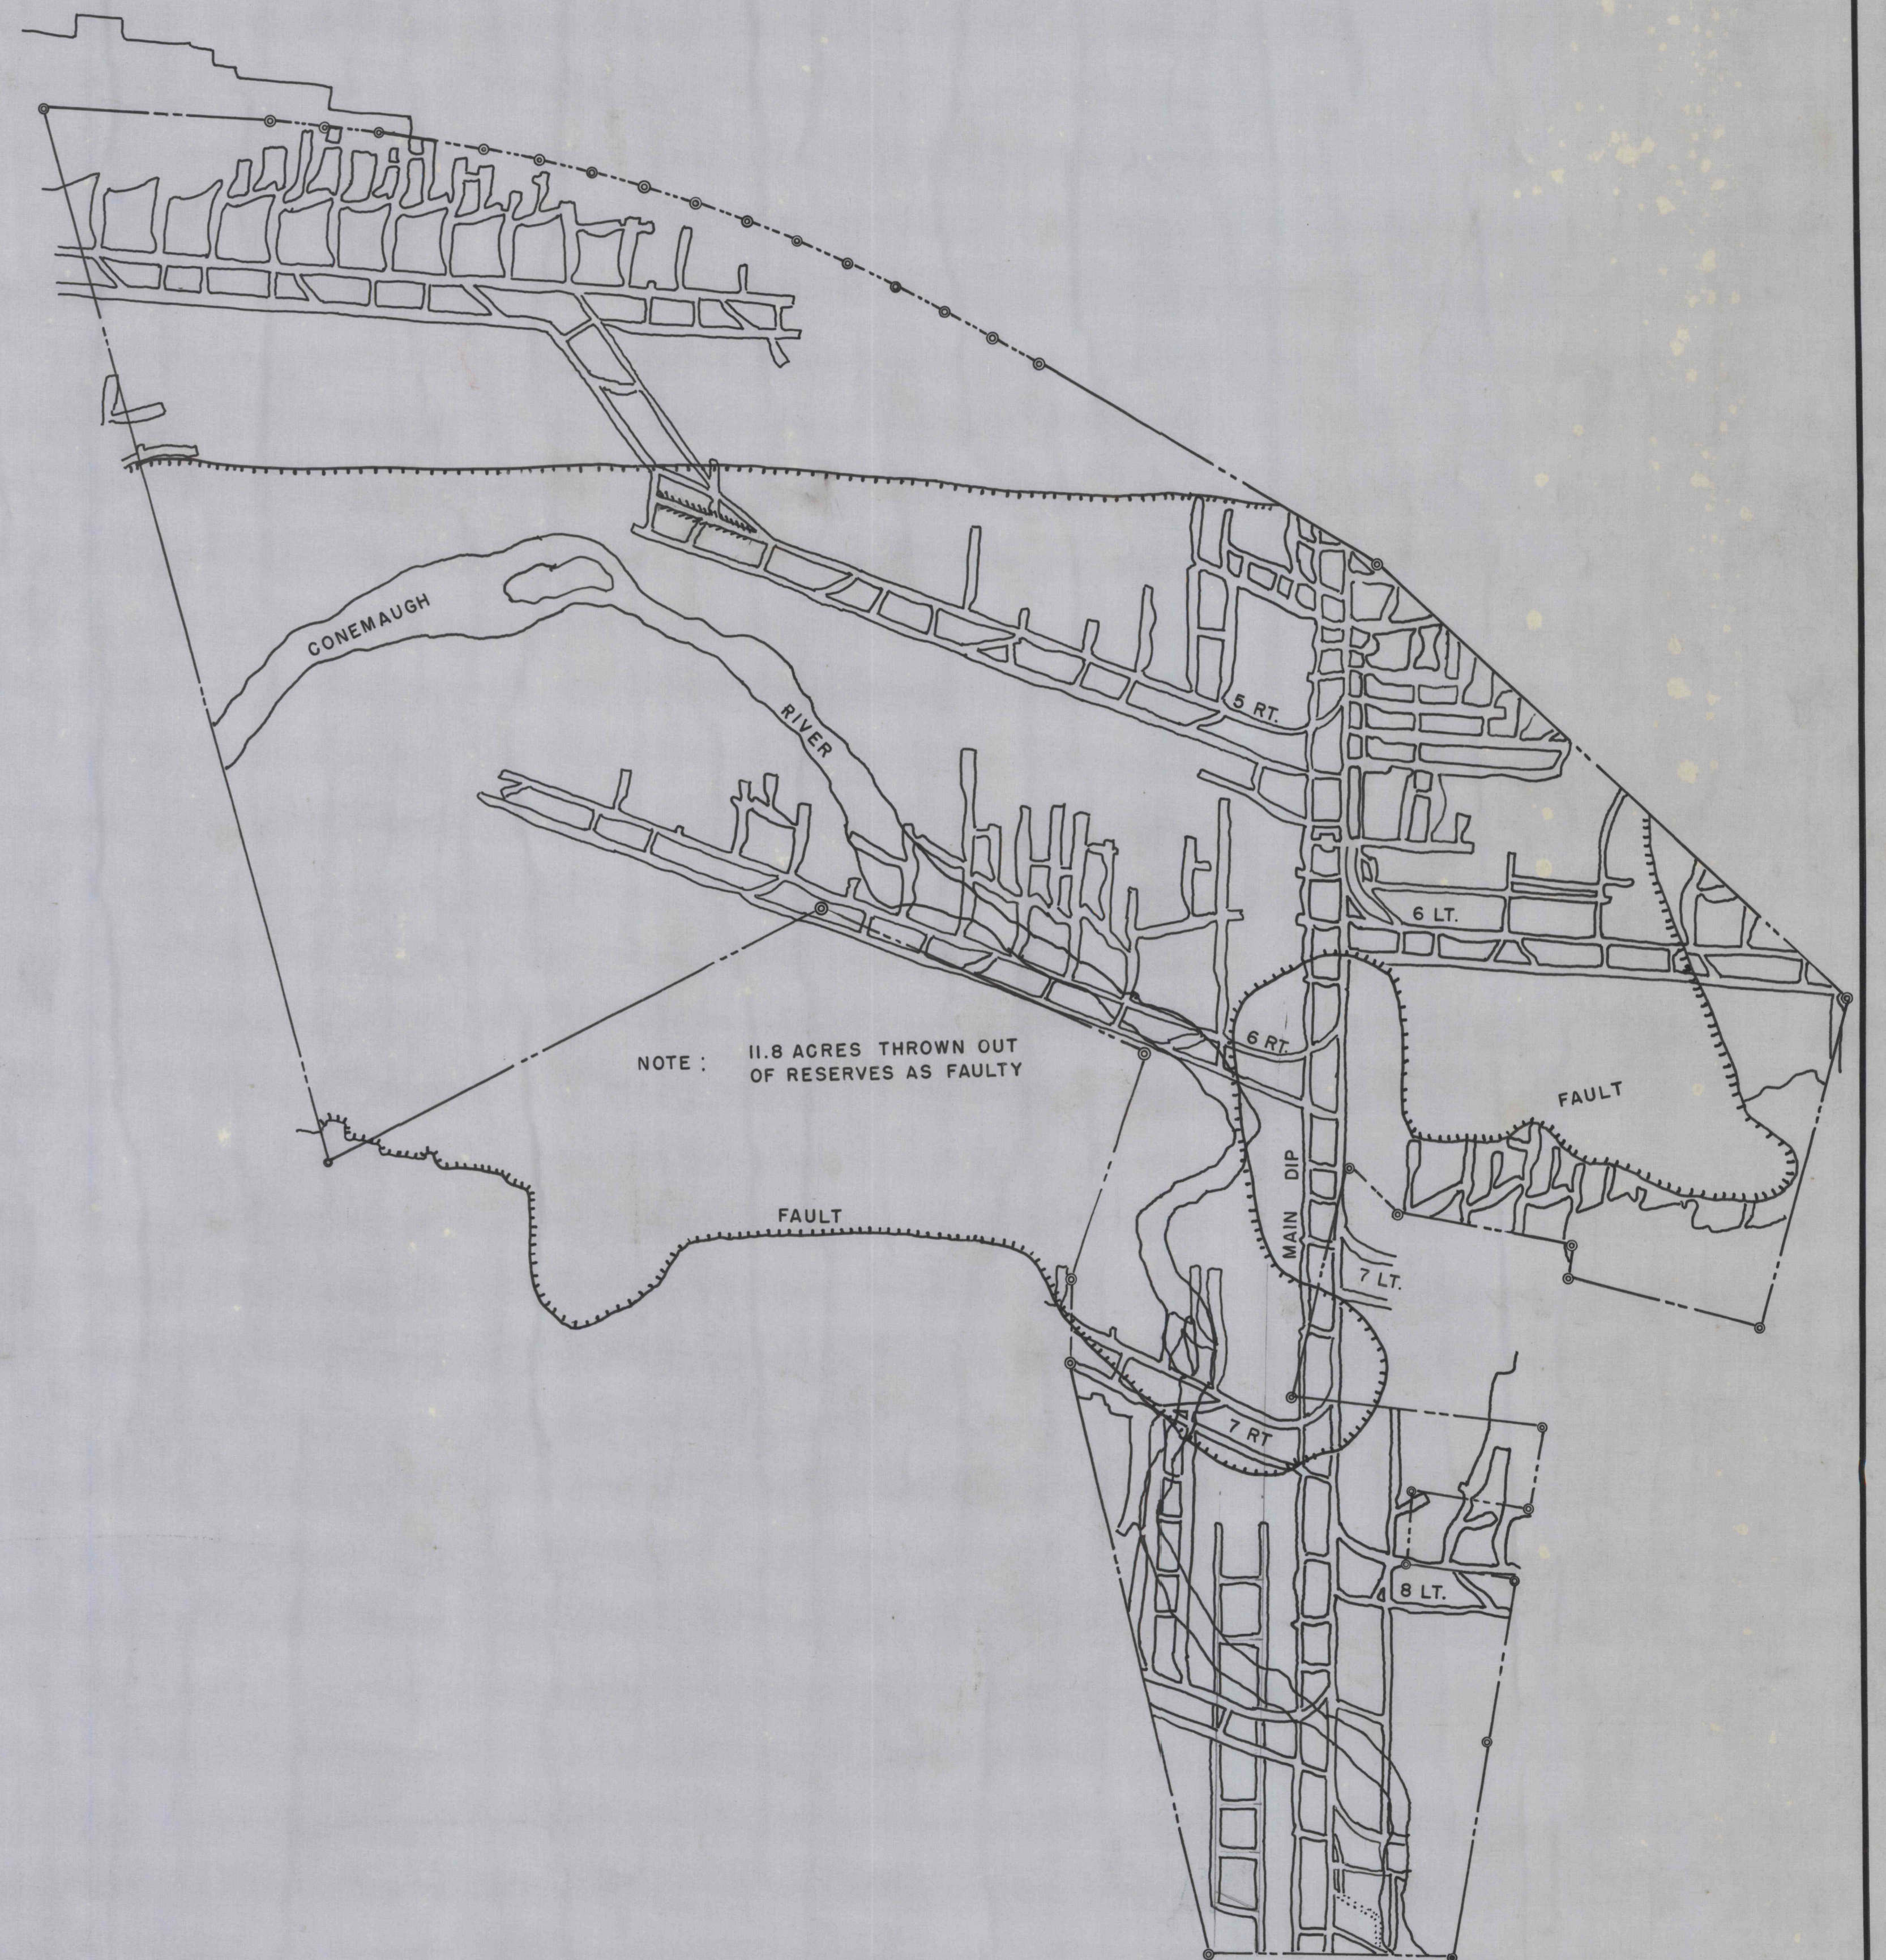

KIEL-RUSSELL ESTATE SHOWING
B-SEAM WORKINGS

SCALE 1" = 200'

DR. THOMAS M. RICHARDS
1/5 INTEREST OF
100.99 ACRES

SEAM	NO. ACRES	COAL HT.	EXPECTED RECOVERY	TONS
"E"	2.00	42"	60%	7,432
C'	20.20	40"	60%	71,492
D	20.20	48"	60%	85,730
B	5.89	42"	60%	21,889

10 CENTS PER GROSS TON

REFERENCES	DWG. NO.	REV.	DESCRIPTION	CHECKED BY	DATE	DRAWN BY	NAME	DATE	EASTERN GAS AND FUEL ASSOCIATES COAL DIVISION PITTSBURGH, PA.	SONMAN, PA. KIEL-RUSSELL ESTATE 100.99 ACRES	SCALE 1" = 200'-500'	B. M. NO. 50 W 122
------------	----------	------	-------------	------------	------	----------	------	------	---	--	----------------------	-----------------------

Eastern Gas and Fuel Associates
Kiel-Russell Estate
100.99 Acres
1" = 200'-500'