

MOSHANNON MINE

B 7"
C 2 1/2"
C 11"


B 4"
C 3 1/2"
C 11"

S.E.L. 1781
COAL 1422'
C. A. HUGHES CO.
POWER S.H.
E-SEAM

C. A. HUGHES CO.
WATER S.H.
E-SEAM

| REFERENCES | DWG. NO. |
|------------|----------|
| | |
| | |
| | |

| REV. | |
|------|--|
| | |
| | |
| | |

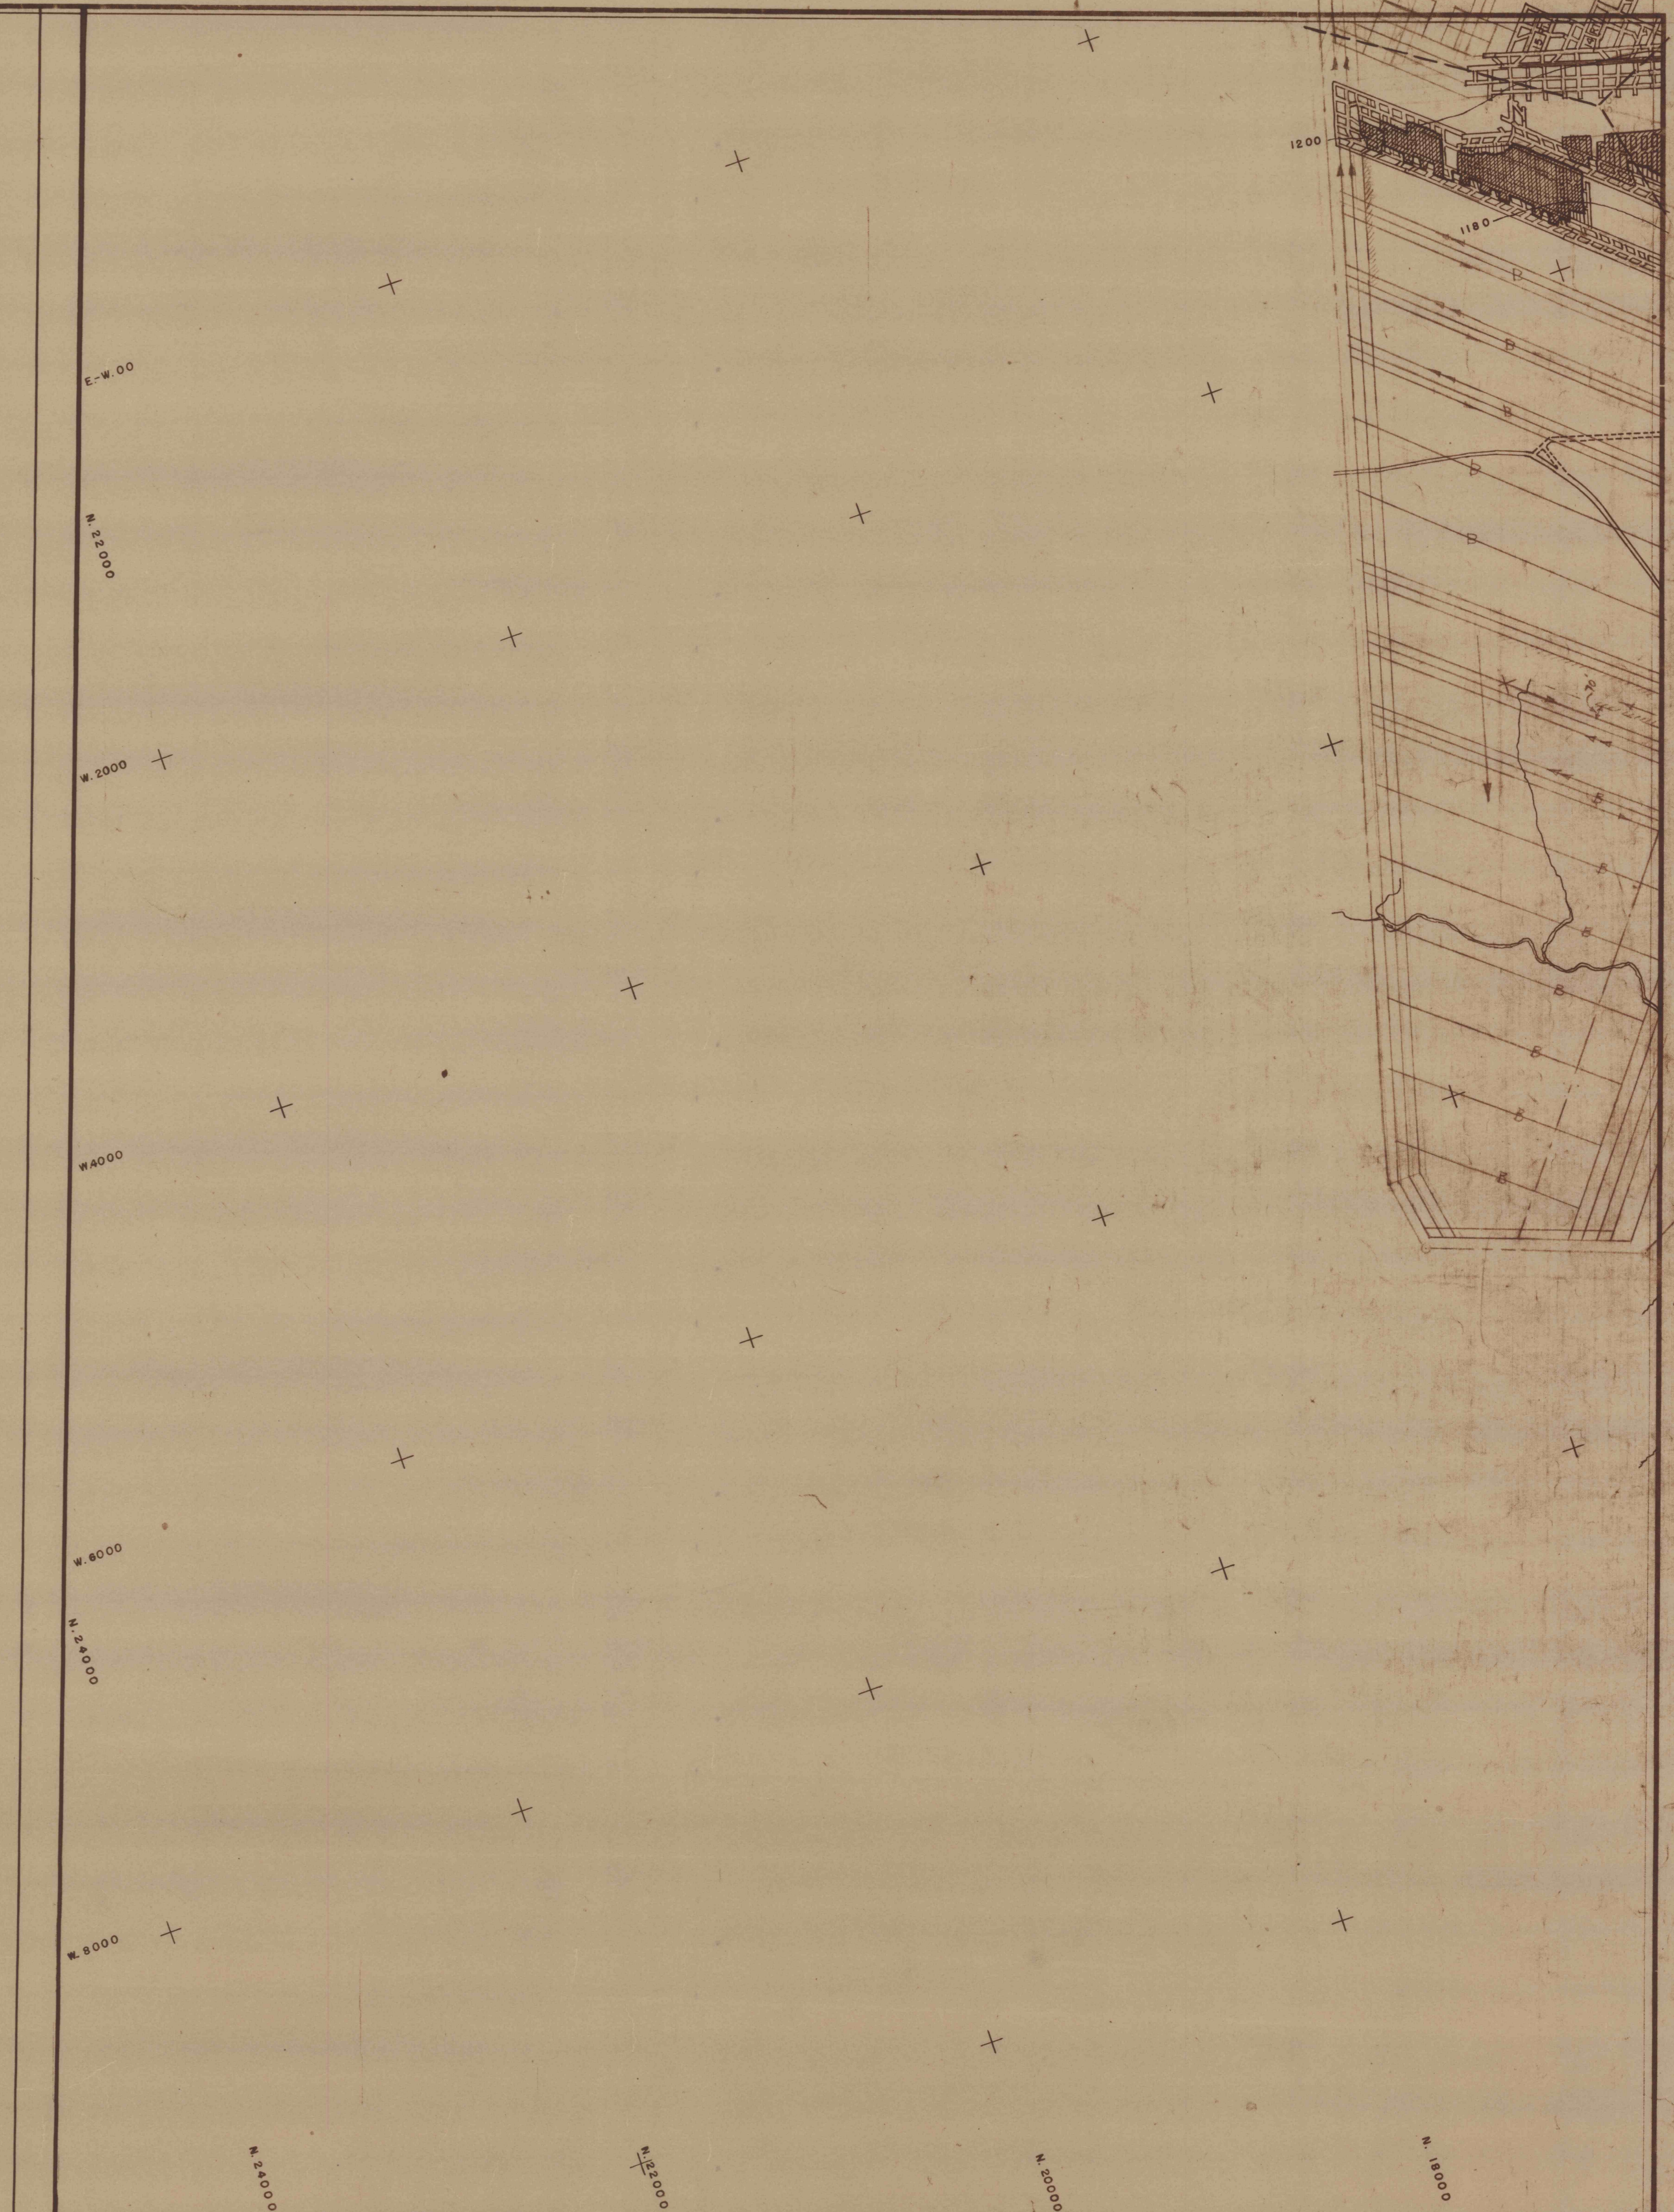

| CHECKED BY | DATE | APPROVED |
|------------|------|----------|
| | | |
| | | |
| | | |

EASTERN GAS AND FUEL ASSOCIATES
COAL DIVISION
PITTSBURGH, PA.

SONNAN SLOPE MINE
PROJECTION IN "E"
OR UPPER FREEPORT SEAM

SCALE 1"=500'
B. M. NO.
L-5-262
SHEET NO. 3 OF 3 SHEETS