




MUNSTER TWP.
SUMMERHILL TWP.

PORTAGE TWP.
SUMMERHILL TWP.

NORTH BRANCH
CONEMAUGH RESERVOIR OF THE
MANUFACTURERS WATER SUPPLY CO.
(BETHLEHEM STEEL COMPANY)

10" POWER B.H. 832' DEEP
LYNCH SUBSTA. NO. 3
1-200 KW M.G.

CAMBRIA COUNTY

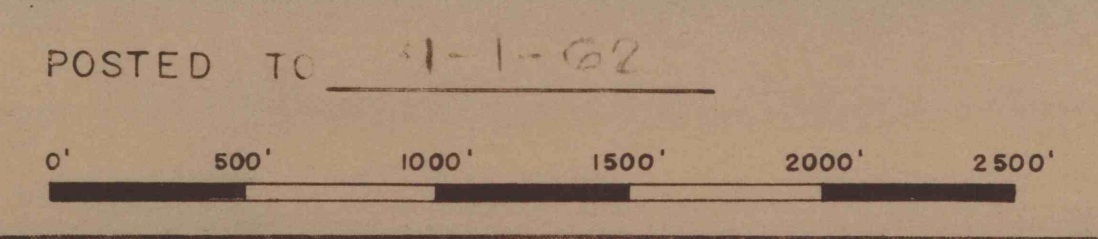

REV.	DESCRIPTION	CHECKED BY	DATE

NAME DATE
DRAWN BY E. E. BRAKEN 9-19-50
EASTERN GAS AND FUEL ASSOCIATES
COAL DIVISION
PITTSBURGH, PA.

SONNAN SLOPE MINE
PROJECTION IN "E"
OR UPPER FREEPORT SEAM

SCALE 1" = 600' B.M. NO.
L-5-262
SHEET NO. 1 OF 3 SHEET