


Especially
like tracing
on this

CAMBRIA MINING & MFG. CO.
COAL LESSOR AND SURFACE

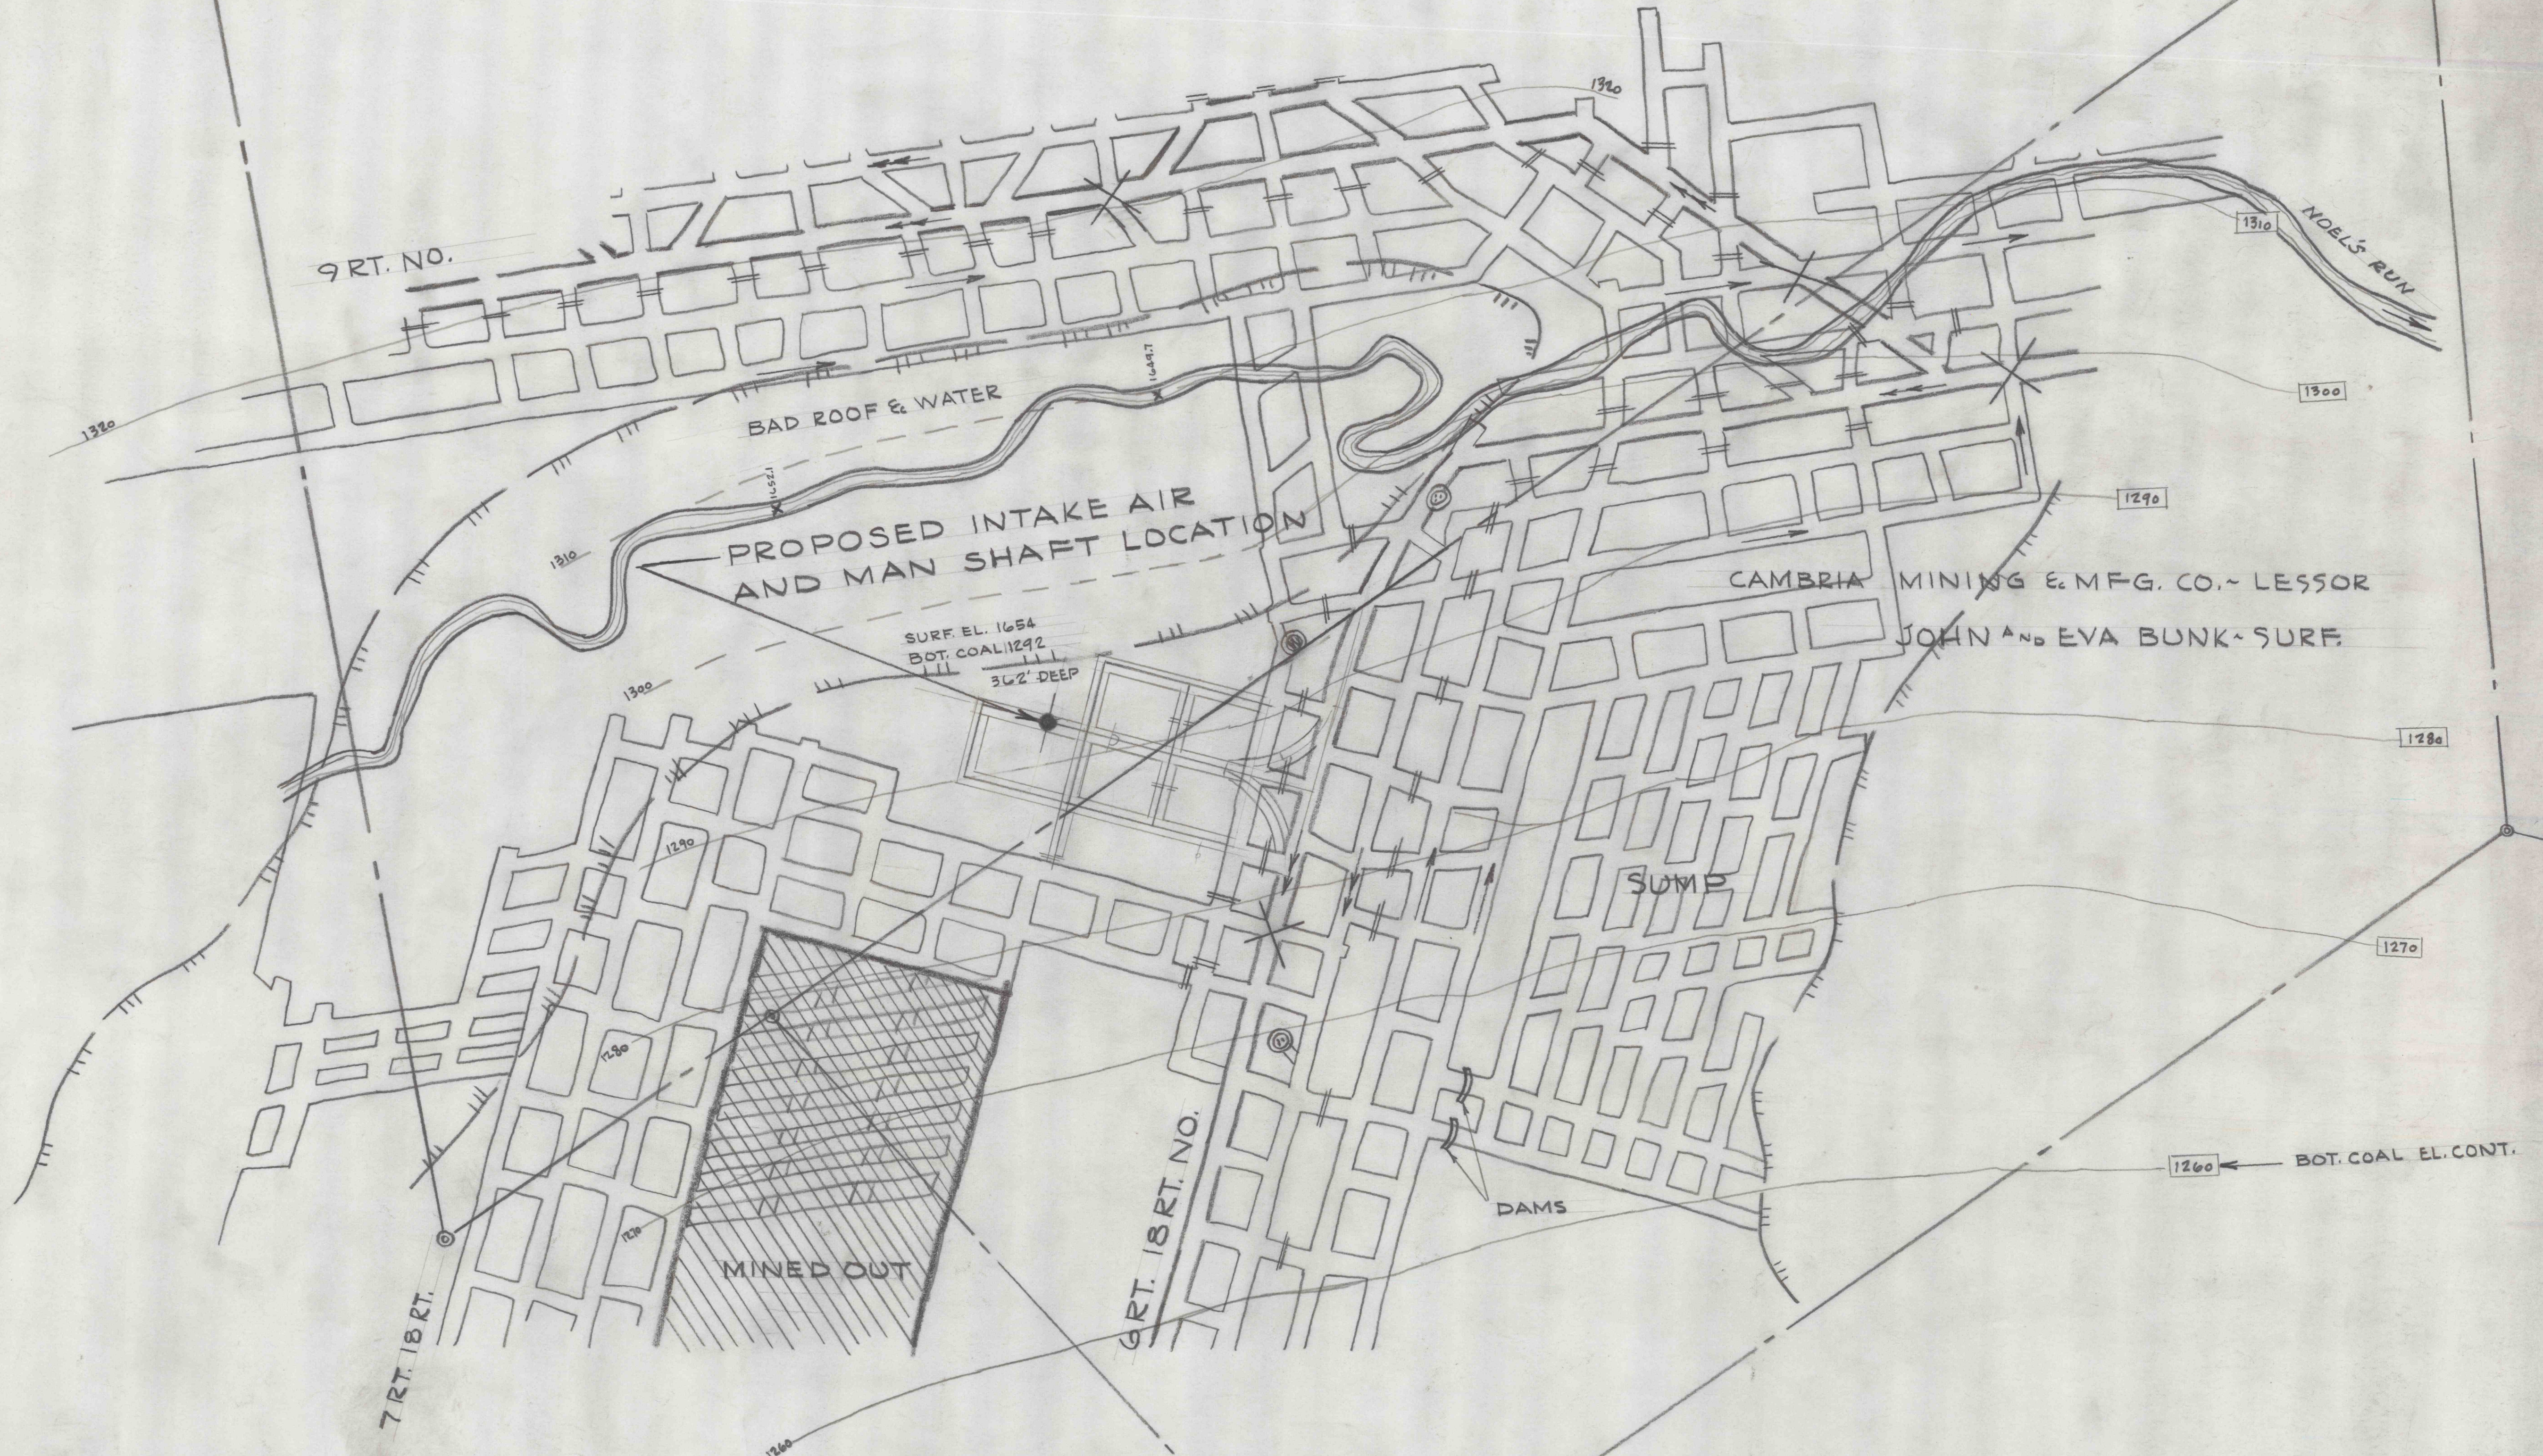

REFERENCES	DWG. NO.

REV.	DESCRIPTION	CHECKED BY	DATE

DRAWN BY	NAME	DATE
CHECKED BY		
APPROVED		

EASTERN GAS AND FUEL ASSOCIATES
COAL DIVISION
PITTSBURGH, PA.

SONMAN SLOPE
LOCATION OF THE
PROPOSED SHAFT
IN MINE WORKINGS.

SCALE
B. M. NO.
PROP. FILE NO.
50-P-2