


MARCH 15, 1979
SCALE 1" = 500'

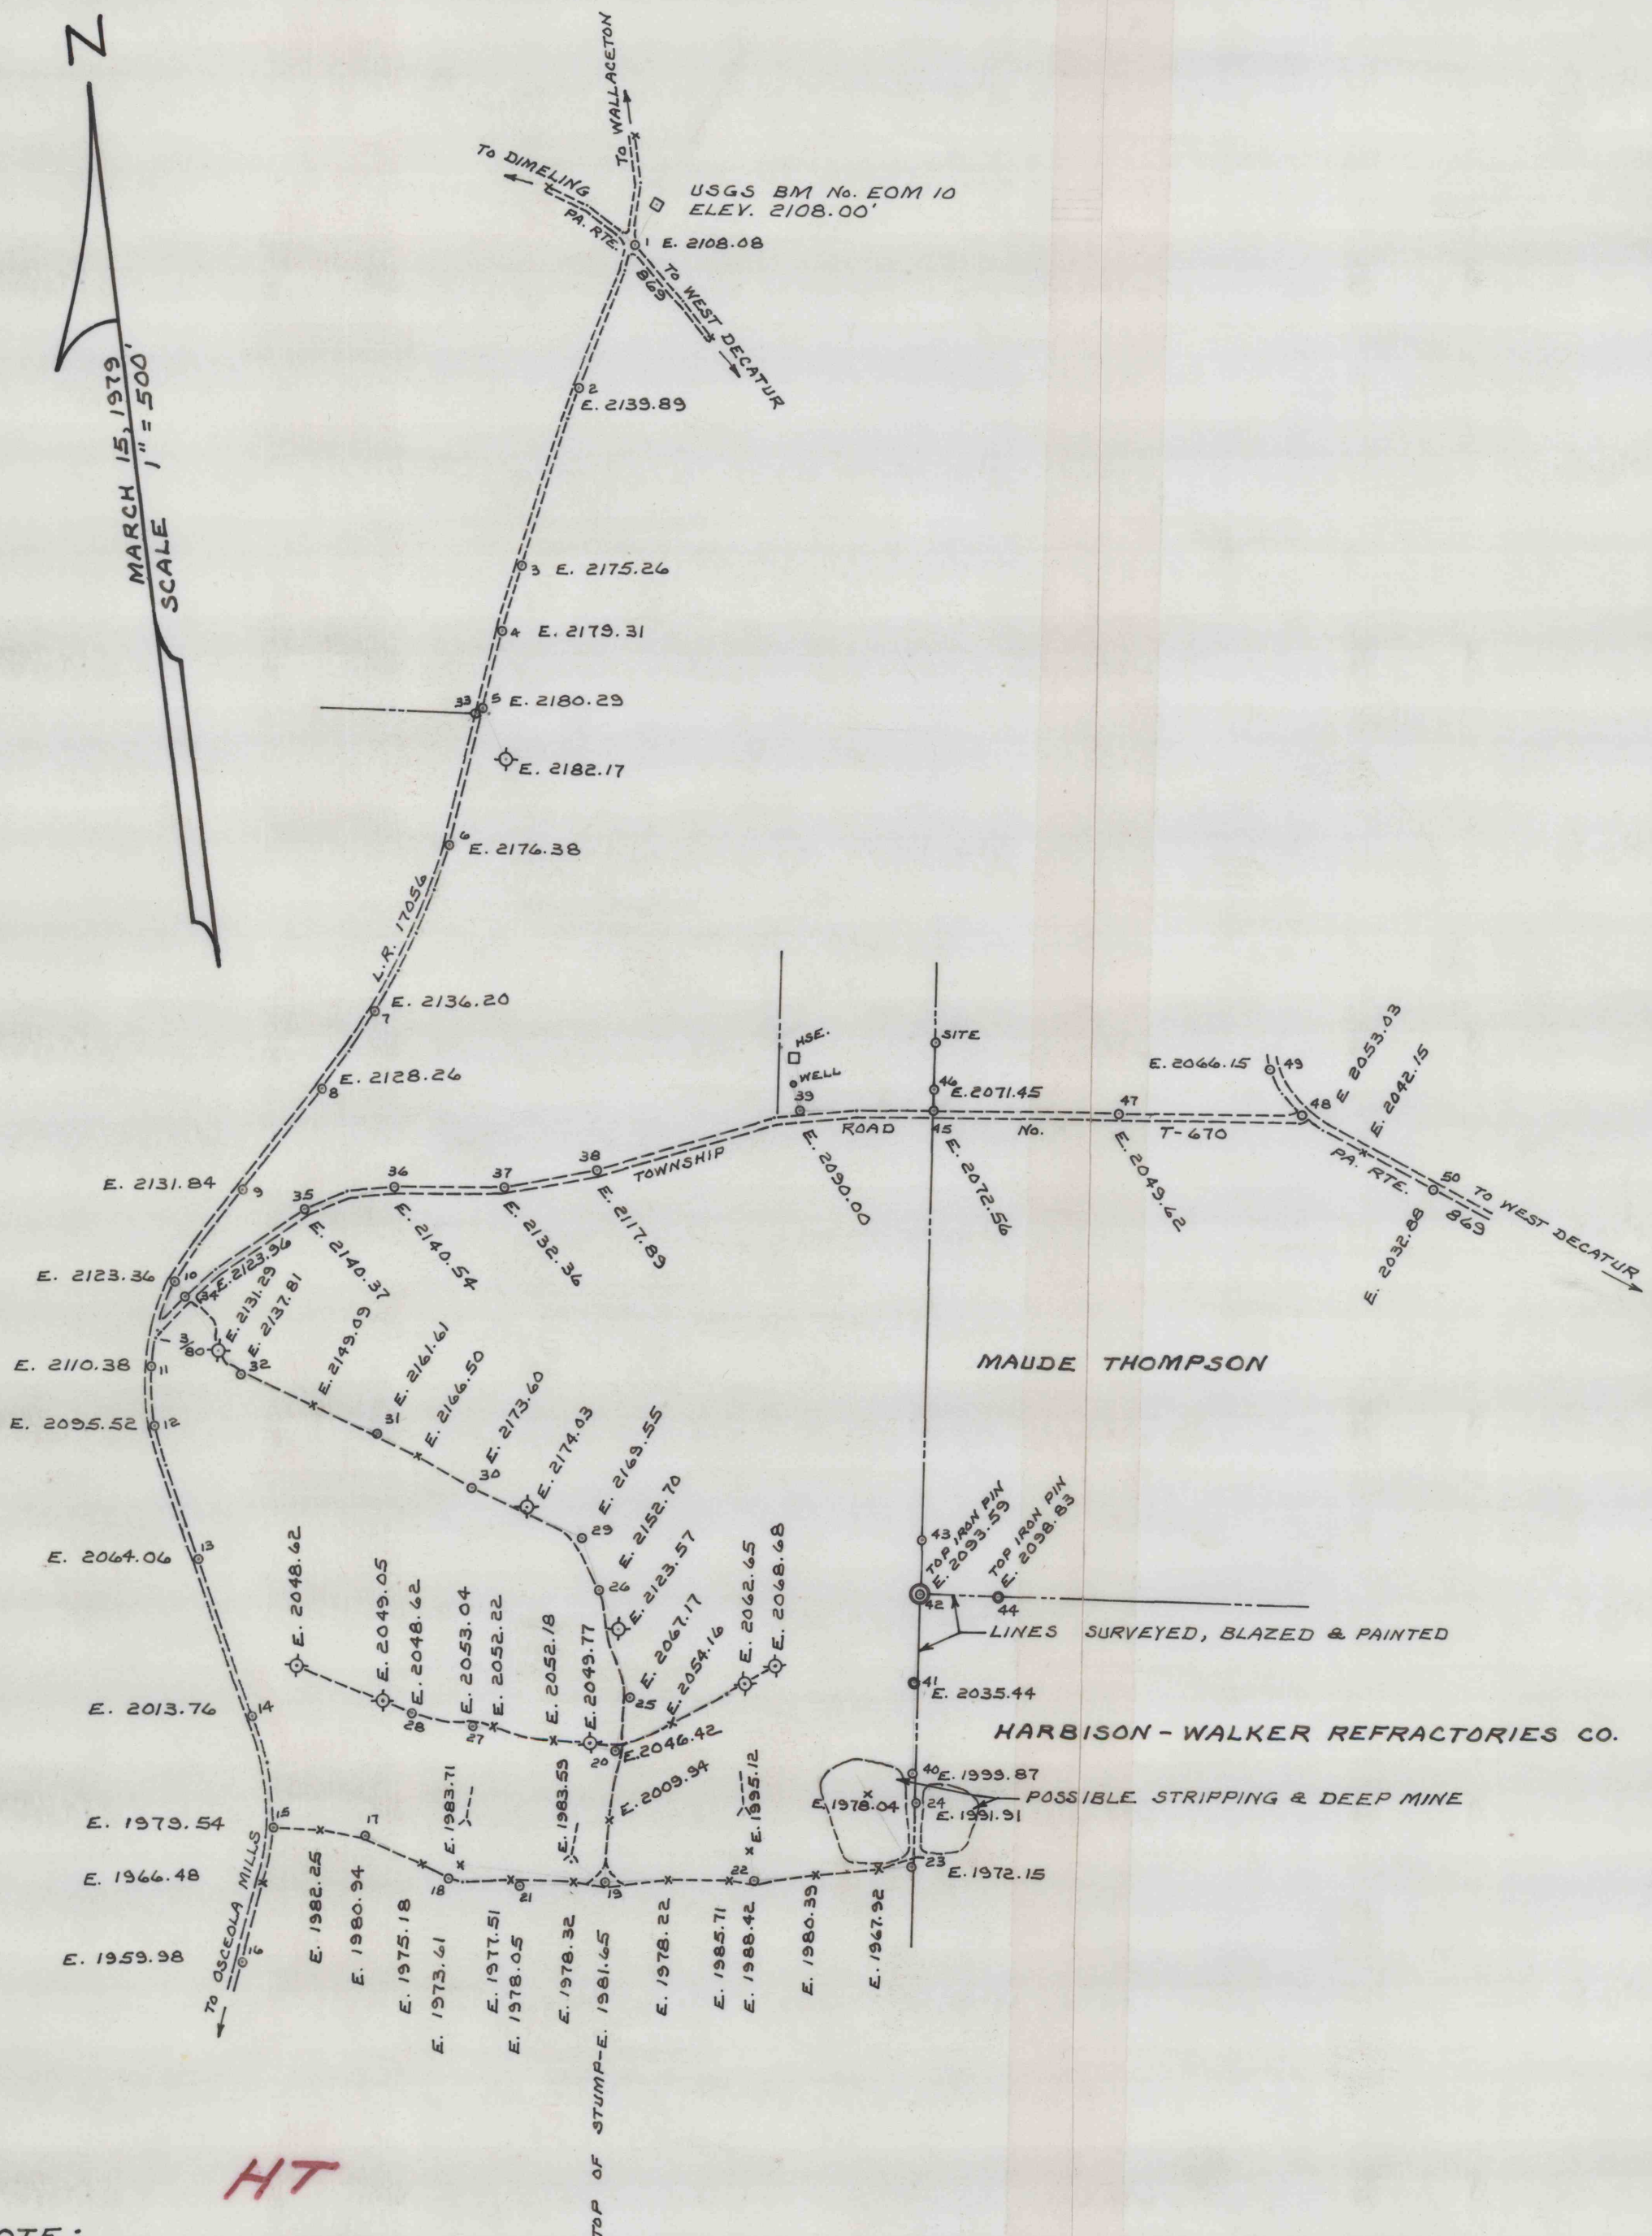

NOTE:

ALL ELEVATIONS COMPUTED FROM CHAINED SURVEY AND VERTICAL ANGLES.
BORE HOLE LOCATIONS AS INDICATED IN THE FIELD BY DOUBLE FLAGGING PLACED BY AQUITAINE PA. INC.
SURVEY TIES HOR. 1' / 2812' 1.99' VER. -0.01'

NB 80K Pg. 41

C.D. 874

1005

3889 kls