


4668

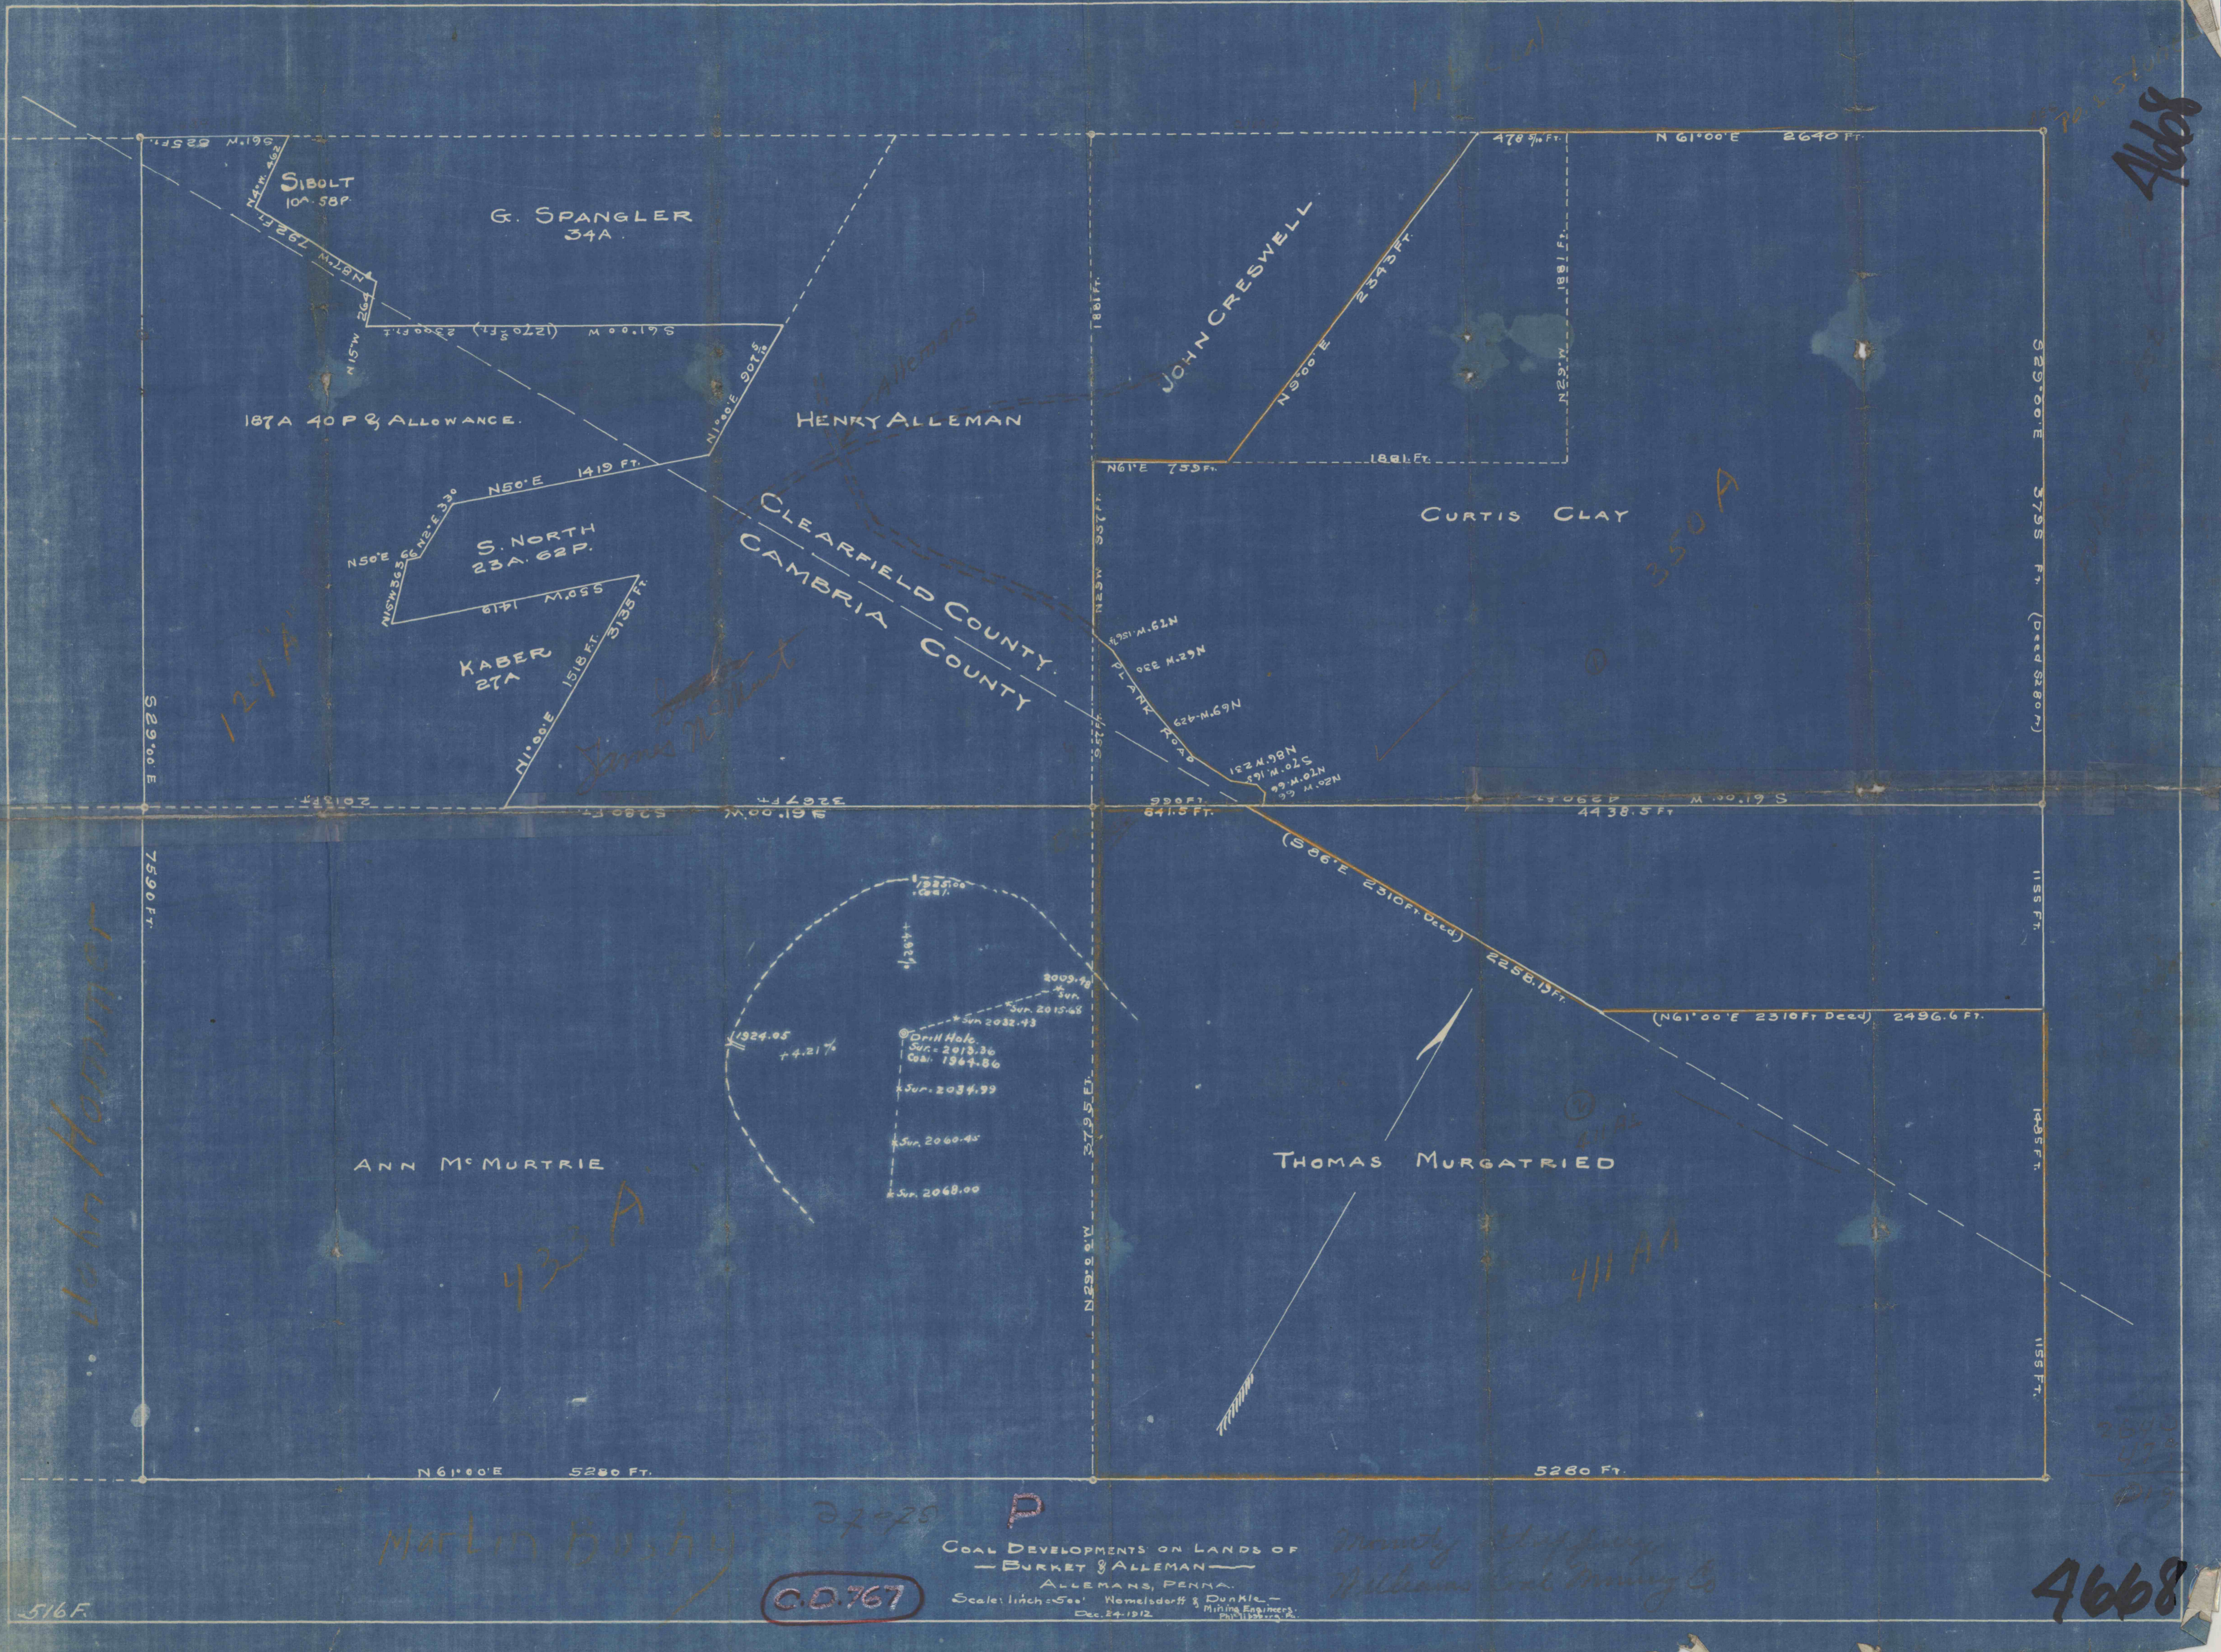

124 A

350 A

433 A

411 AA

4668

516 F.

Marlin Bushy

C.D. 767

COAL DEVELOPMENTS ON LANDS OF
 BURKET & ALLEMAN
 ALLEMANS, PENNA.
 Scale: 1 inch = 500 feet
 Wamelsdorf & Dunkle
 Dec. 24, 1912

Wm. H. Stapp
 Alleman Coal Mining Co.

SIBOLT

10A-58P

G. SPANGLER
34A

JOHN CRESWELL

HENRY ALLEMAN

CURTIS CLAY

S. NORTH
23A-62P

KABER
27A

CLEARFIELD COUNTY
CAMBRIA COUNTY

THOMAS MURGATRIED

Drill Hole
 Sur. = 2019.36
 Cor. = 1947.80
 Sur. = 2034.99
 Sur. = 2000.45
 Sur. = 2068.00

ANN M' MURTRIE