


1099

1096

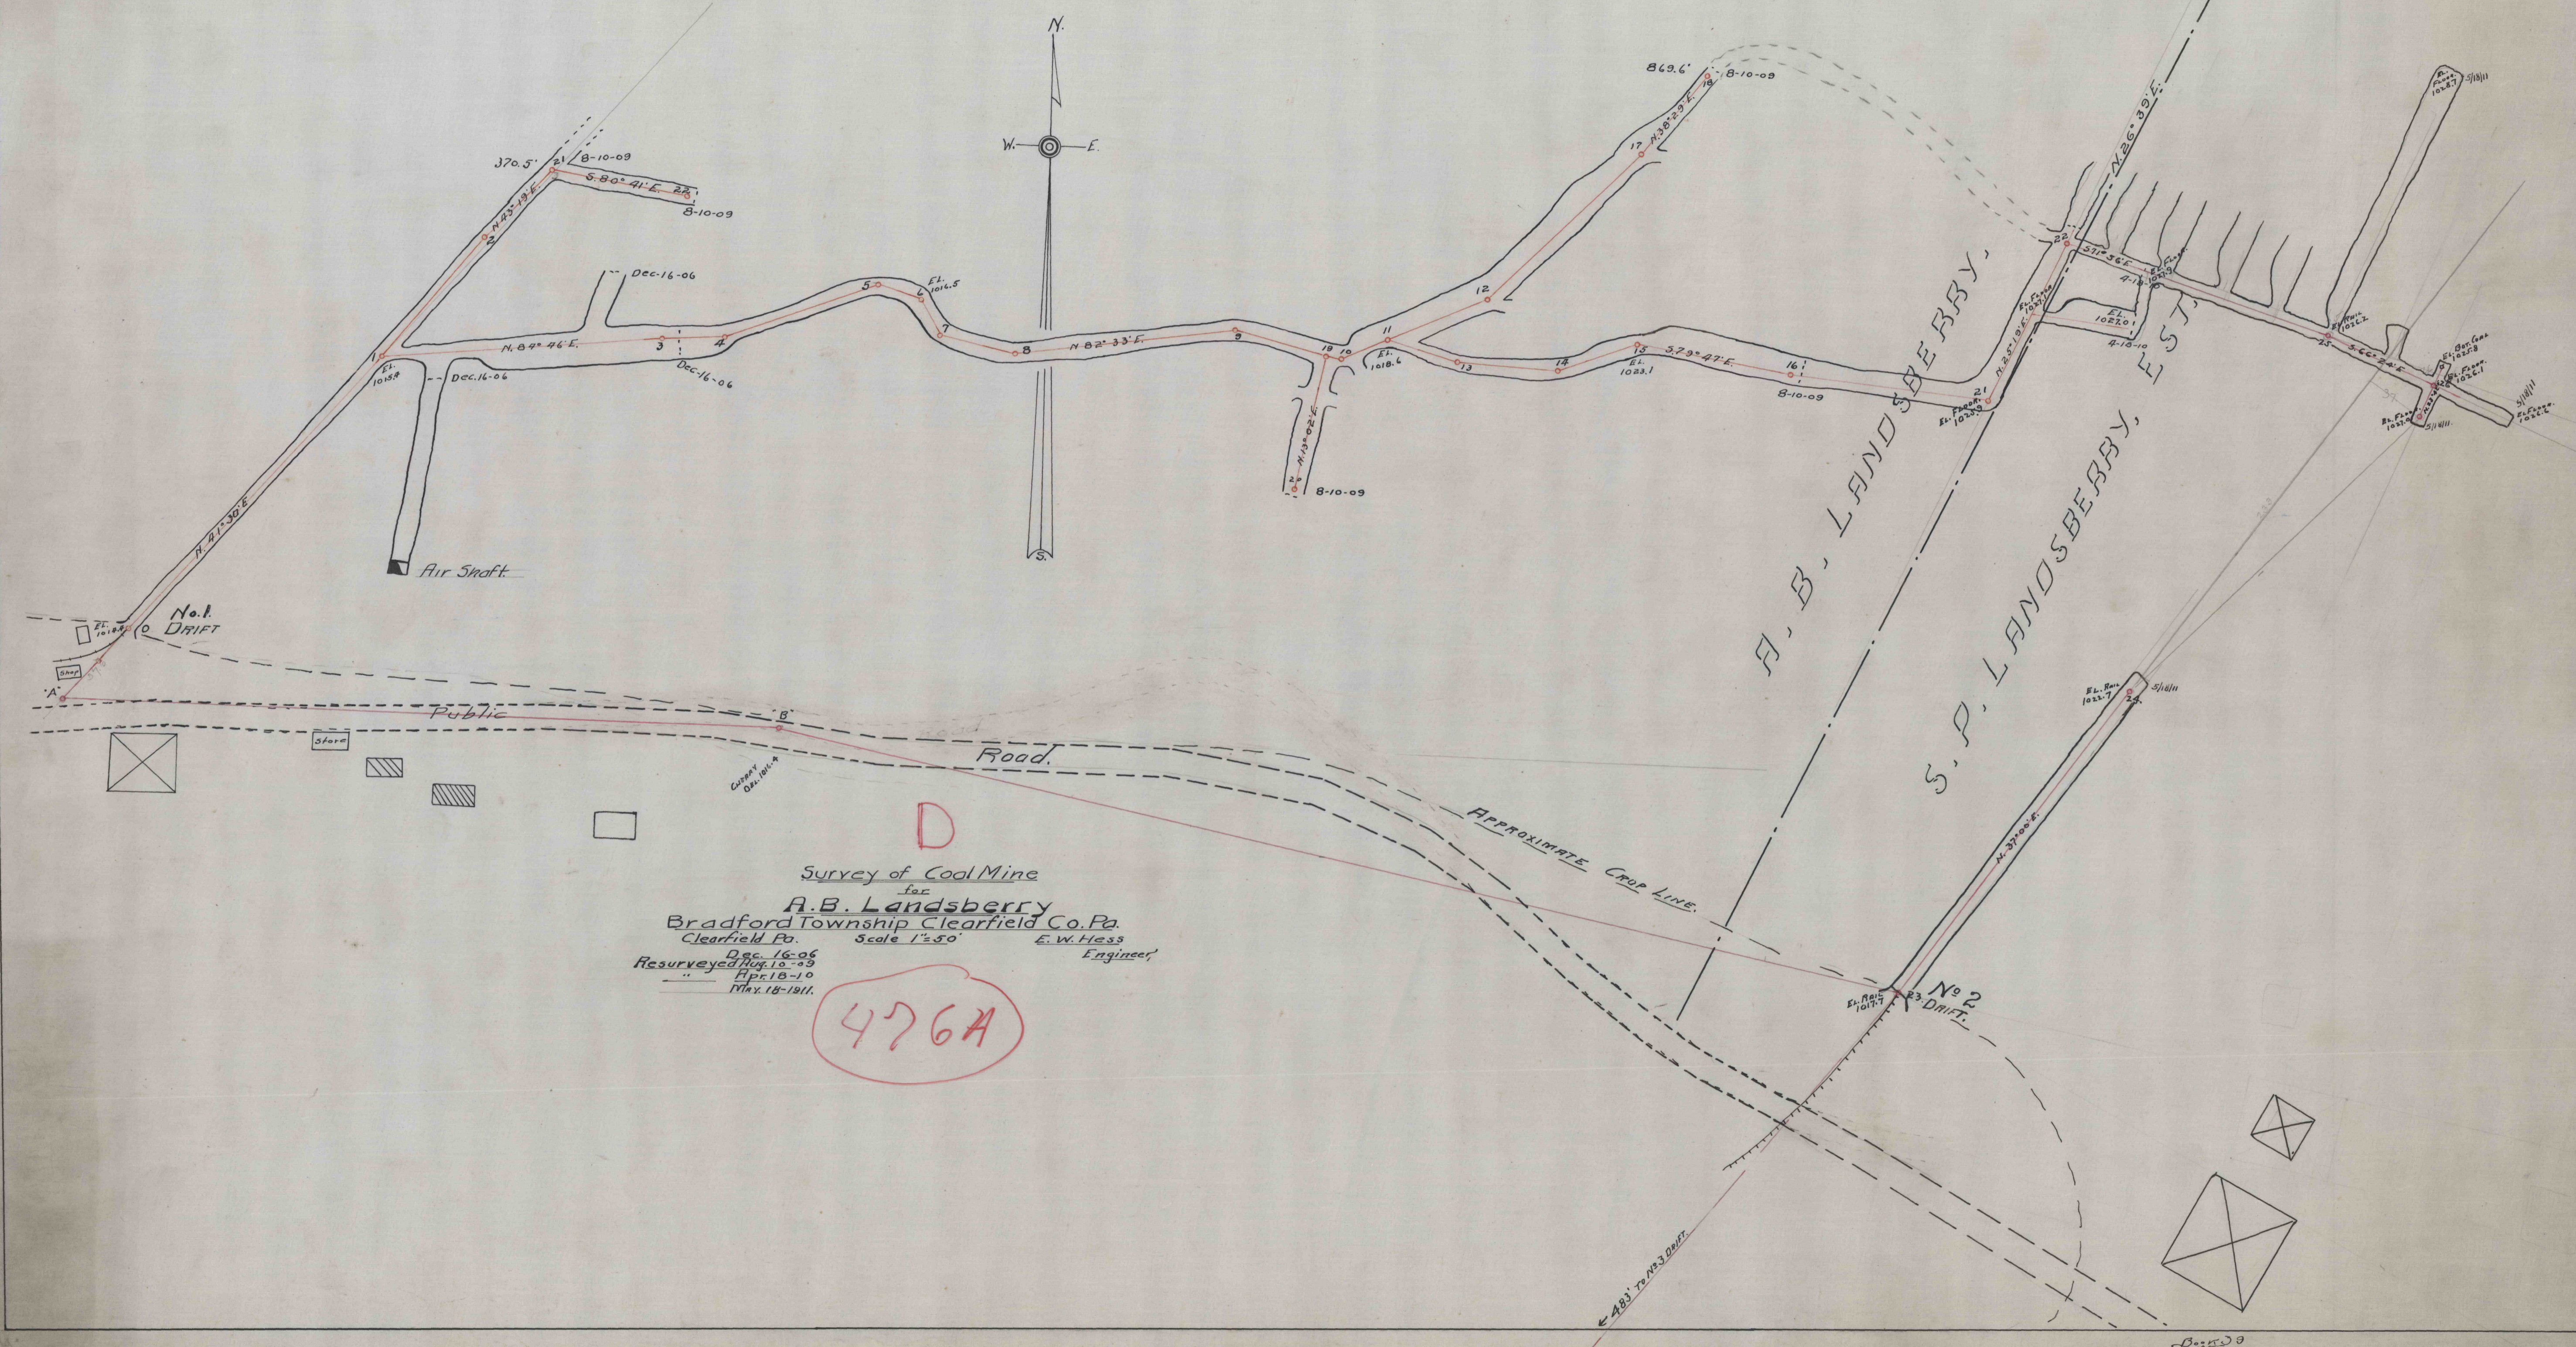

Survey of Coal Mine
 for
A.B. Landsbery
 Bradford Township Clearfield Co. Pa.
 Clearfield Pa. Scale 1"=50' E.W. Hess
 Engineer,
 Dec. 16-06
 Resurveyed Aug. 10-09
 Apr. 18-10
 May. 18-1911.

476A