


Proposed Haulway  
at Marion Centre  
Cambria Co. Pa.

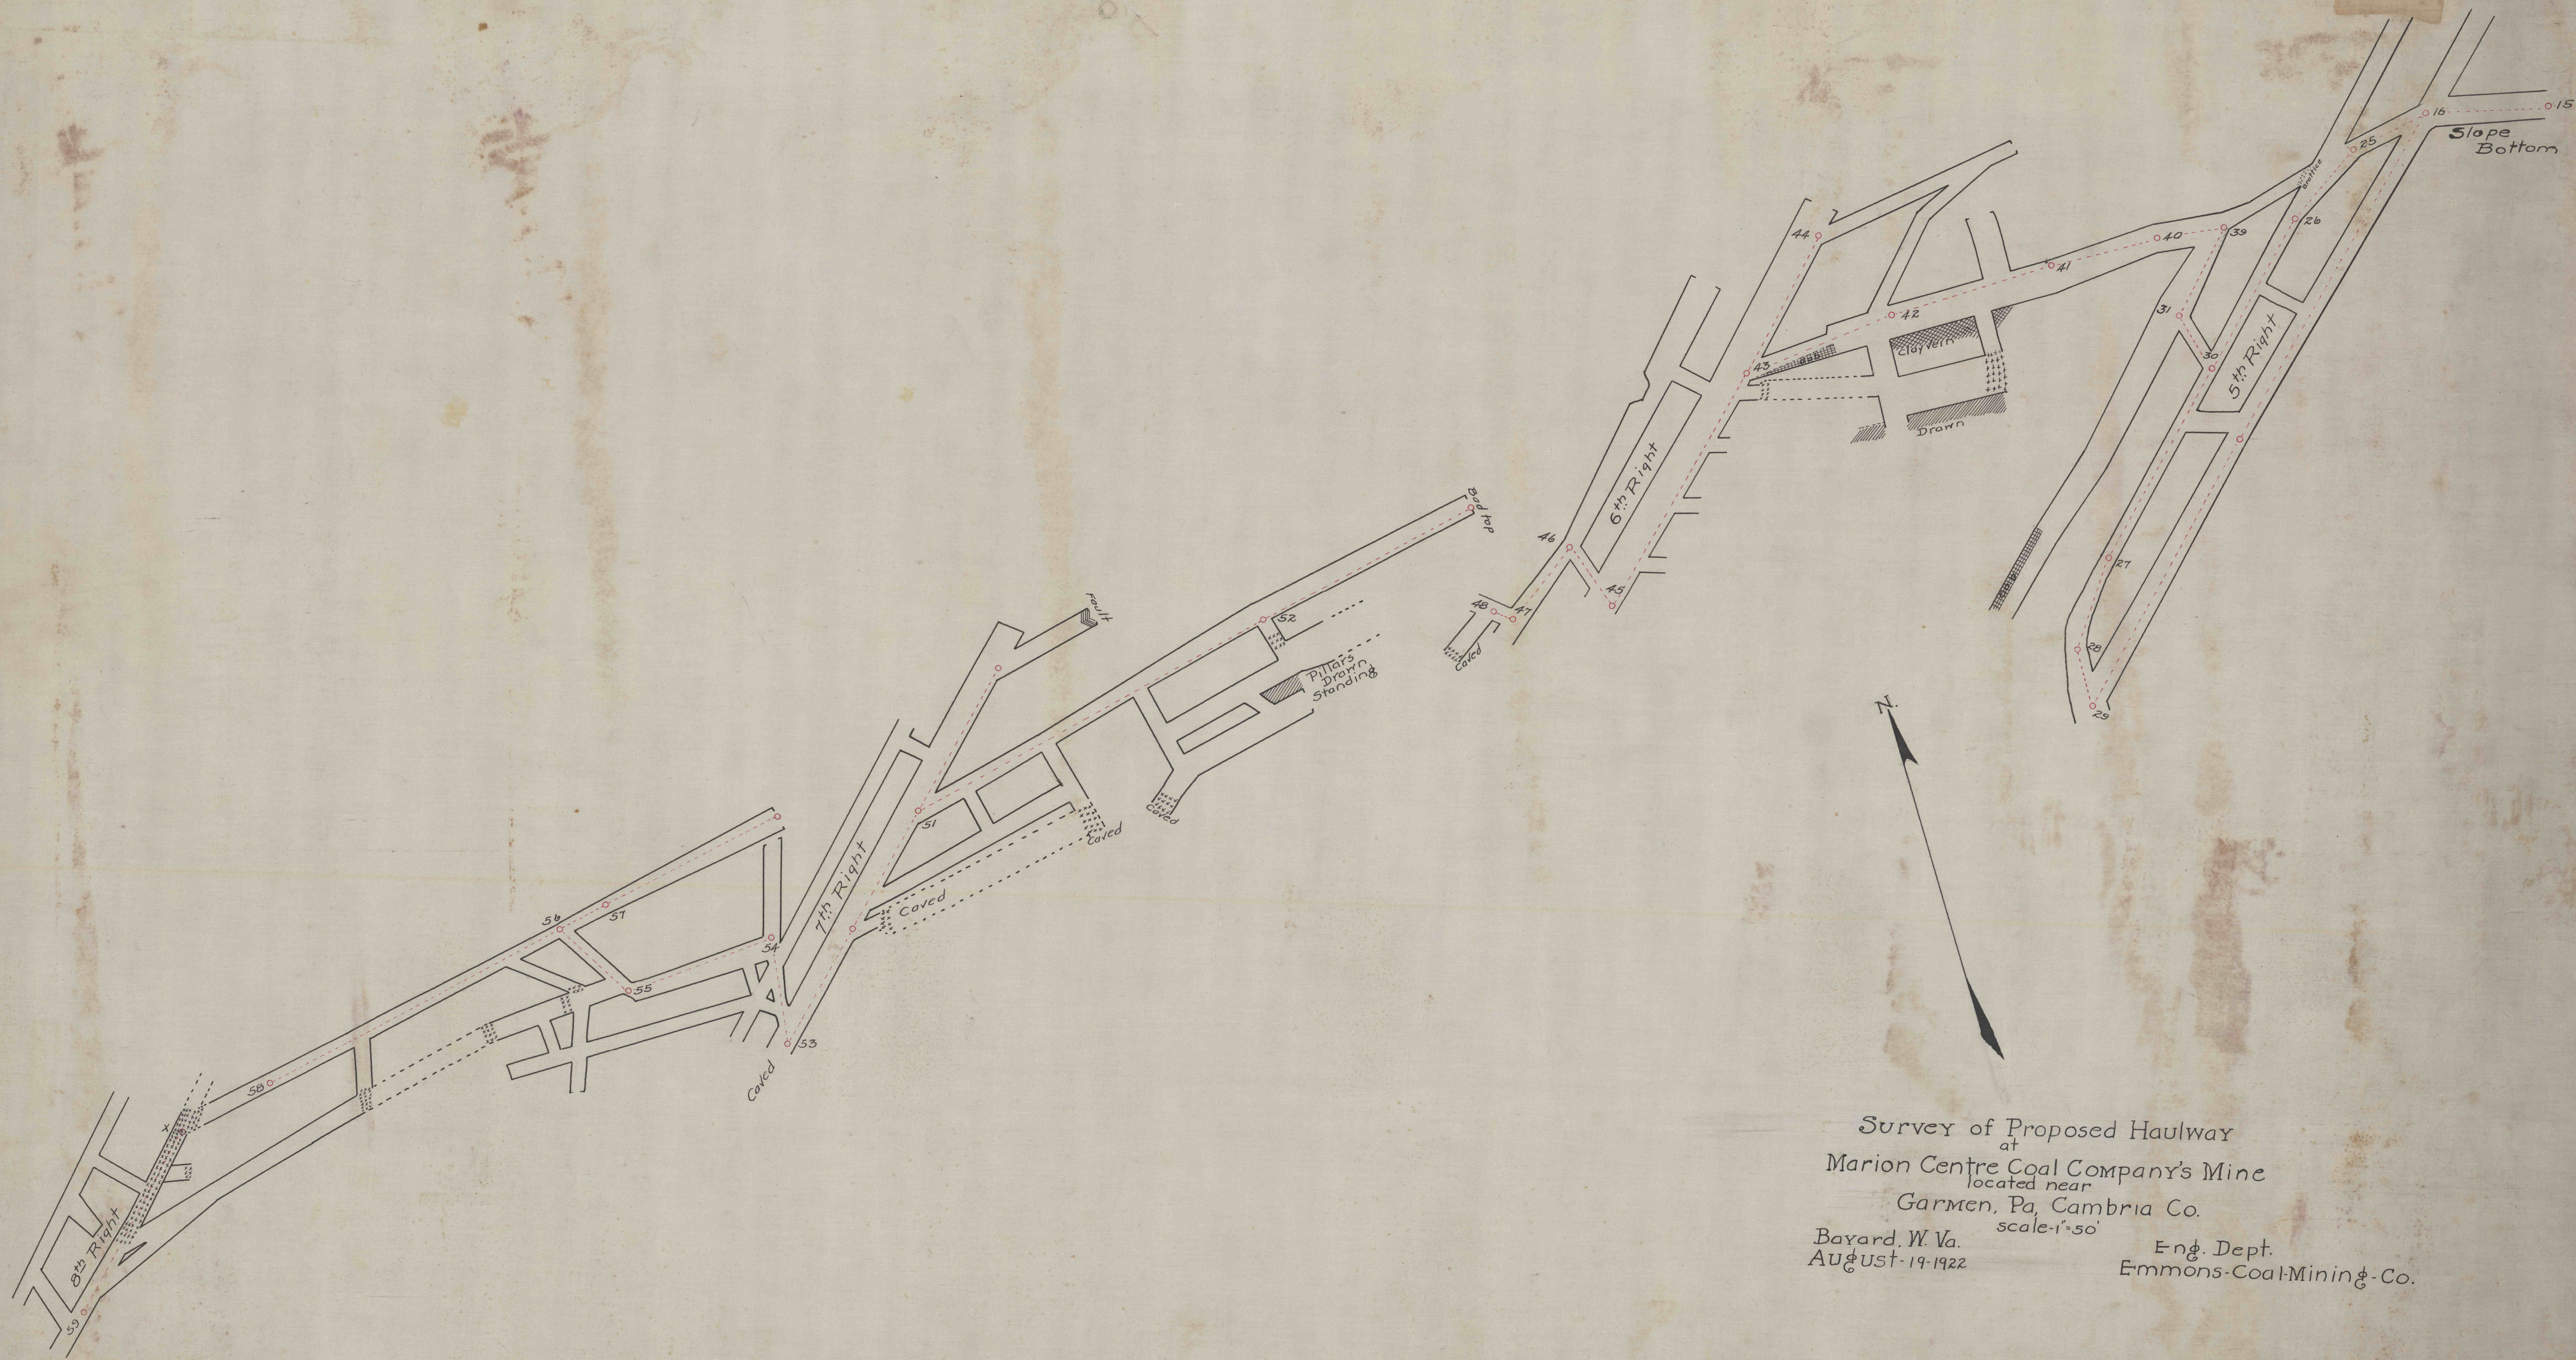

Survey of Proposed Haulway  
at  
Marion Centre Coal Company's Mine  
located near  
Garmen, Pa, Cambria Co.  
scale-1"=50'  
Bayard, W. Va.  
August-19-1922  
Eng. Dept.  
Emmons-Coal-Mining & Co.