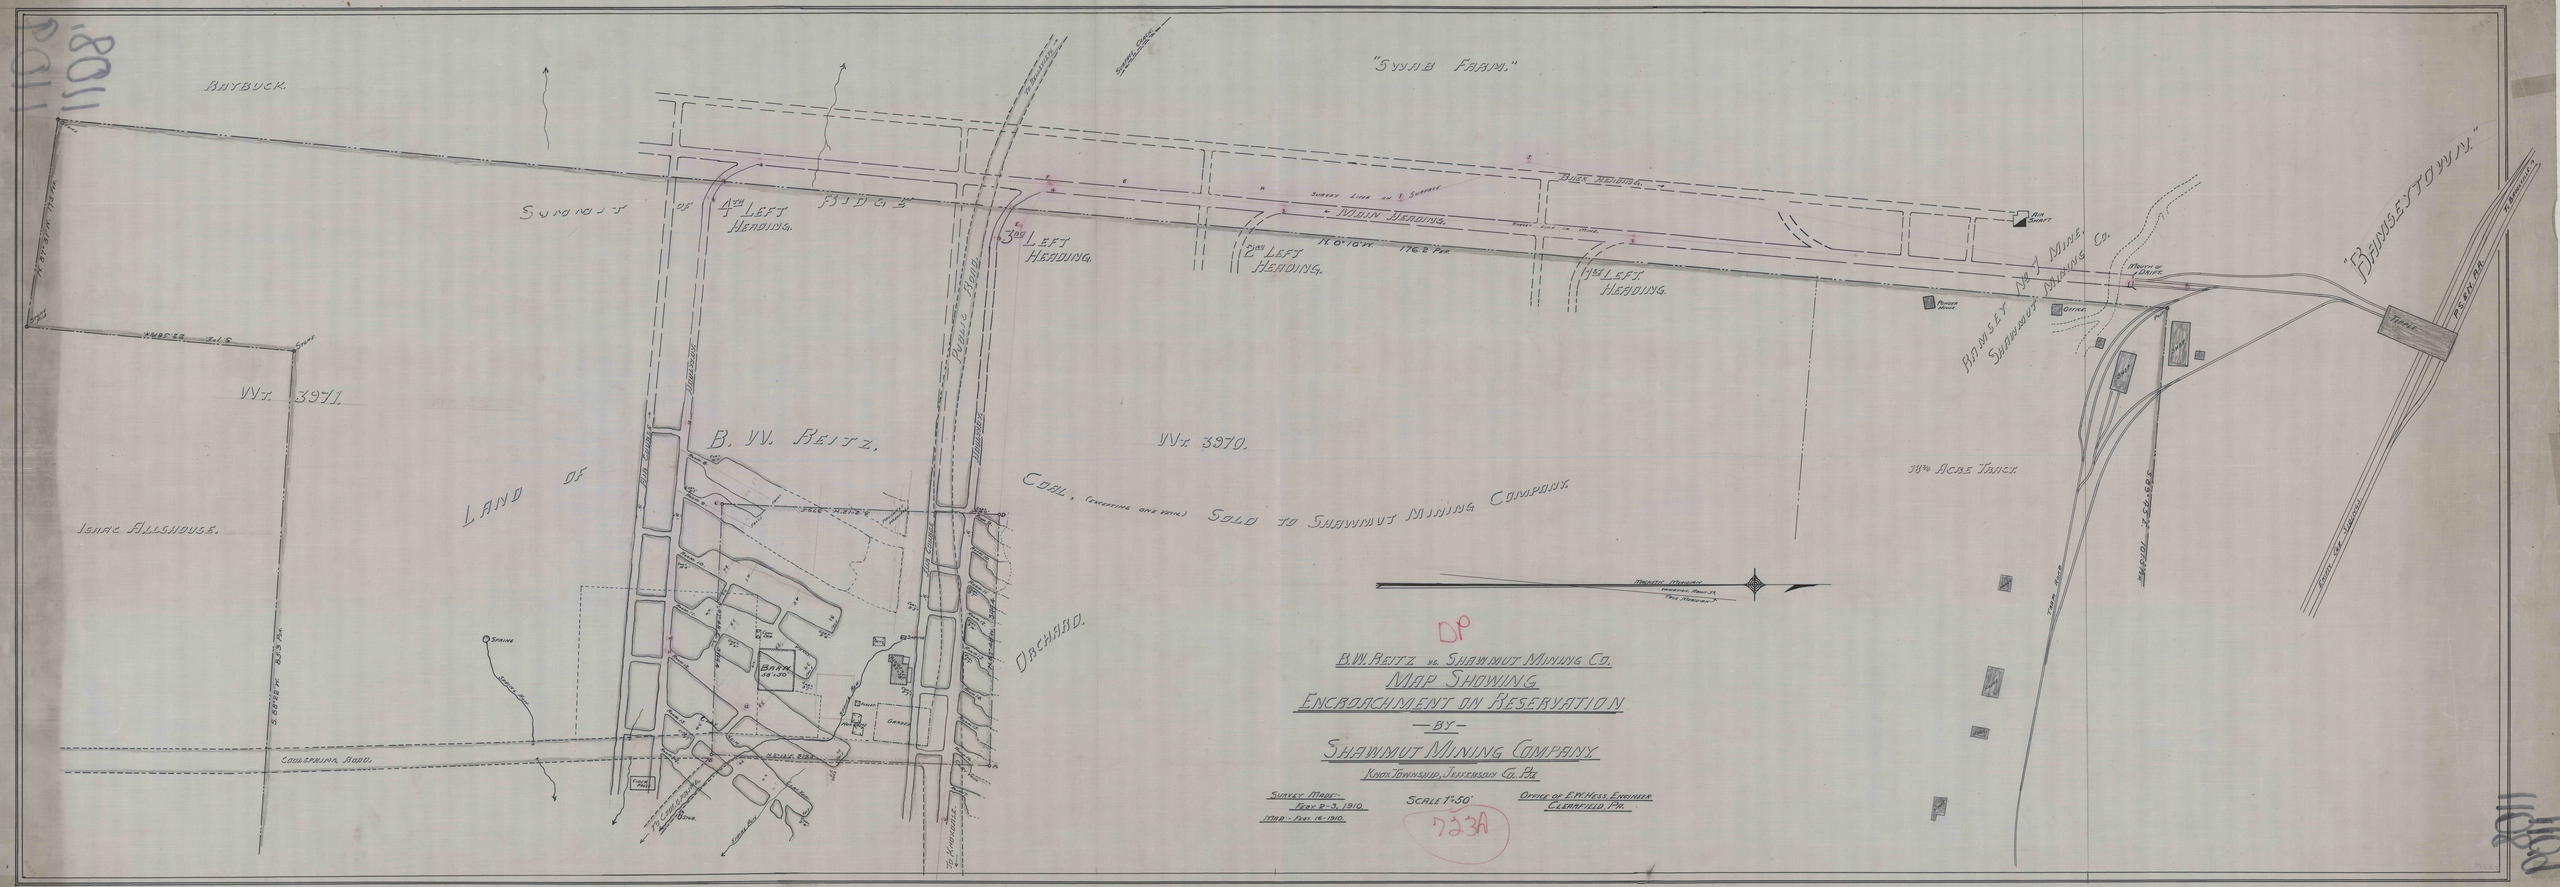
BATBUCK.
"SYNAB FARM."
SUMMIT OF BIBG
4TH LEFT HEADING.
3RD LEFT HEADING.
2ND LEFT HEADING.
1ST LEFT HEADING.
MAIN HEADING.
BACK HEADING.
SURVEY LINE ON SURFACE
N 0°10' W 176.2 PER
AIR SHAFT
POWER HOUSE
OFFICE
NO. 1 MINE
TIPPLE
P.B.R.R.
SCALE OF SECTIONS
38TH ACRE TRACT
VV. 3971.
ISAAC ALLSHOUSE.
LAND OF
B. W. REITZ.
VV. 3970.
ORCHARD.
BARN 48'x30'
HOUSE
GARDEN
SPRING
SCALE 1" = 50'
DP
B.W. REITZ vs. SHAWMUT MINING CO.
MAP SHOWING
ENCROACHMENT ON RESERVATION
—BY—
SHAWMUT MINING COMPANY
KNOX TOWNSHIP, JEFFERSON CO. PA.
SURVEY MADE:- FEBY 2-3, 1910.
TITLED:- FEBY 16-1910.
SCALE 1" = 50'
OFFICE OF E.W. HEES, ENGINEER CLEARFIELD PA.
723A