
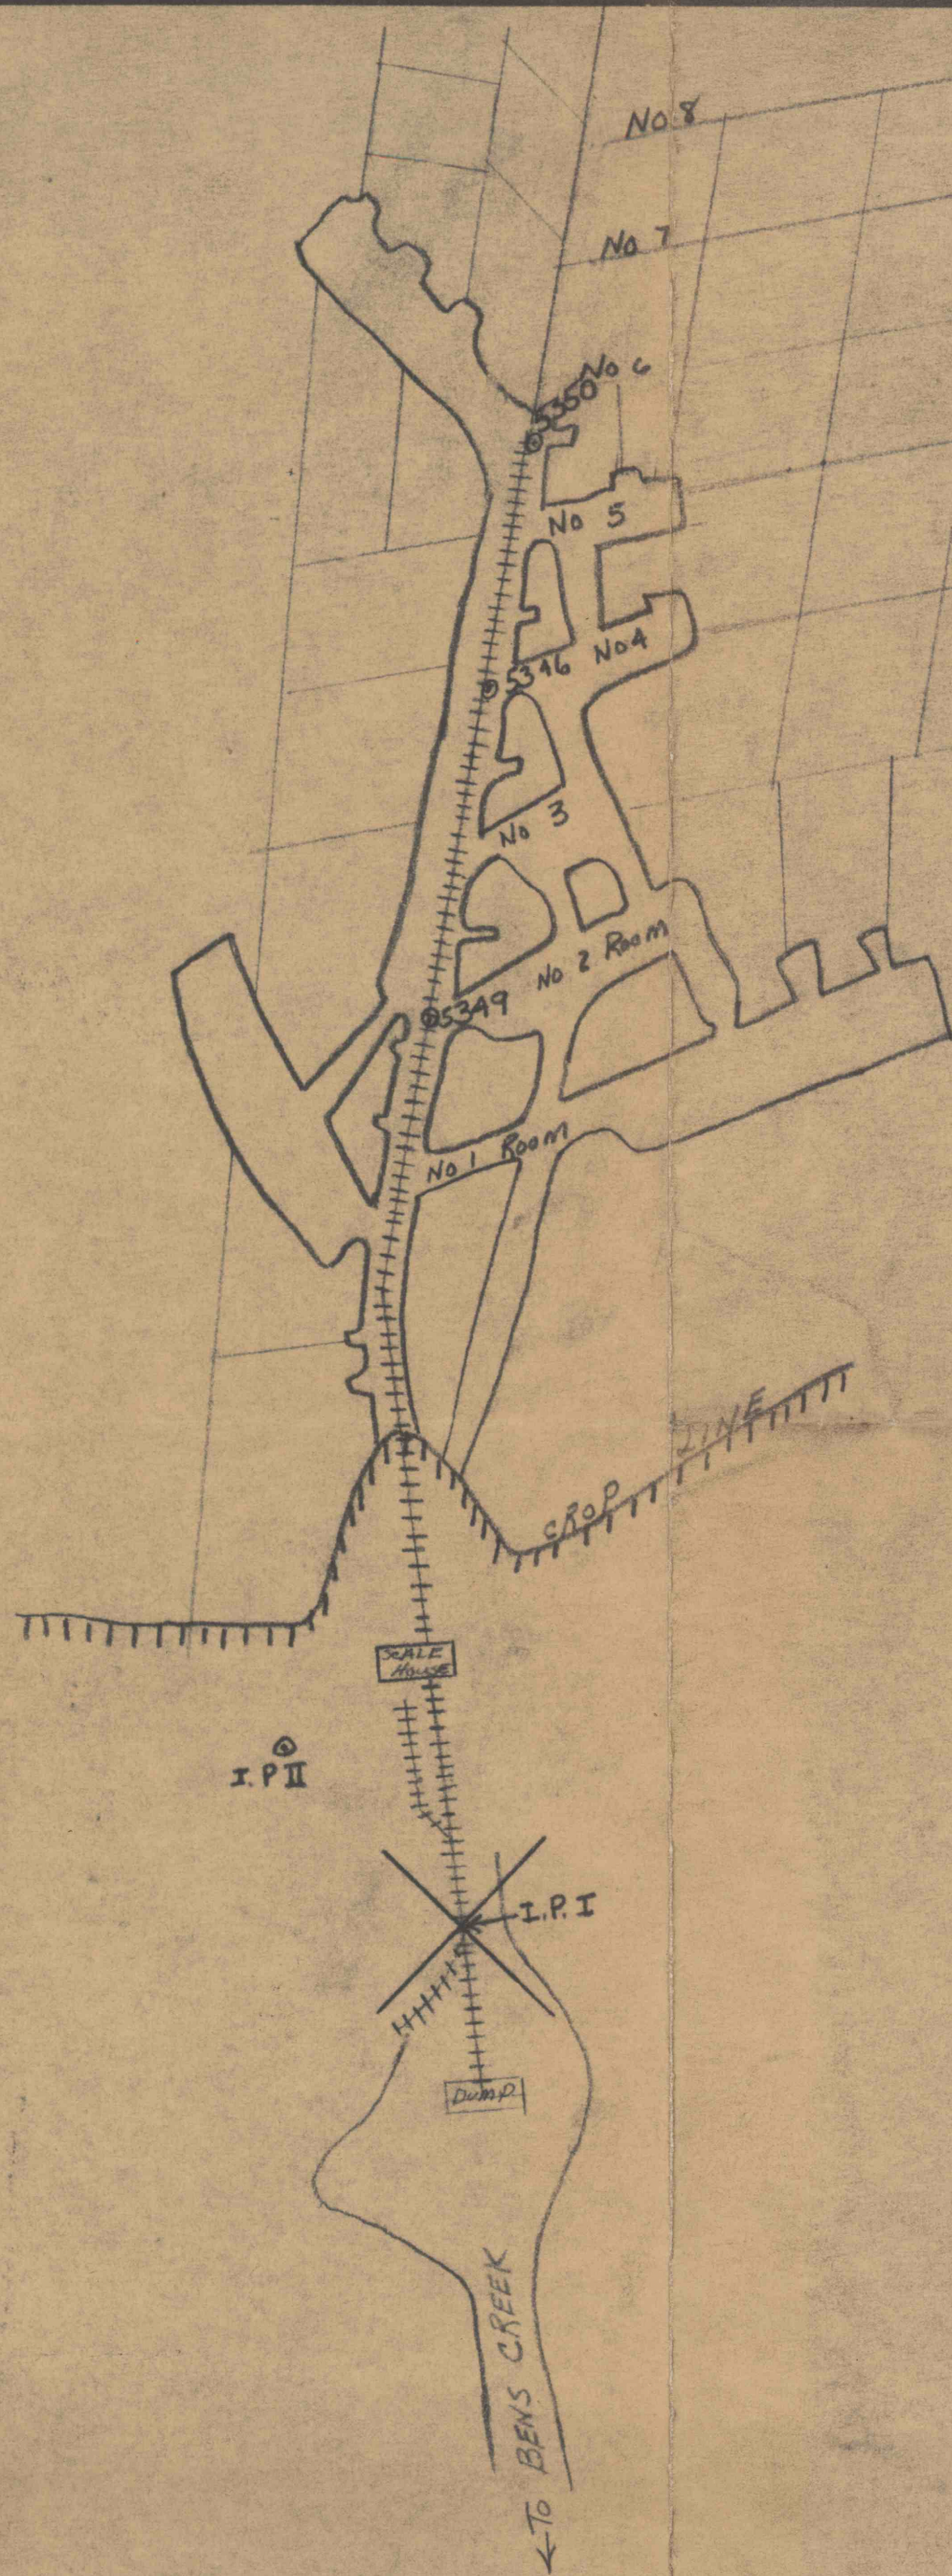


Hoberney
Coal Mine
Qu Mine

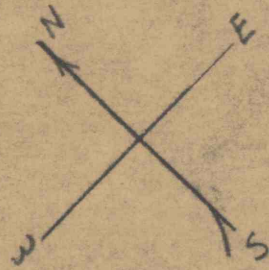

NOTE - STAS - 5350 - 5346 - 5349 - ARE ON HDG AZM - 56 - 00
 CoRD - 5350 - N - 5272.35
 E - 5306.69

REFERENCES	DWG. NO.	DRAWN BY	NAME	DATE
		J.C.P.		AUG - 1960
		REVISED		

GEORGE HOBERNEY COAL MINE ABOVE BENS - CREEK	SCALE 1" = 50'	B. M. NO.