


1164

1164

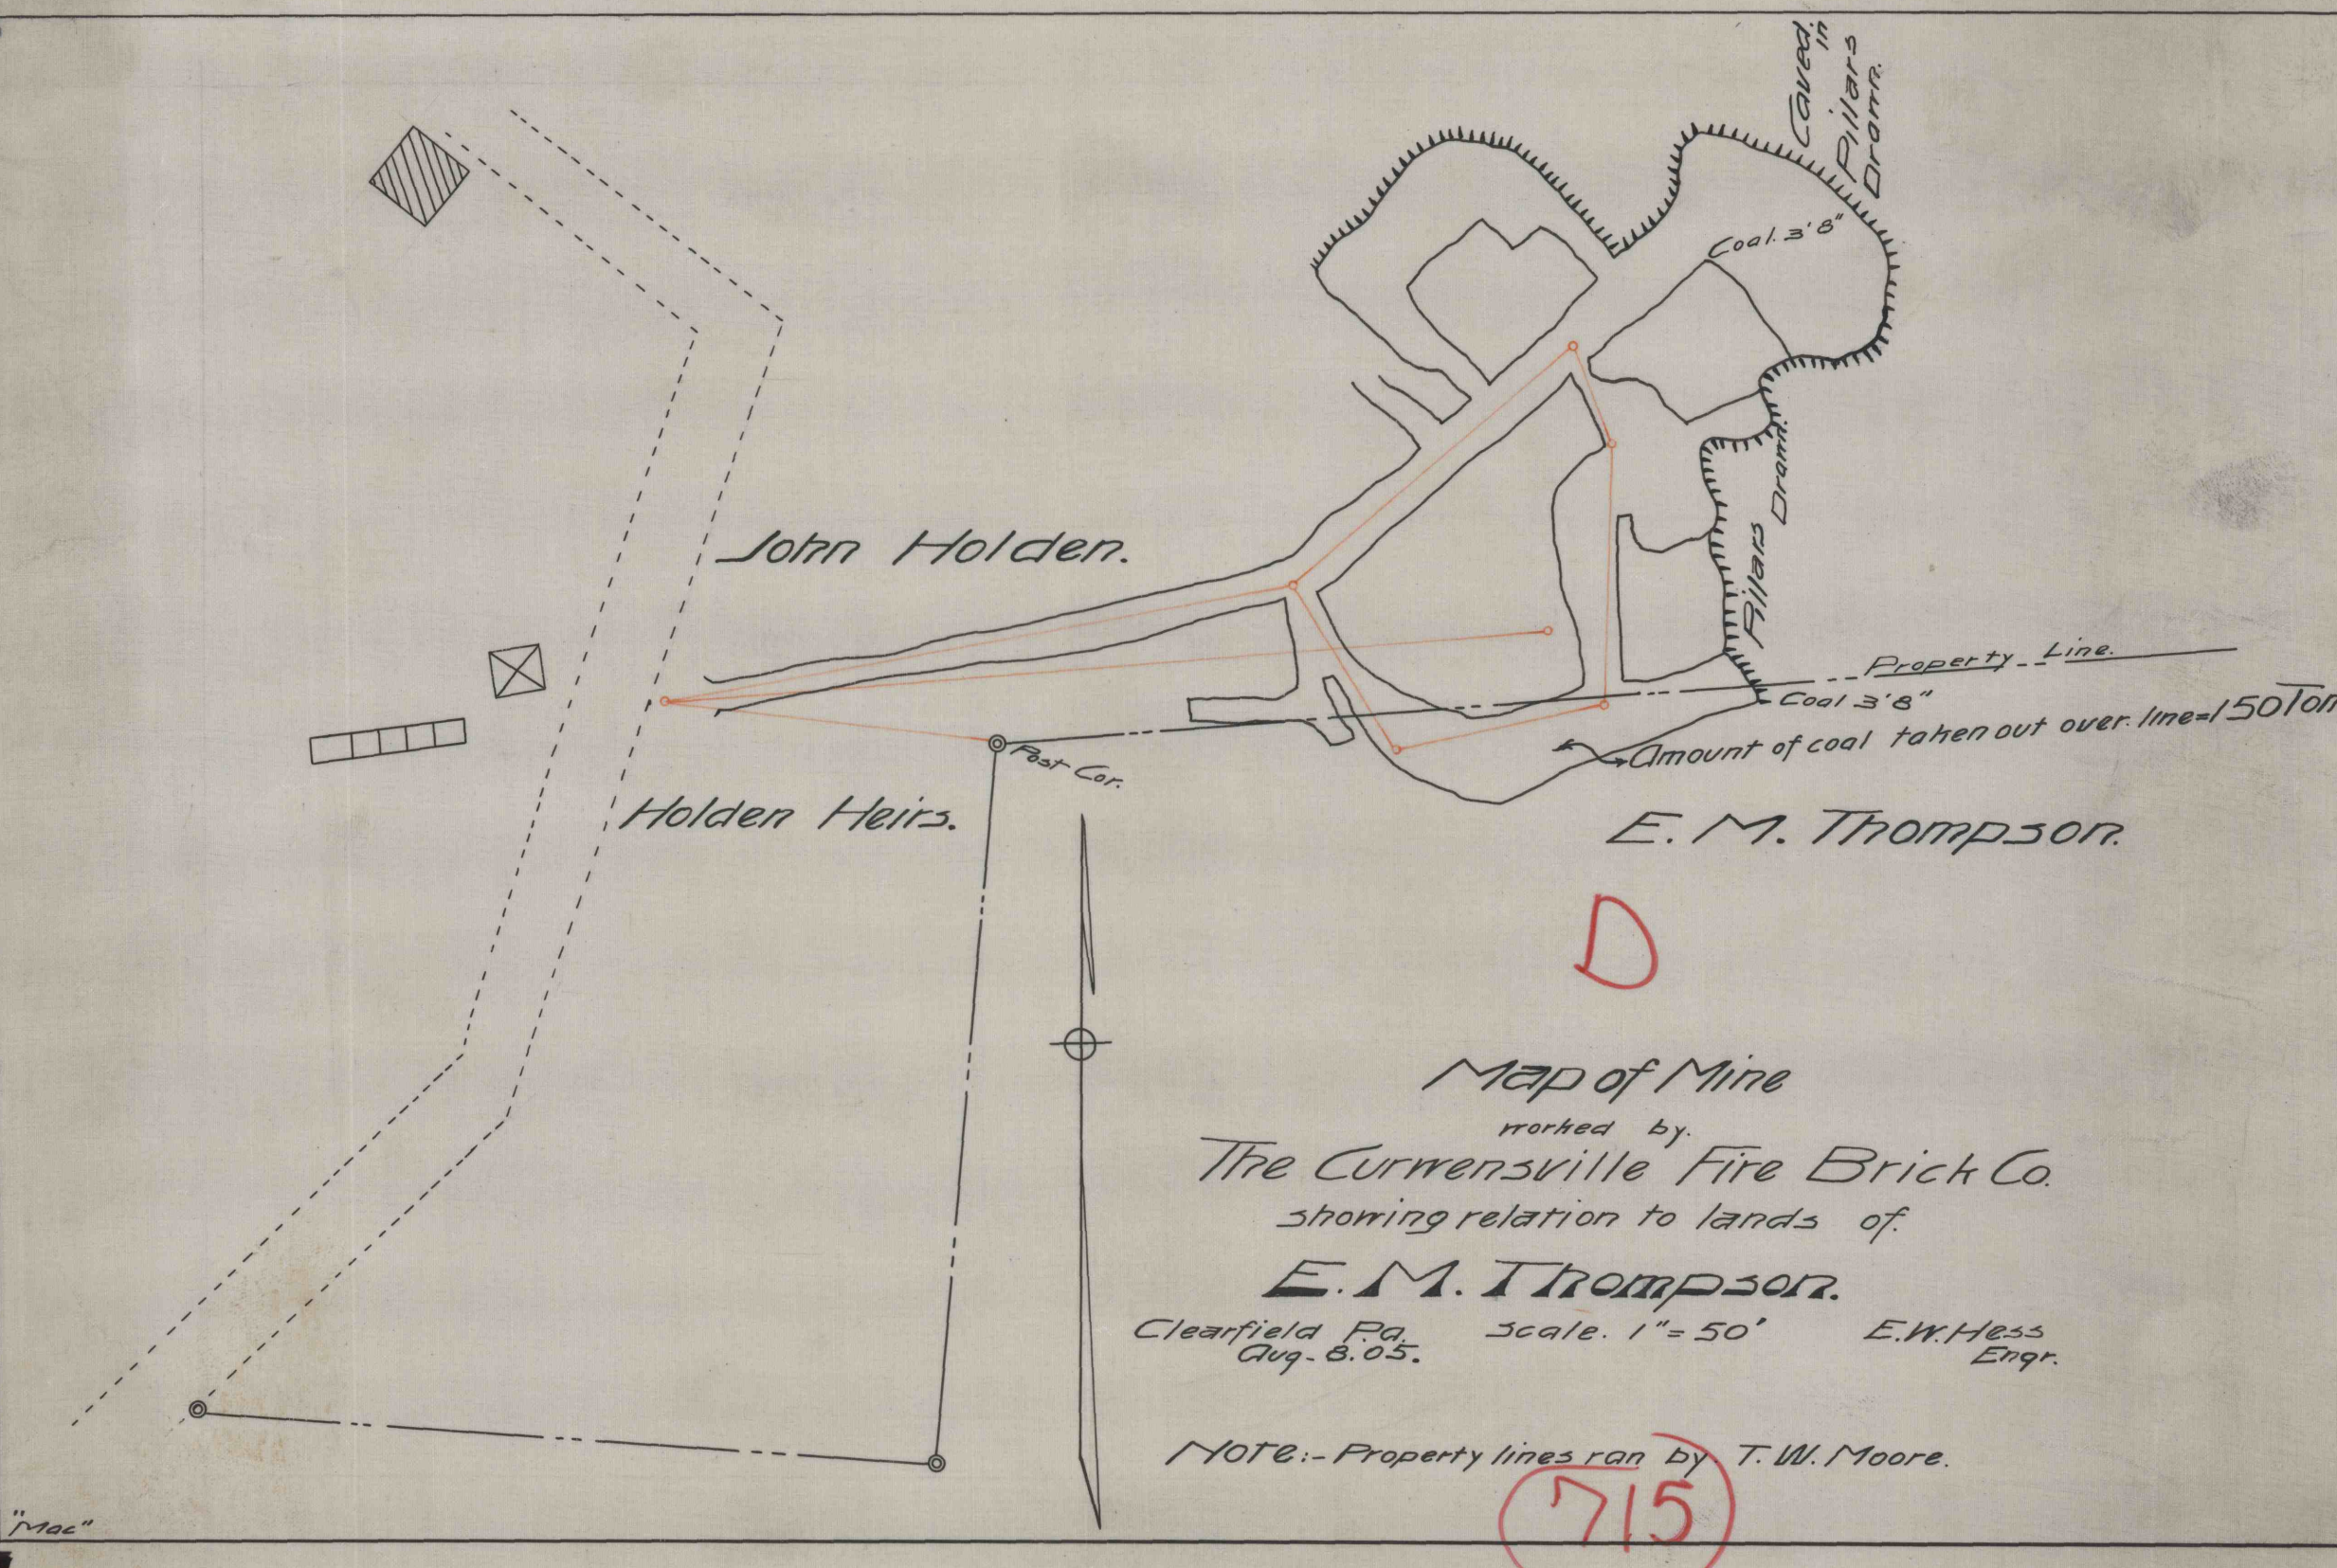

D

Map of Mine
 worked by
 The Currensville Fire Brick Co.
 showing relation to lands of
 E. M. Thompson.
 Clearfield Pa. Aug. 8.05. scale. 1" = 50' E.W. Hess
 Engr.

NOTE:- Property lines ran by T. W. Moore.

715

"Mac"