


E 110000

E 110500

N 117000

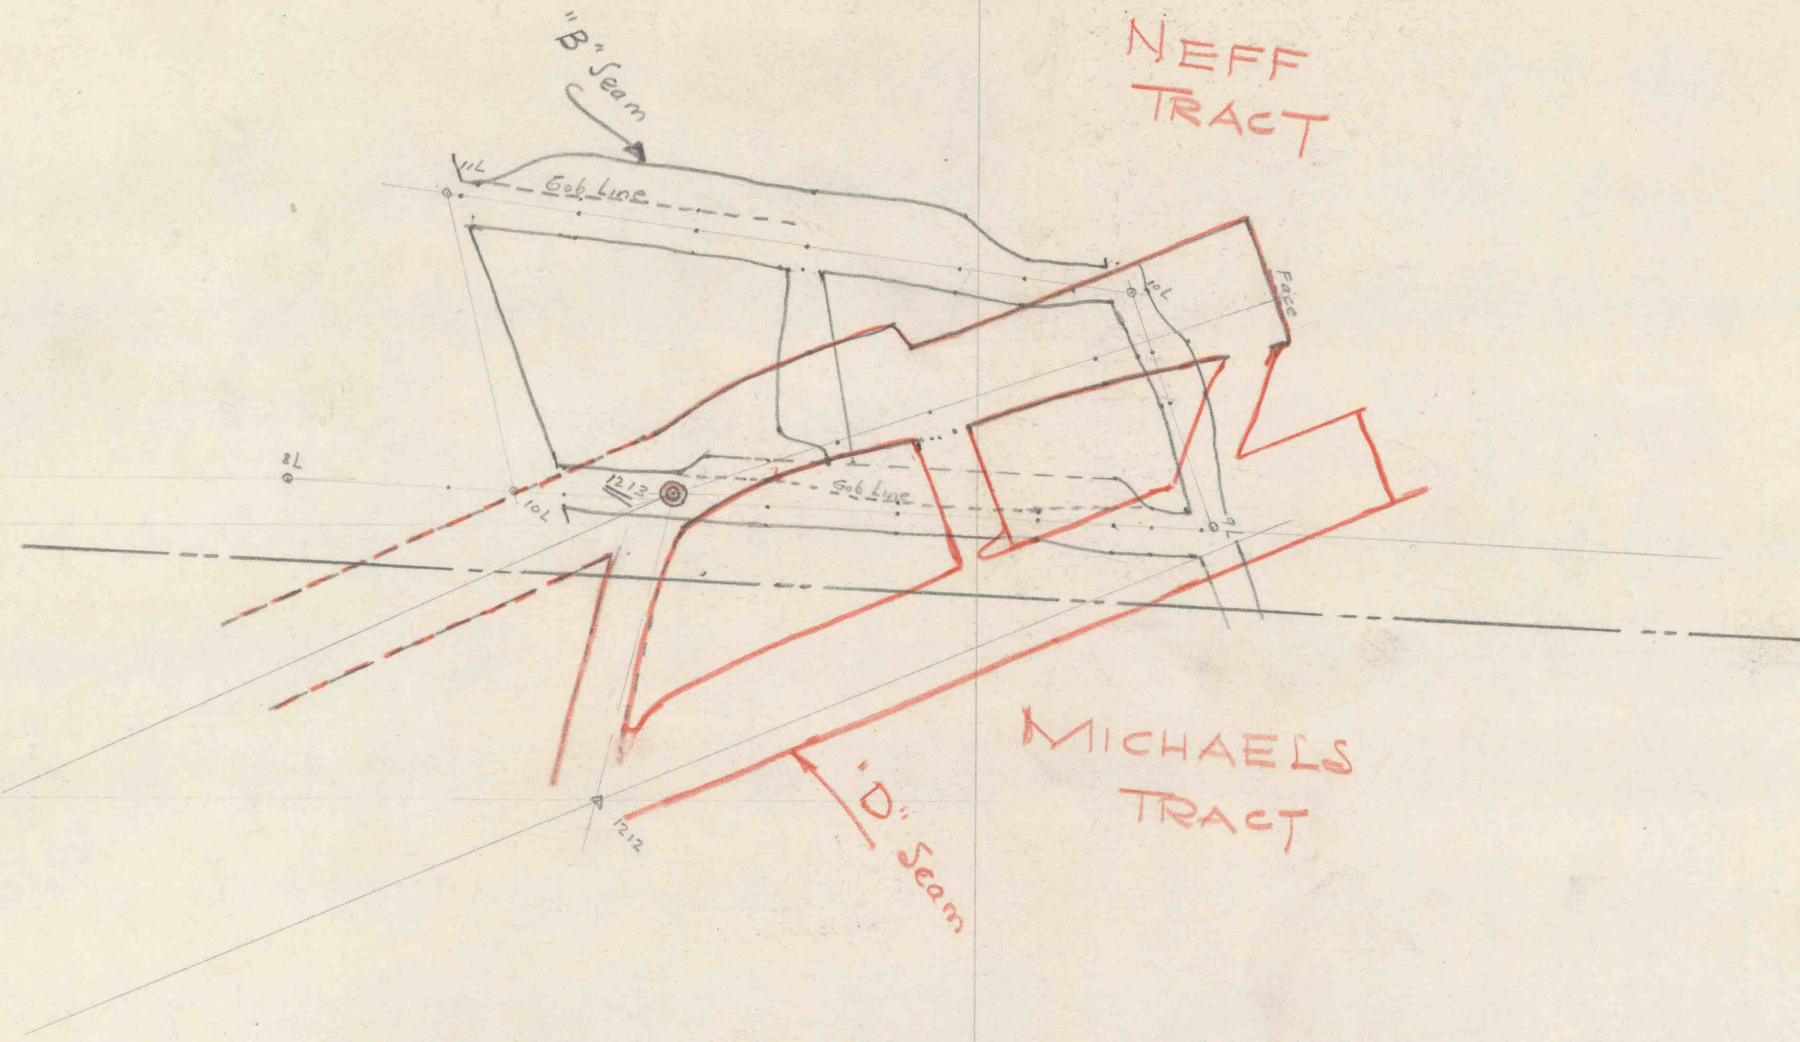

SCALE 1" = 50'