


515

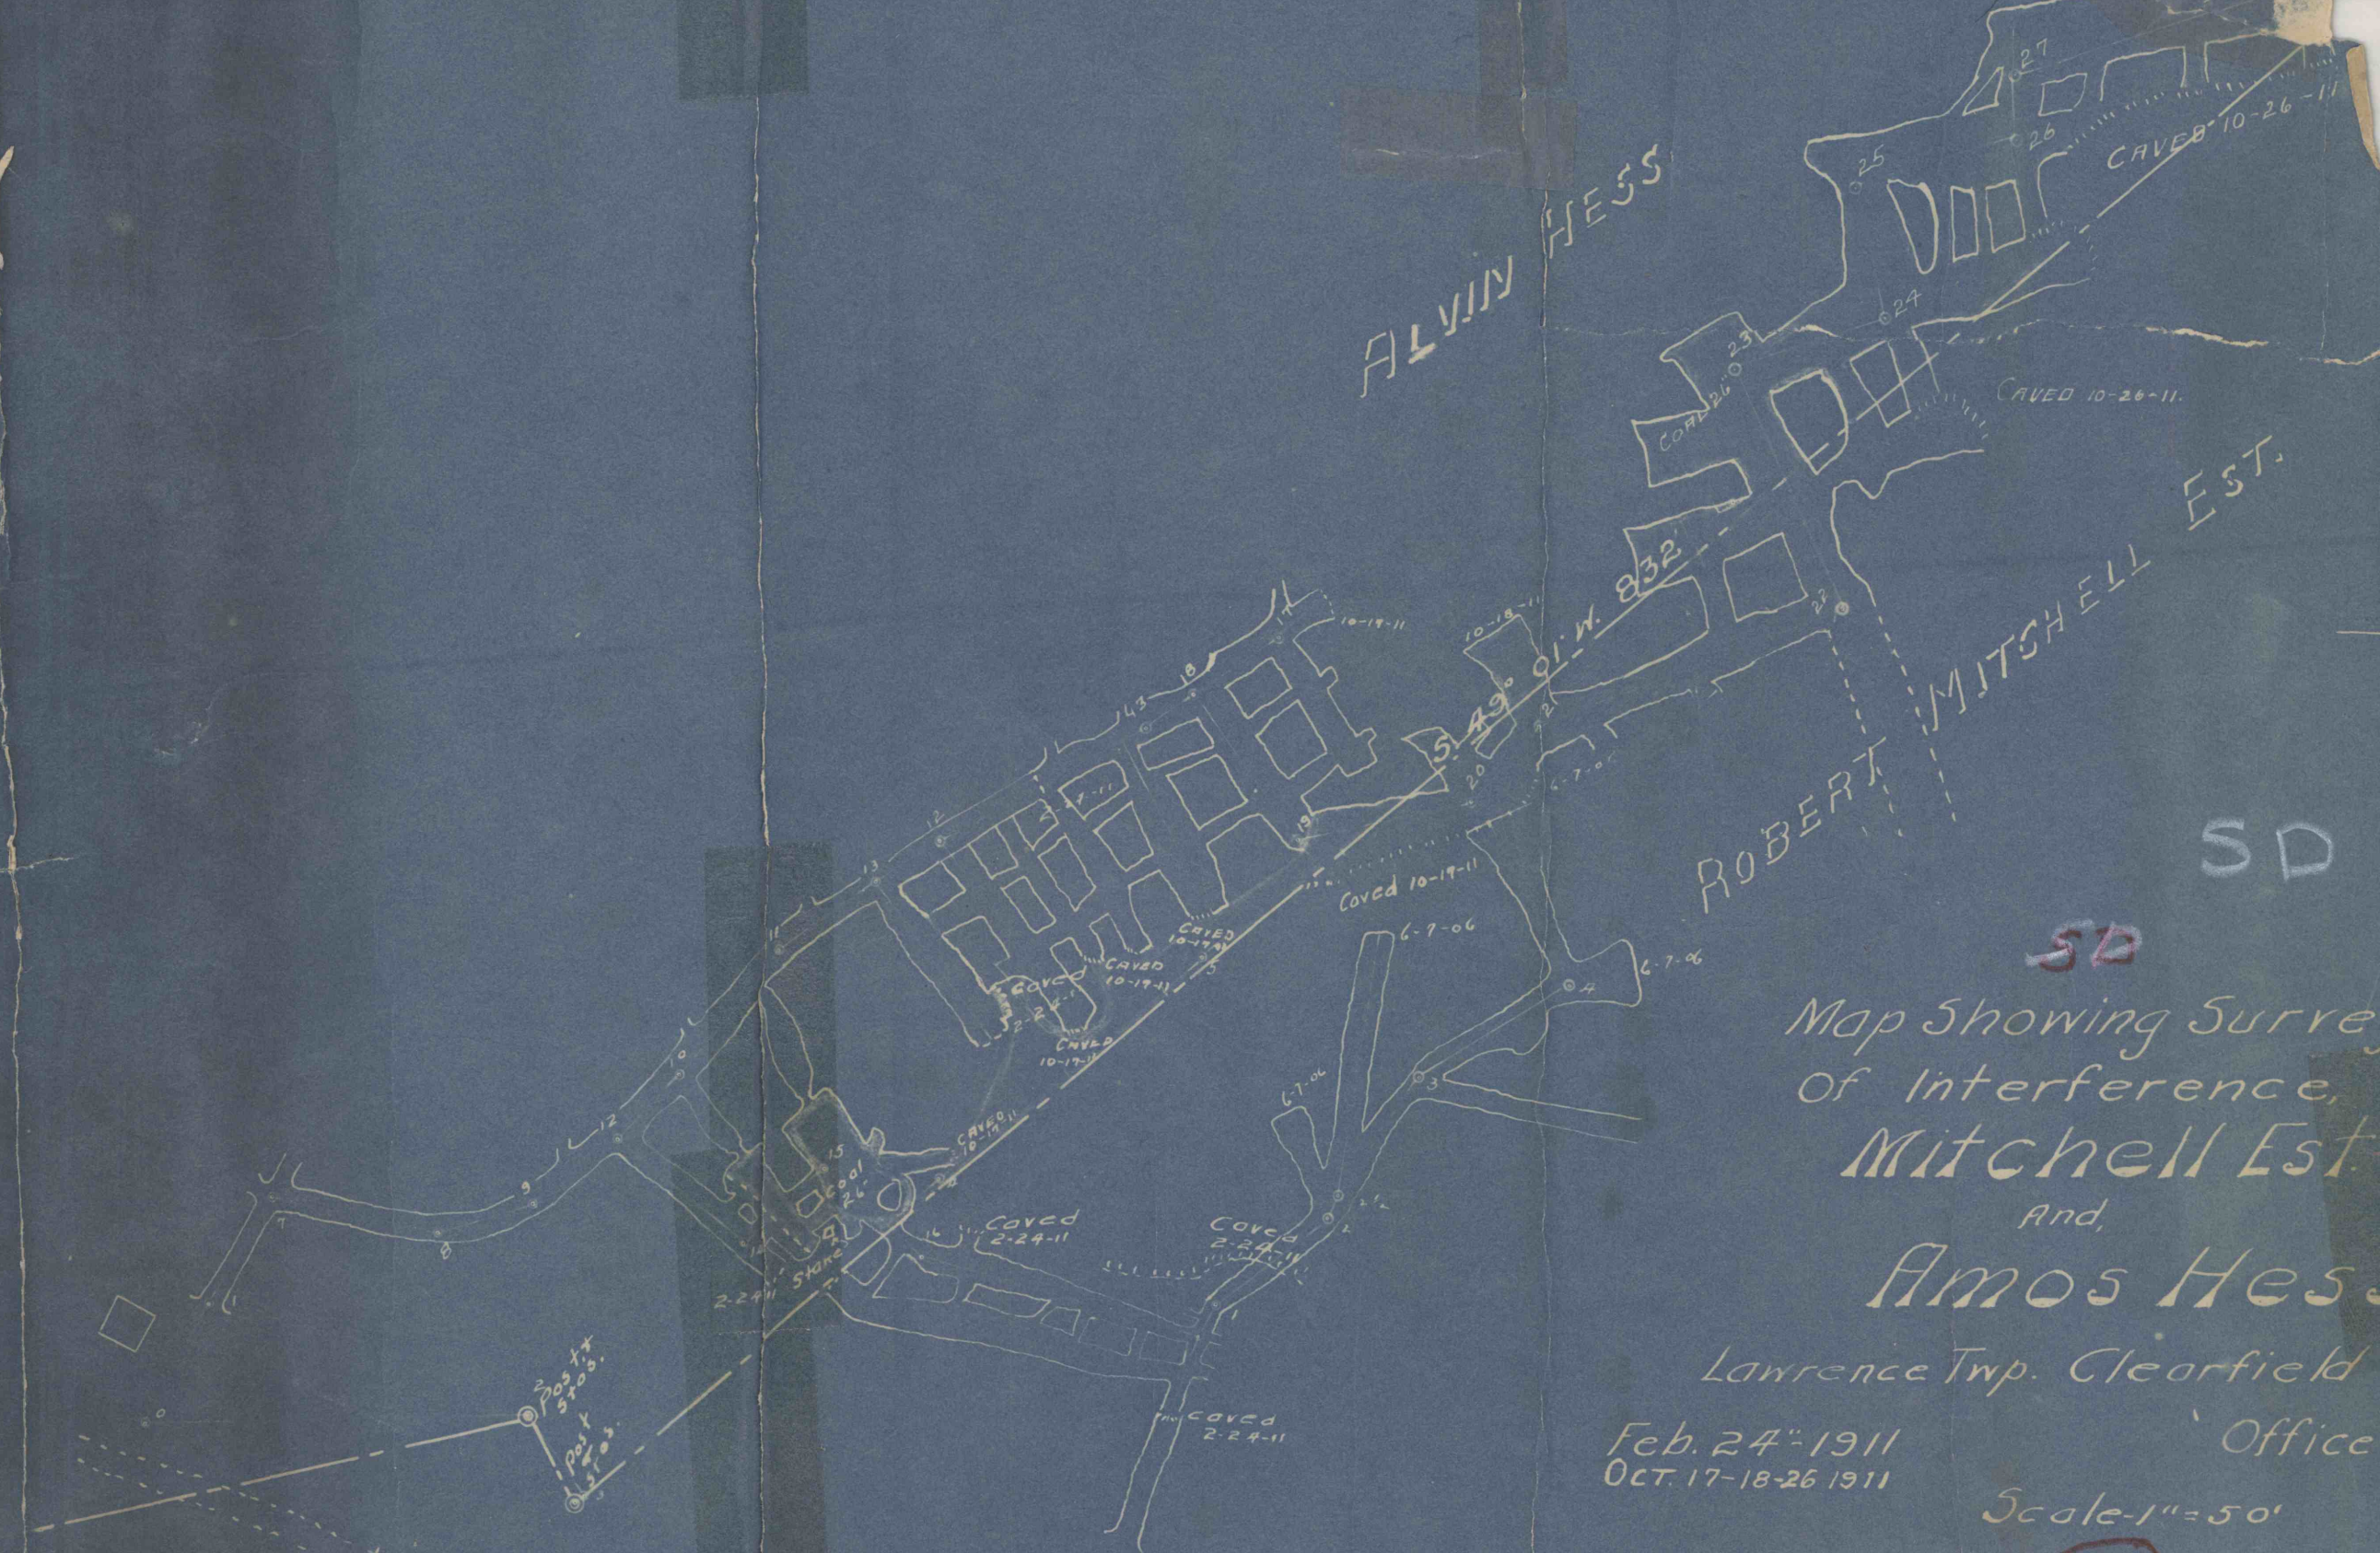

ALVIN HESS

ROBERT MITCHELL EST.

SD
SD
Map Showing Survey
Of Interference
Mitchell Est.
And
Amos Hess

Lawrence Twp. Clearfield Co. Pa.

Feb. 24-1911
OCT. 17-18-26 1911

Office of E.W. Hess,
Engr.

Scale 1"=50'

212 212

13358

"SHUTES" BANK

Book 91

515

515