
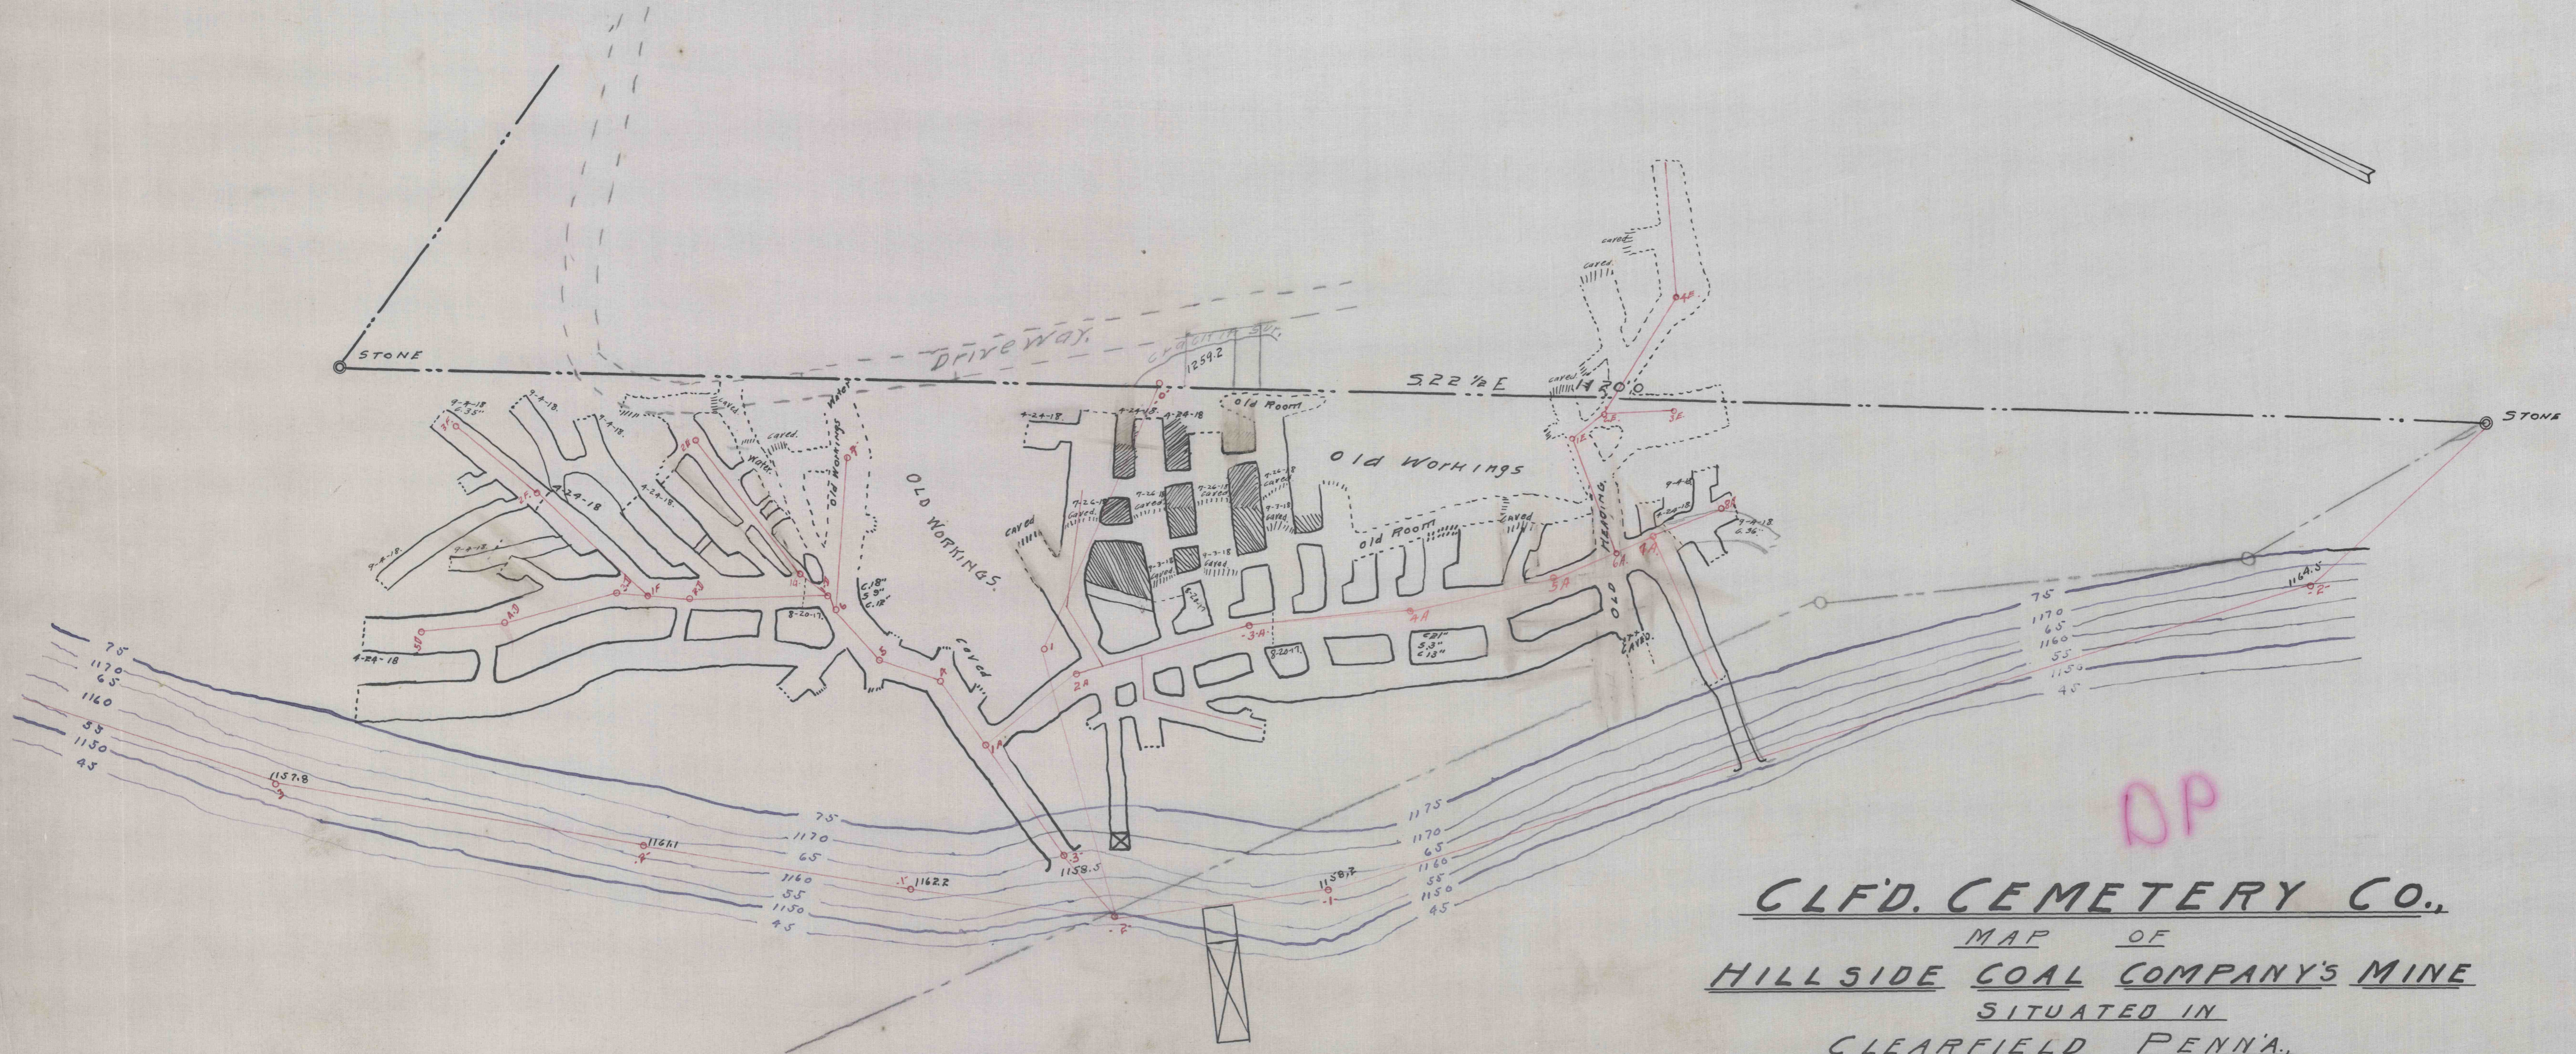


NEW CEMETERY.

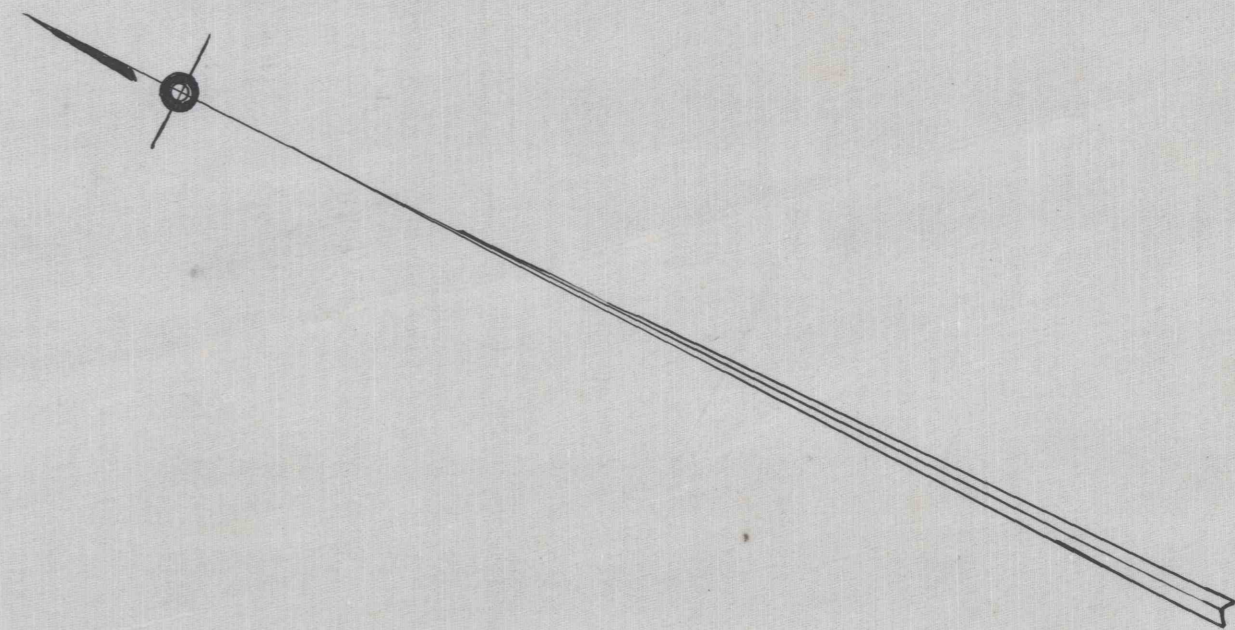

DP

CLFD. CEMETERY CO.,
 MAP OF
HILLSIDE COAL COMPANY'S MINE
 SITUATED IN
CLEARFIELD PENNA.
 SCALE: 1" = 50'

CLEARFIELD, PA.
 JULY 26, 1918.

OFFICE OF
 E. W. HESS, ENGR.

SURVEYED	AUGUST	20	1917.
RE-SURVEYED	APRIL	24	1918.
INSPECTED	JULY	26	1918.
"	AUGUST	5	1918.
"	SEPT.	3	1918.
RE-SURVEYED	SEPT.	4	1918.

981-B

1740