

JUDGE TORRENCE, Now ROCHESTER & PITTSBURG COAL & IRON Co.

MAP OF LAND OF
GEORGE SHAFFER

SHOWING COAL MINE AND

ENCROACHMENT OF

ROCHESTER & PITTSBURG COAL & IRON Co.


McCALMONT TOWNSHIP, JEFFERSON Co. PA.

SCALE 1"=50'

CLEARFIELD, PA.
NOV. 17-1913

OFFICE OF
E. W. HESS, ENGINEER

SHAFFER'S WORKINGS Yellow
R. & P. C. & I. Co. Red

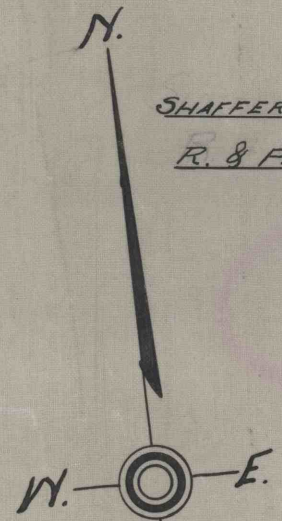

GEORGE SHAFFER

20.5³/₁₀ ACRES.


SINNS & WINSLOW. Now ROCHESTER & PITTSBURG COAL & IRON Co.

JACOB BEST Now ROCHESTER & PITTSBURG COAL & IRON Co.

SHAFFER'S HOUSE

TIPPLE

609
45
25
17
760
1244
2700 Cu. Yds.
270 TONS.

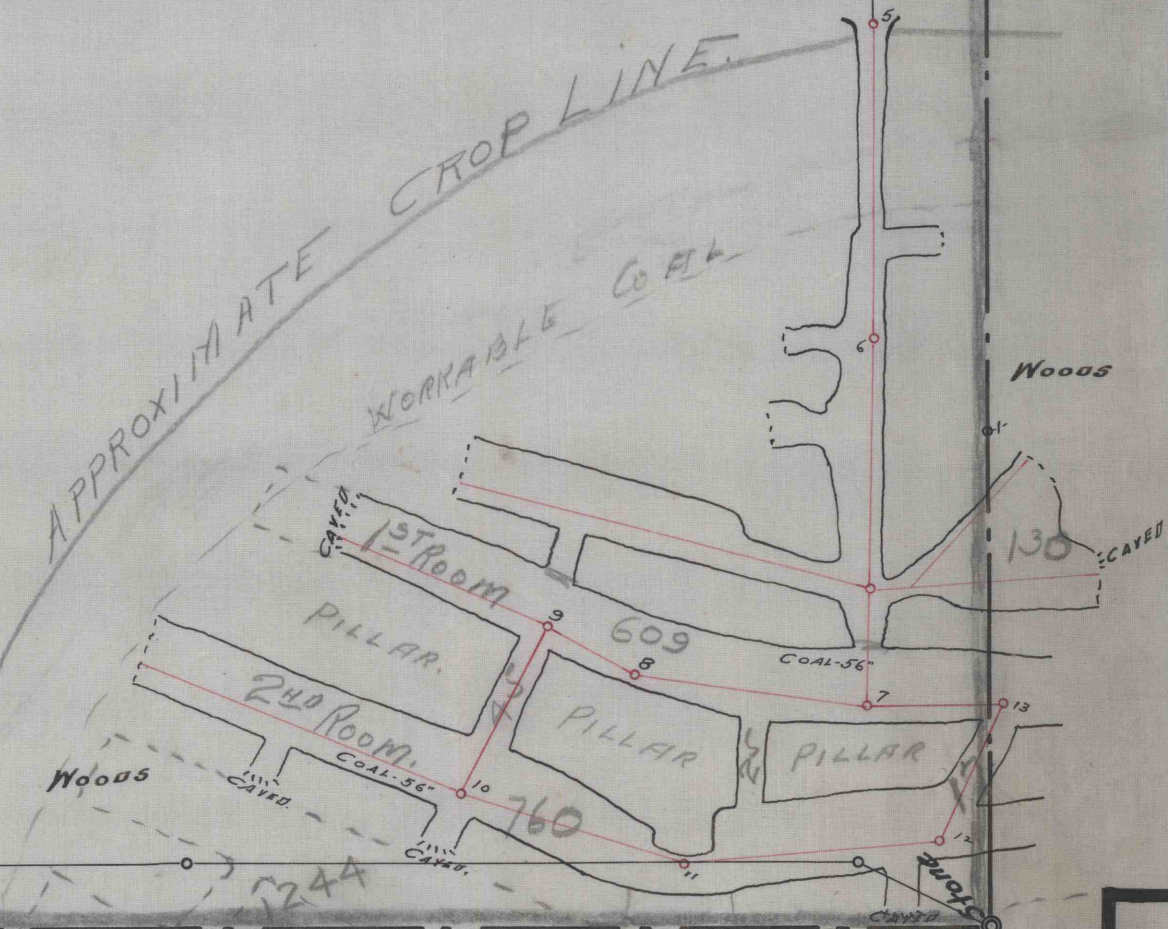

FIELD

5.83° 30' E 898.0' (E. 342.7)

JACOB BEST Now ROCHESTER & PITTSBURG COAL & IRON Co.

TO R. & P. C. & I. Co.
MAIN SLOPE