


20-2-6

20-2-6

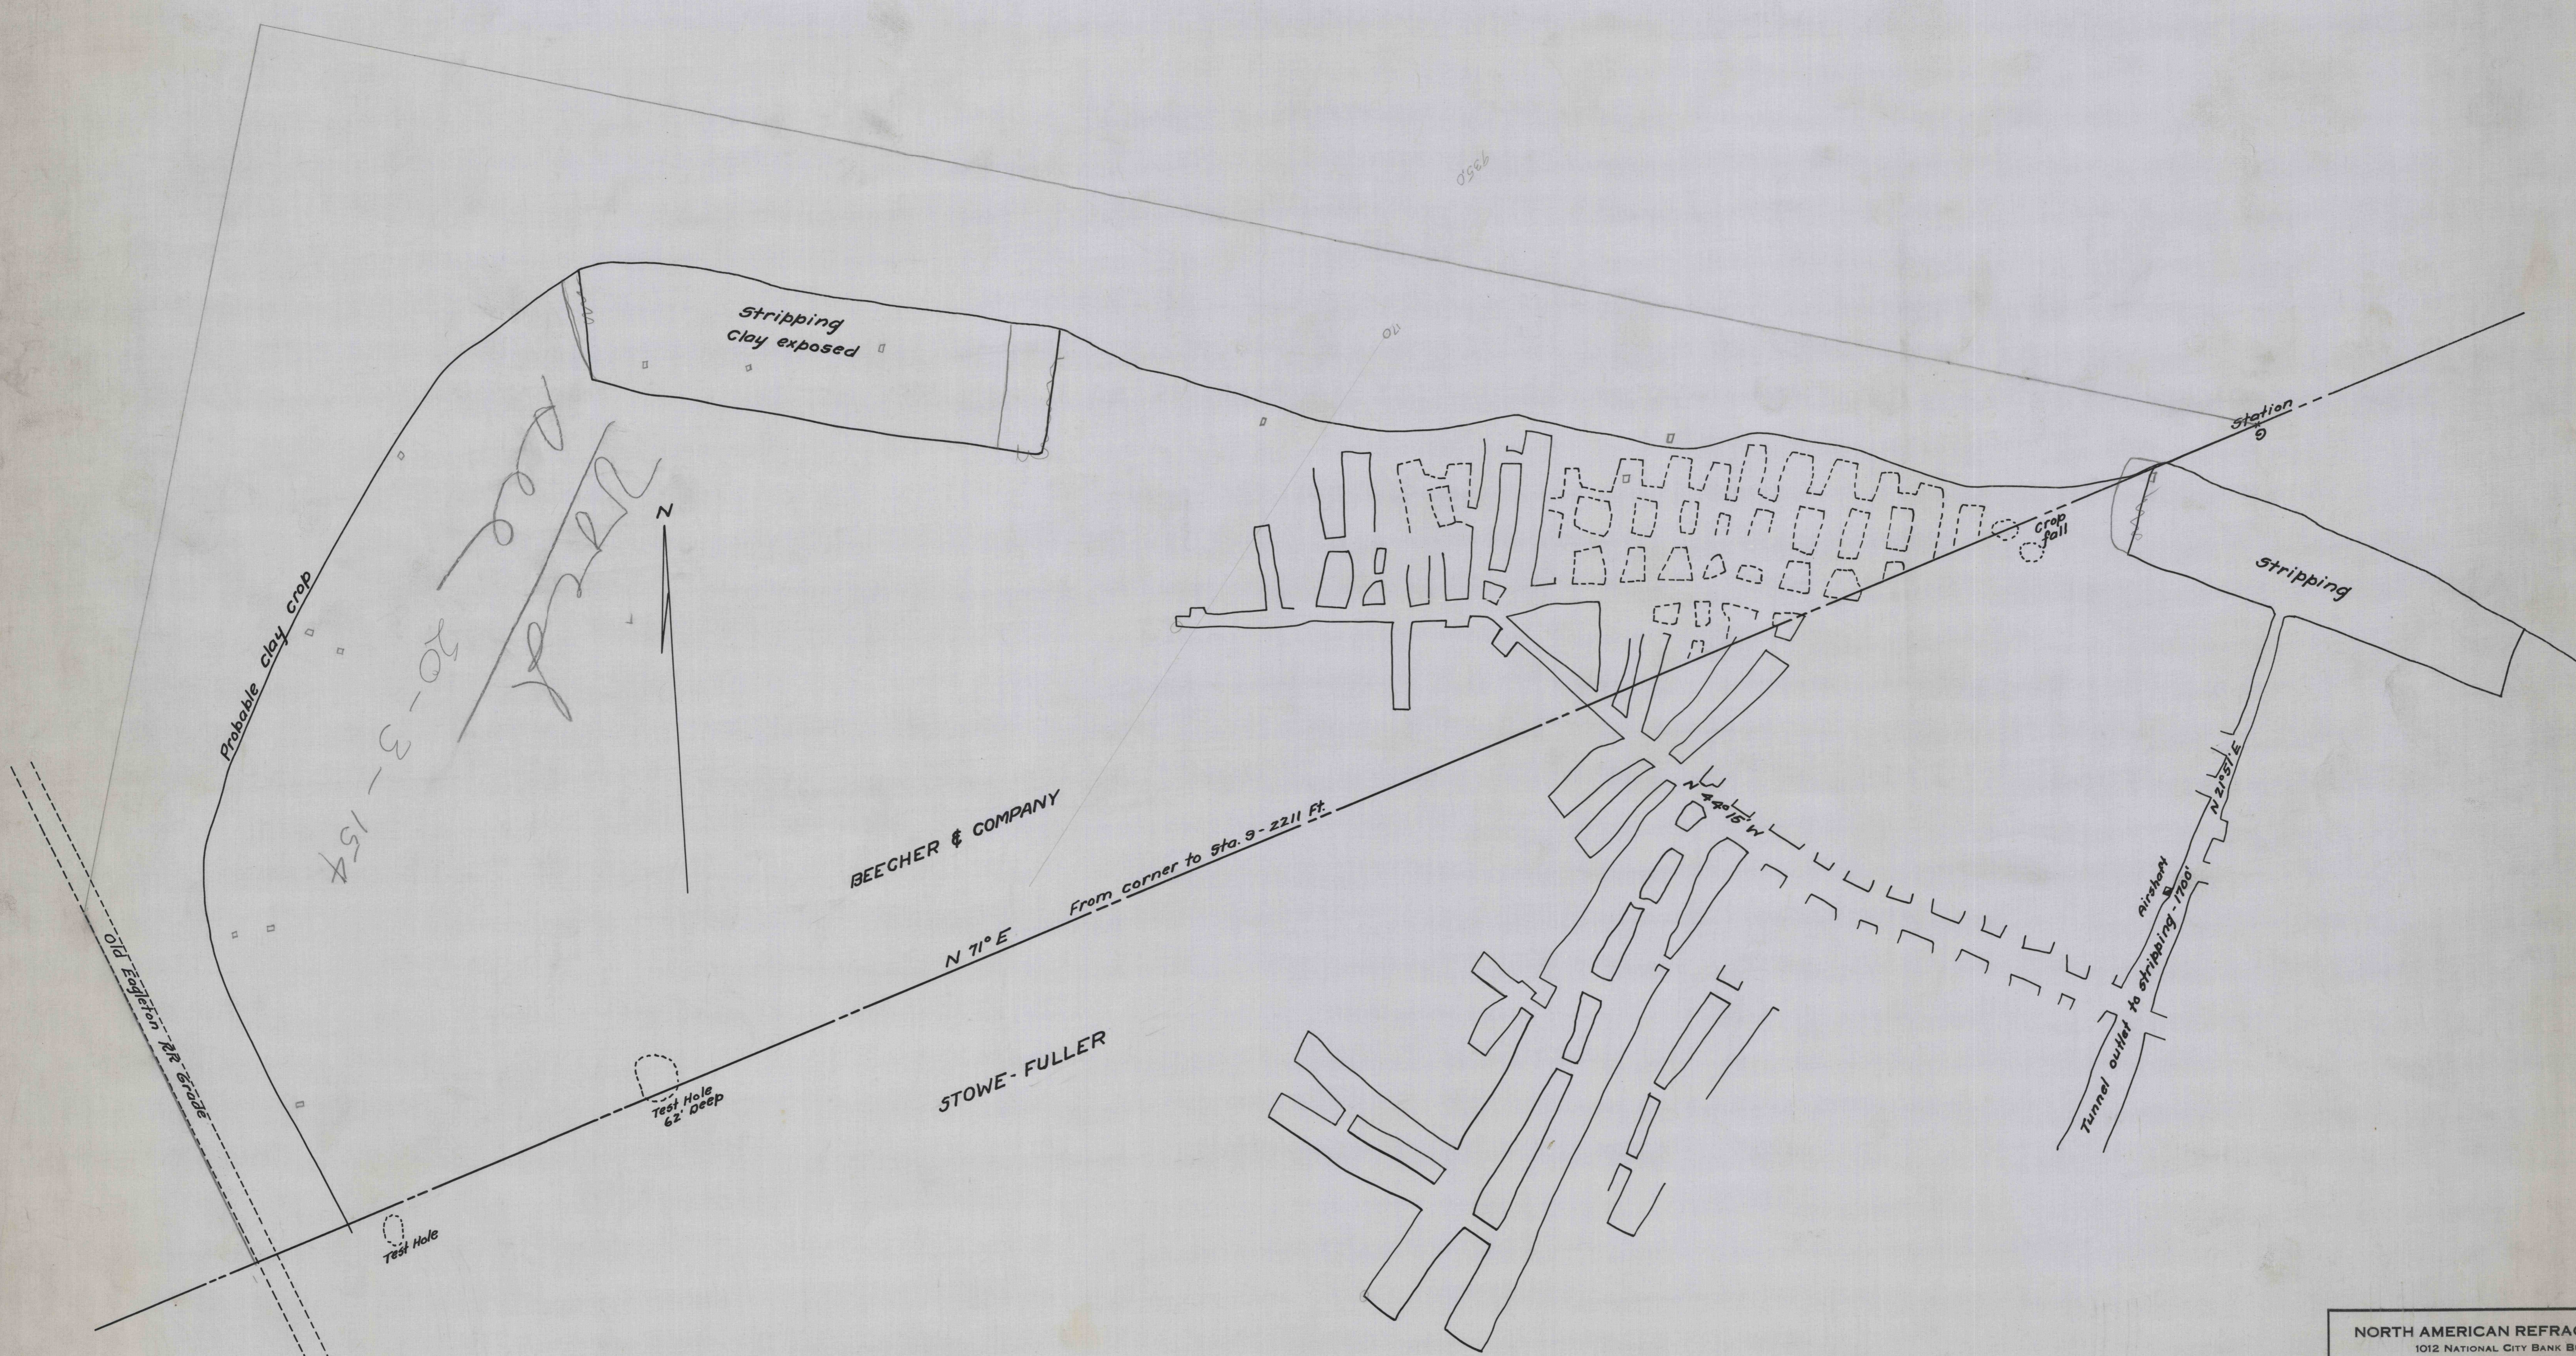

Note: Traced from Beecher map.

NORTH AMERICAN REFRACTORIES CO. 1012 NATIONAL CITY BANK BUILDING CLEVELAND, OHIO		
BEECHER-BARR CLAY LAND BALD EAGLE TWP CLINTON COUNTY, PA.		
DRAWN CHECKED <i>R.J.L.</i> REFERENCE	SCALE 1" = 50 FT. DATE 10/23/42 TRACED BY <i>B.H.A.</i>	20-2-6

20-2-6

20-2-6