2013

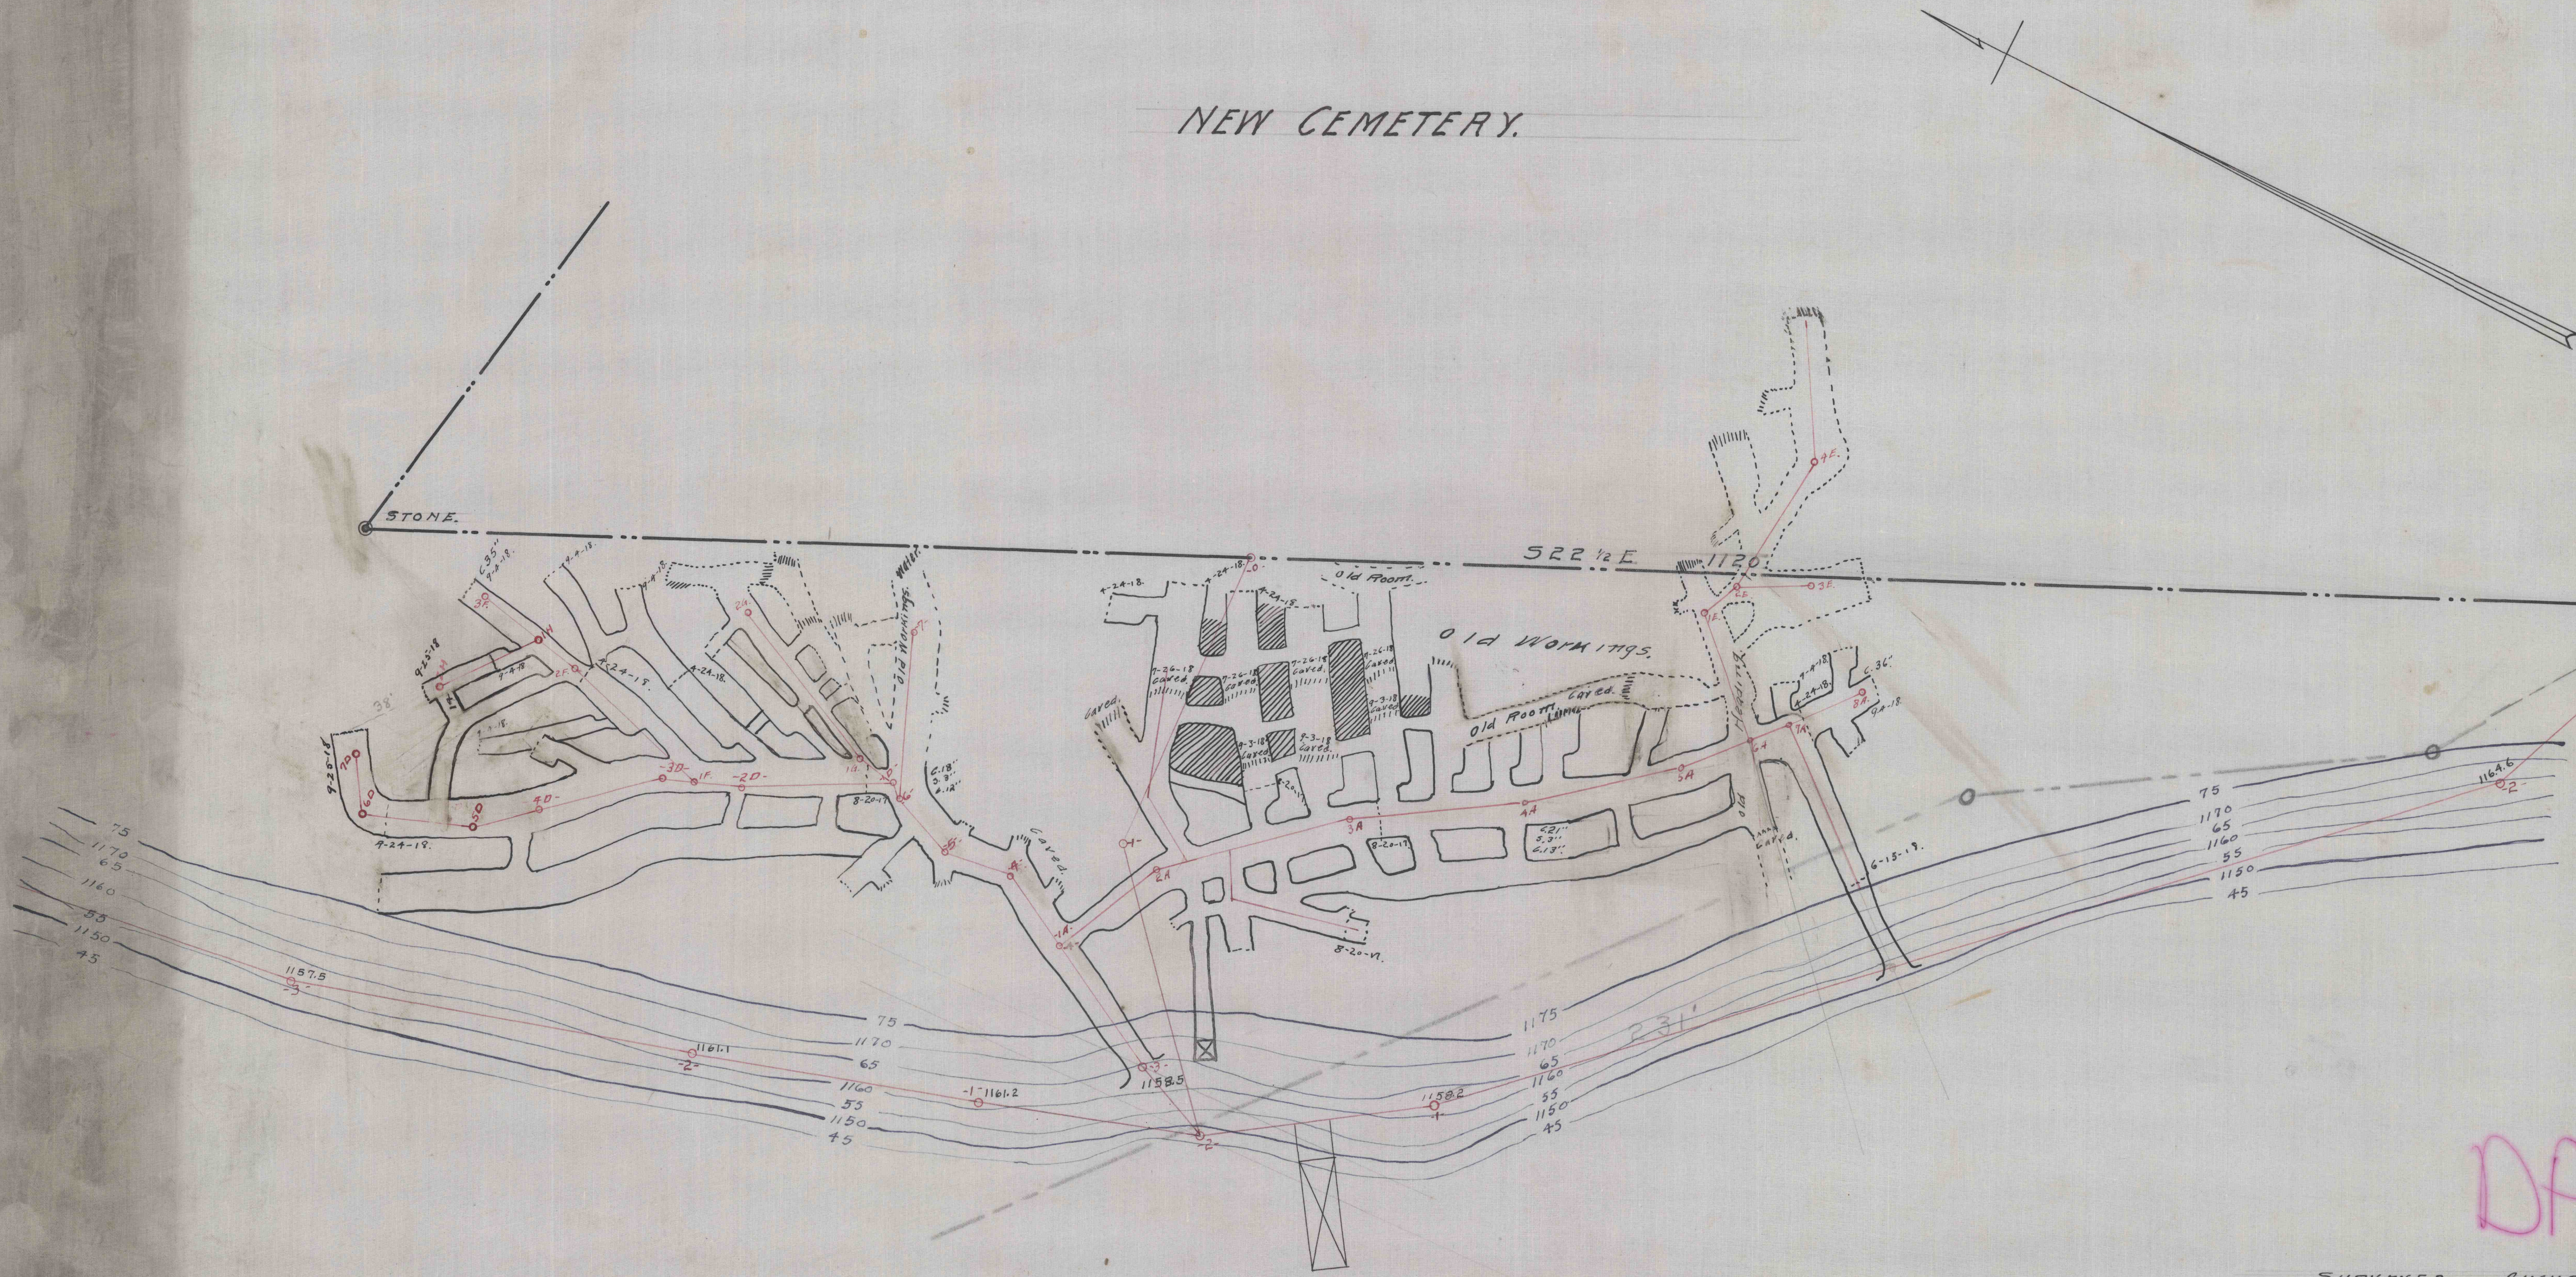

SURVEYED. AUGUST. 20 - 1917.
RE-SURVEYED. APRIL. 24 - 1918
" " SEPT. 4 - 1918.
" " SEPT. 25 - 1918.

DP

981-B

SCALE: 1" = 50'.