


M. J. DWYERS

S. 87° 47' E 1741.0'

JOHN SWARTZ EST.
S. 67° 43' W

1005
1104

1005

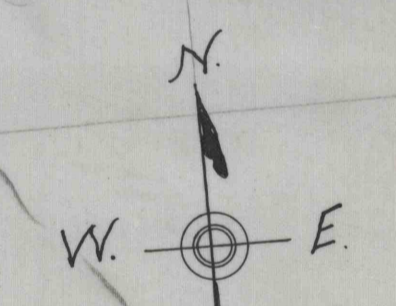

SECOND LEFT

SECOND RIGHT

FIRST LEFT

FIRST RIGHT

LINE OF WORKABLE

OUTCROP OF COAL

APPROXIMATE

TRAIL

COAL

1-15-15
RAIL
COAL
1202.6

No. 3
RAIL
1206.41

No. 2
RAIL
1203.75

16 16 16 16 16 16

16 16 16 16 16 16

N. 90° 08' W
829.9

N. 79° 59' E
824.8

30'

30'

16'

16'

16'

16'

16'

16'

16'

16'

16'

16'

16'

16'

16'

16'

16'

16'

16'

16'

16'

16'

16'

16'

205 FT

205 FT

205 FT

205 FT

205 FT

205 FT

205 FT

205 FT

205 FT

205 FT

205 FT

205 FT

205 FT

PATERSON CLAY PRODUCTS CO

MAP OF
COAL LINE No. 3

SCALE 1"=50'

CLEARFIELD PA
JANUARY 26 1915

OFFICE OF M. J. DWYERS
ENGINEER

2014

1005