


2105

M.I. OWENS

587'47" E. 174.10

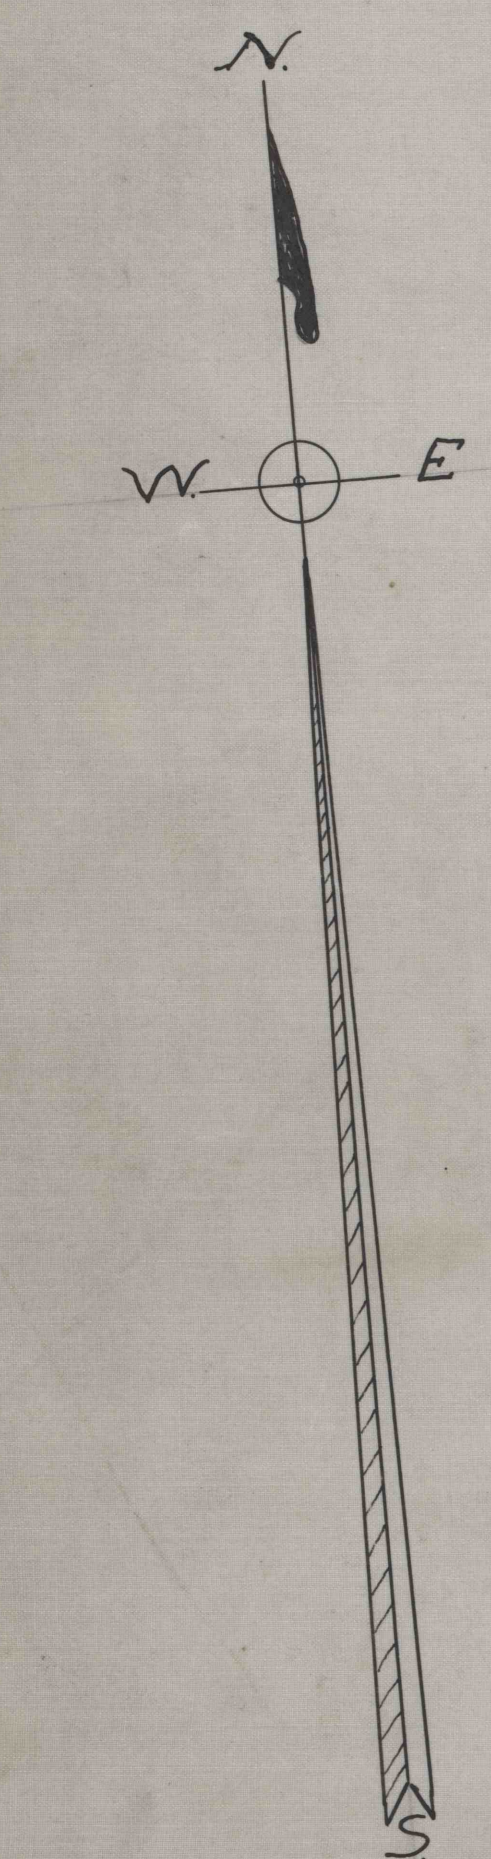

PATERSON CLAY PRODUCTS CO.  
MAP OF  
COAL MINE 110-P.  
SITUATED IN  
LAWRENCE TWP. CLEARFIELD CO. PA.  
CLEARFIELD PA. OFFICE ENGINEER  
JUNE 18 1913

JANUARY - 24 - 1914  
NOVEMBER - 20 - 1914  
MARCH - 15 - 1915

SCALE 1"=50'

1002

587'47" E. 174.10

1001 SOUTH EAST

2015