


1085

1085

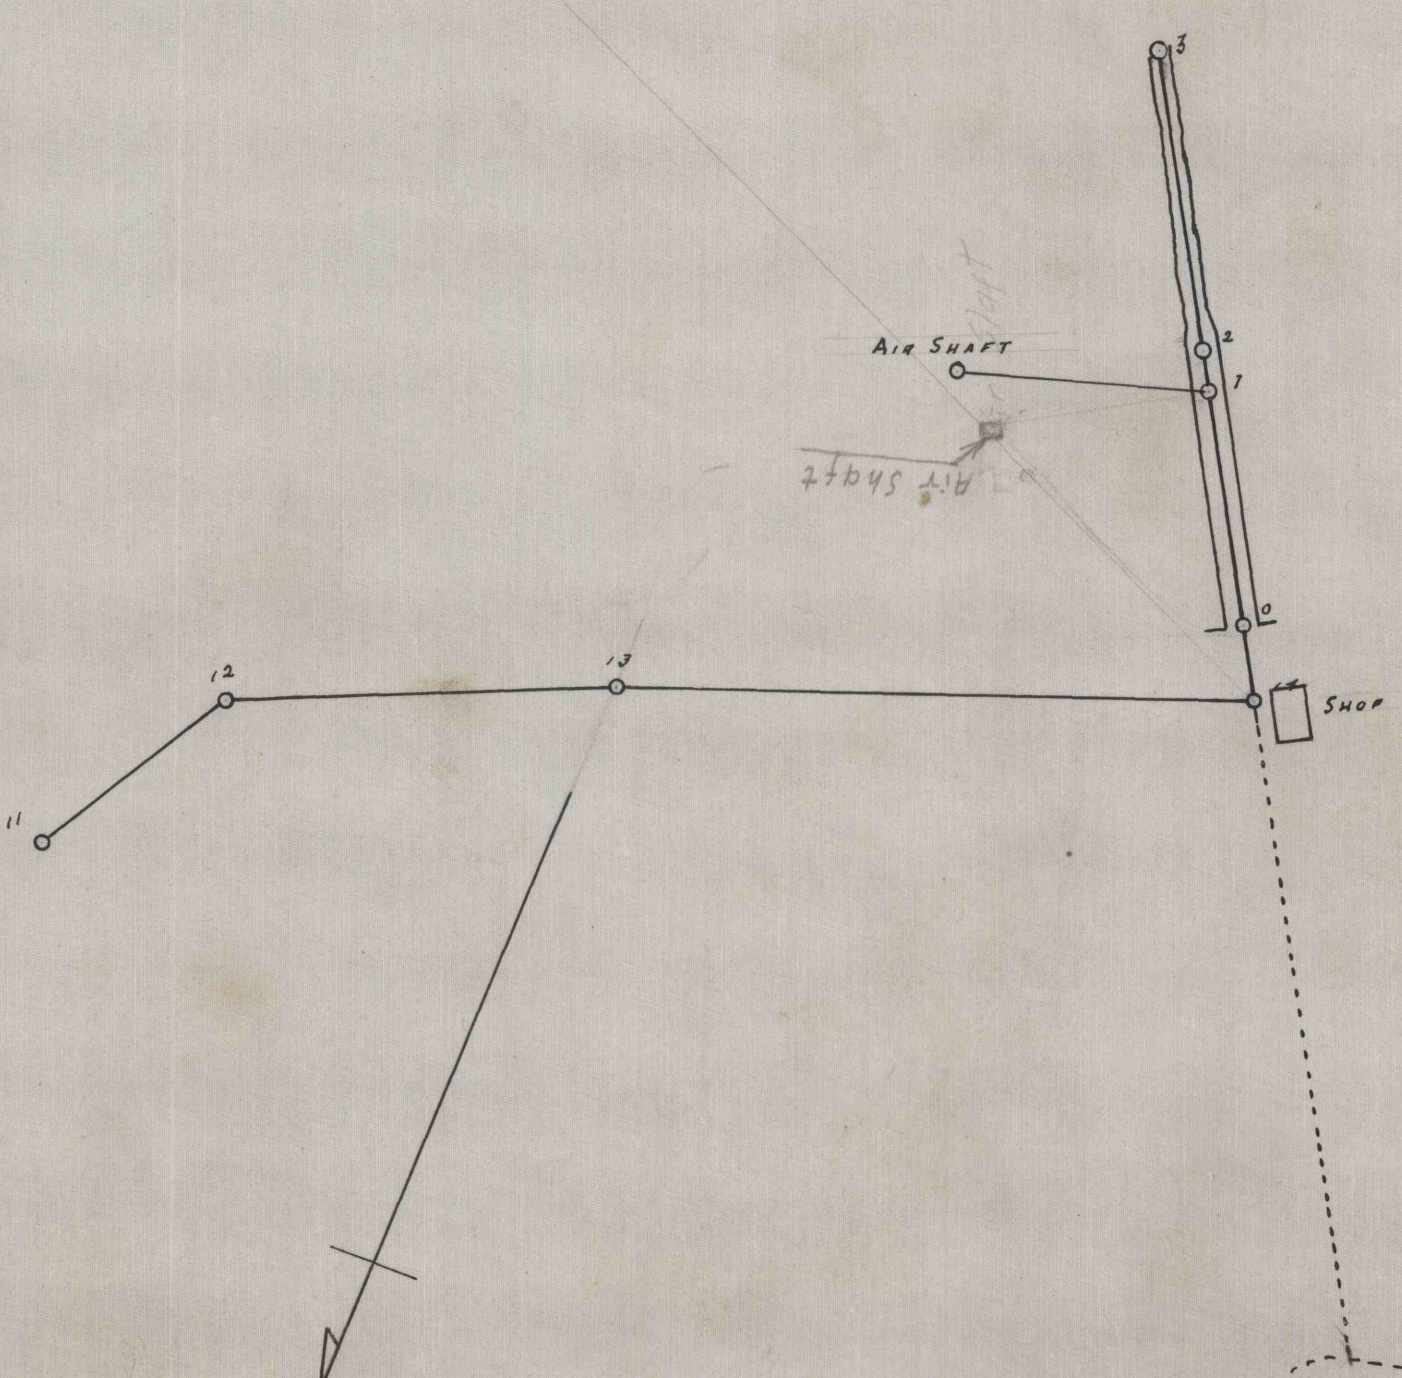

PENELEC COAL CO.  
 MINE - McENNALLY  
 FARM

SCALE 1" = 50'

CLEARFIELD PA. AUG. 13, 1917

OFFICE OF E. W. HESS, ENGR

1085-A

7555

Nº 946-A 2274