

2507

M

— MAP SHOWING "B" SEAM STRIPPING —
— OPERATED BY CAVALIER COAL CO. —
— ON THE JAMES WHITAKER TRACT —
— SNOW SHOE TOWNSHIP CENTRE CO. PA. —

— SCALE 1" = 50' — — MAY 20, 1947. —


Bernard Lucas ENGR.
Thos. F. Morgan

(C.D. 270)

MIDLAND MINING CO.

LOGAN M. KELLEY LEASE LINE 7

N 62° 51' W

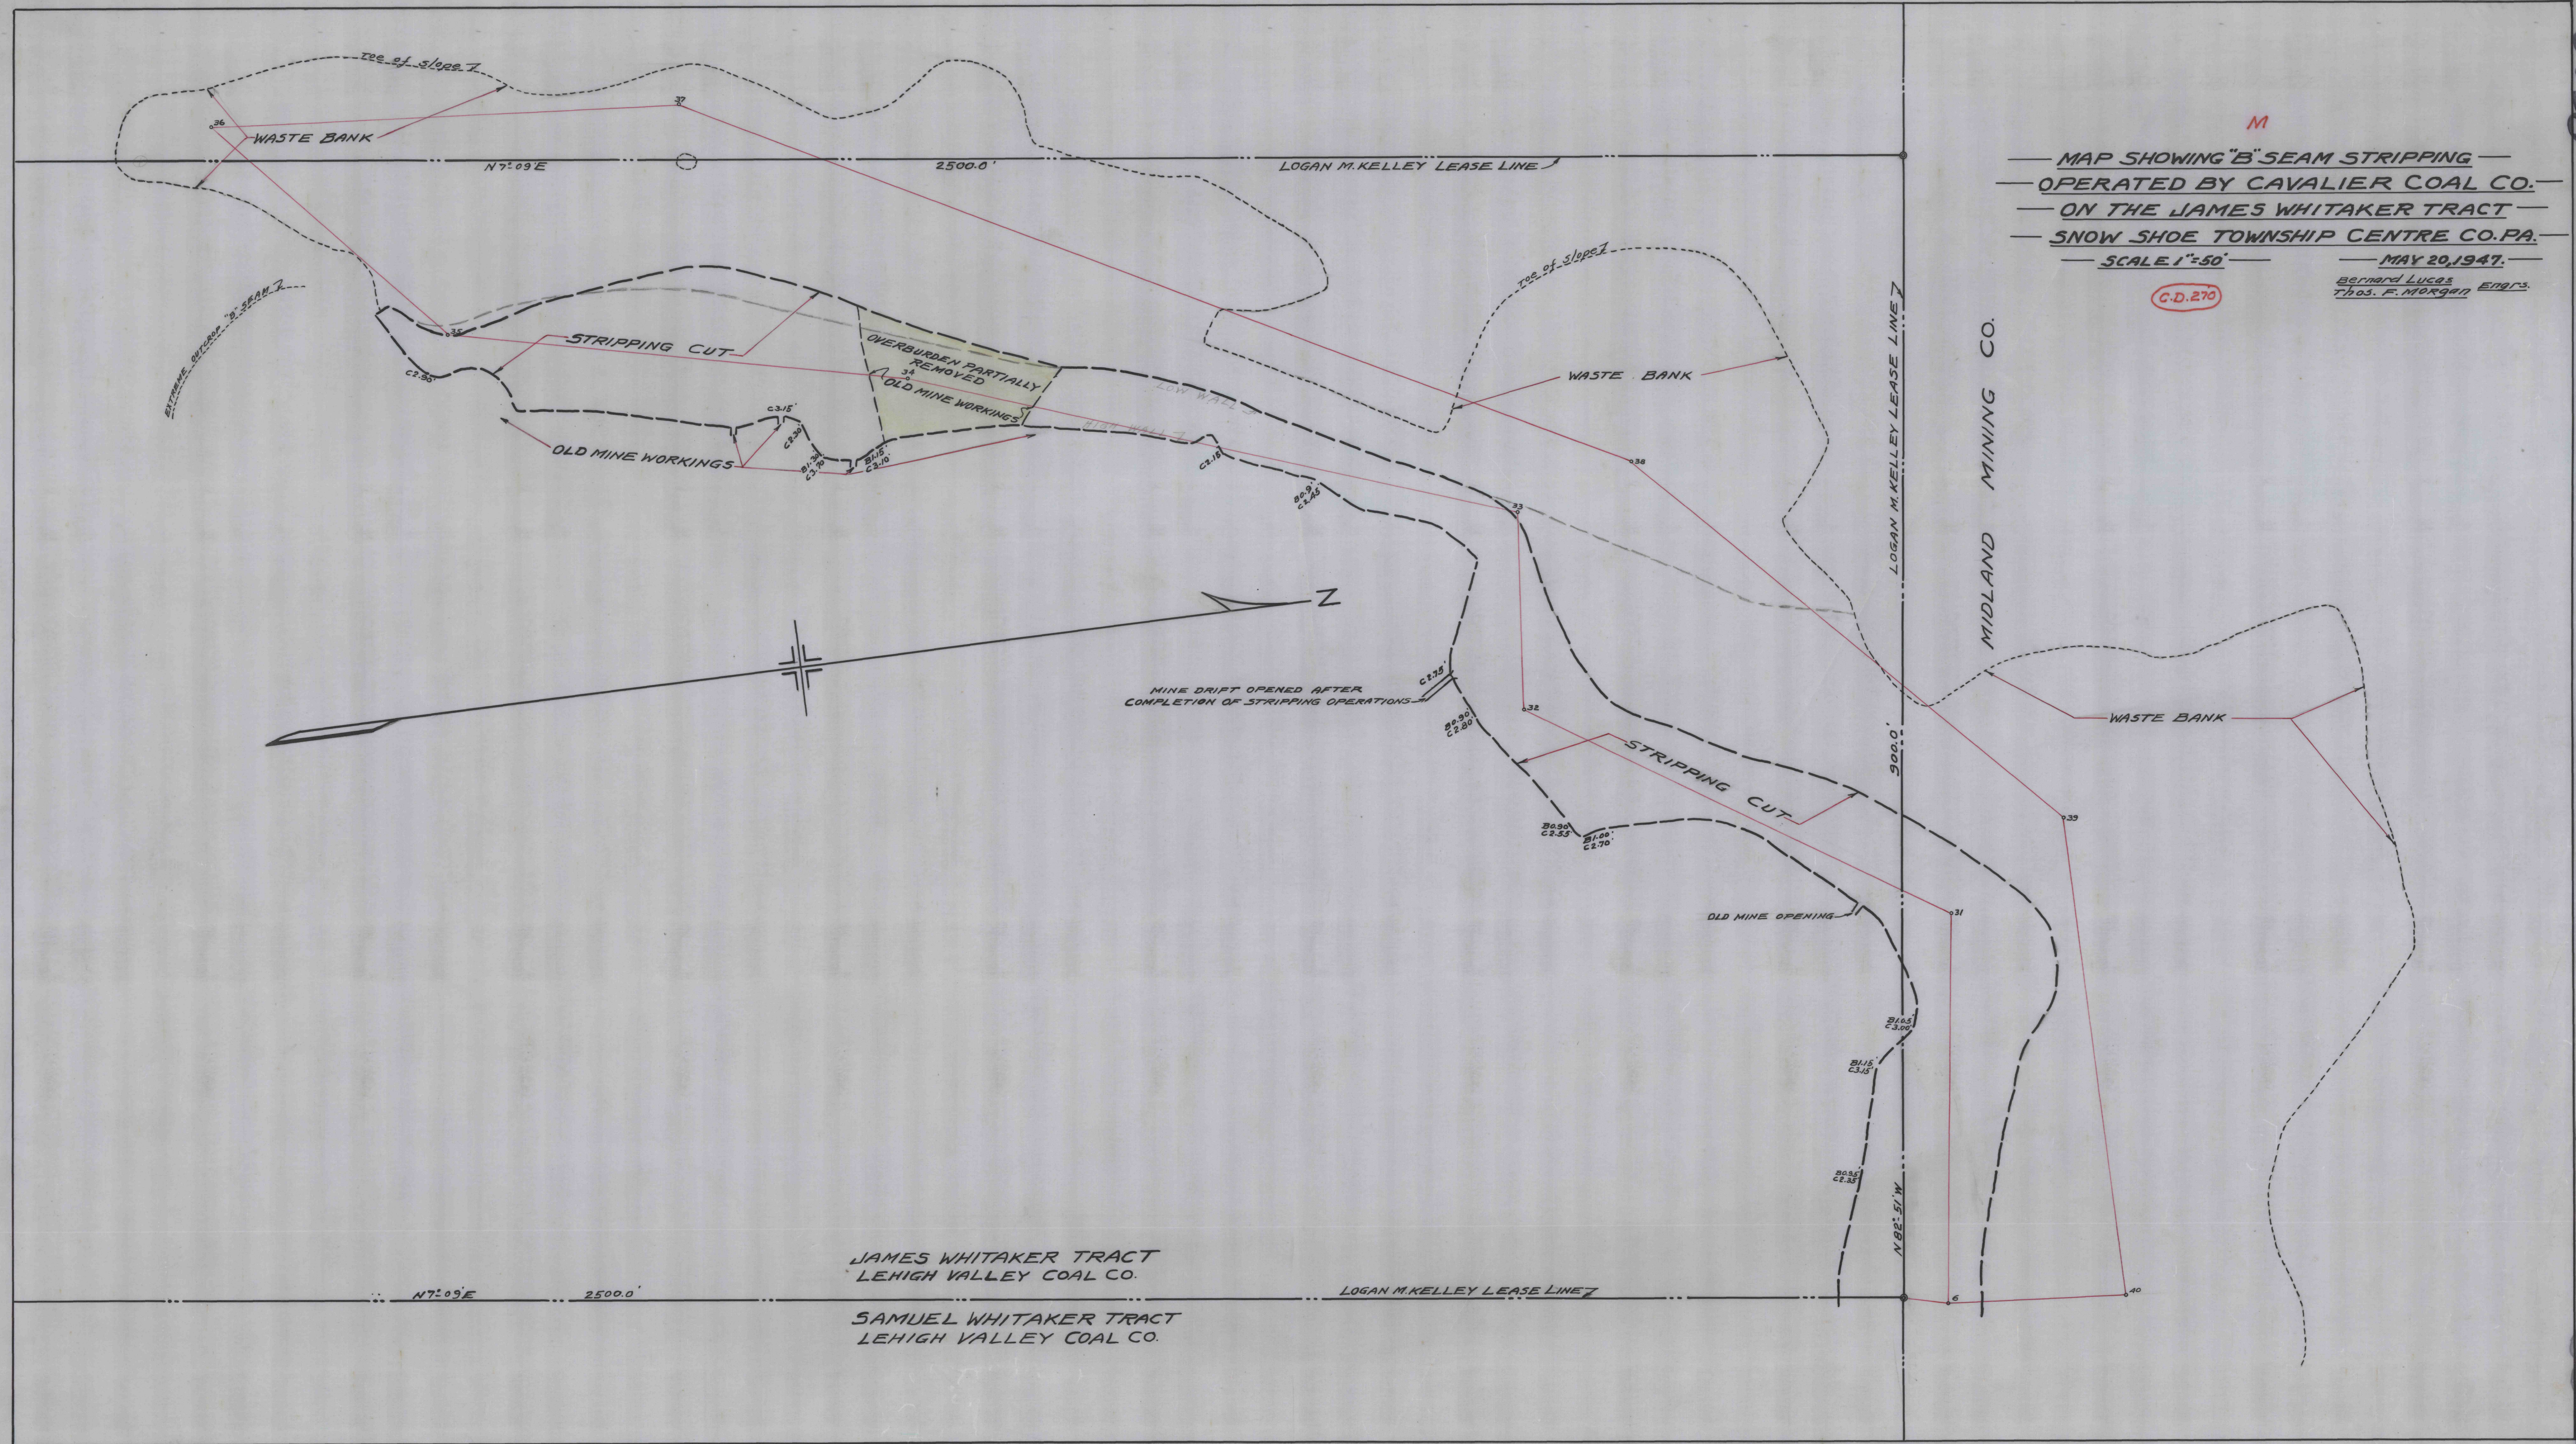

JAMES WHITAKER TRACT
LEHIGH VALLEY COAL CO.

SAMUEL WHITAKER TRACT
LEHIGH VALLEY COAL CO.

5208