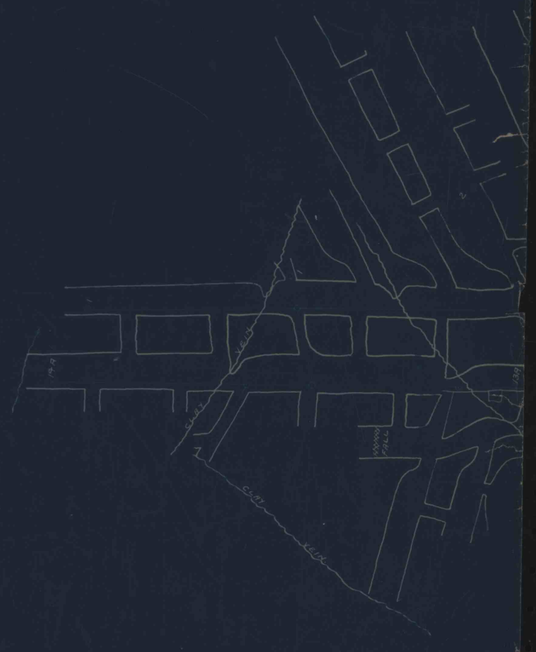

DP

MAP OF FALCON COLLI

Smoke Run, Clearfield Co., Pa.

Operated by

PENN COLLIERIES CO.

Scale 1" = 50'.