


2832

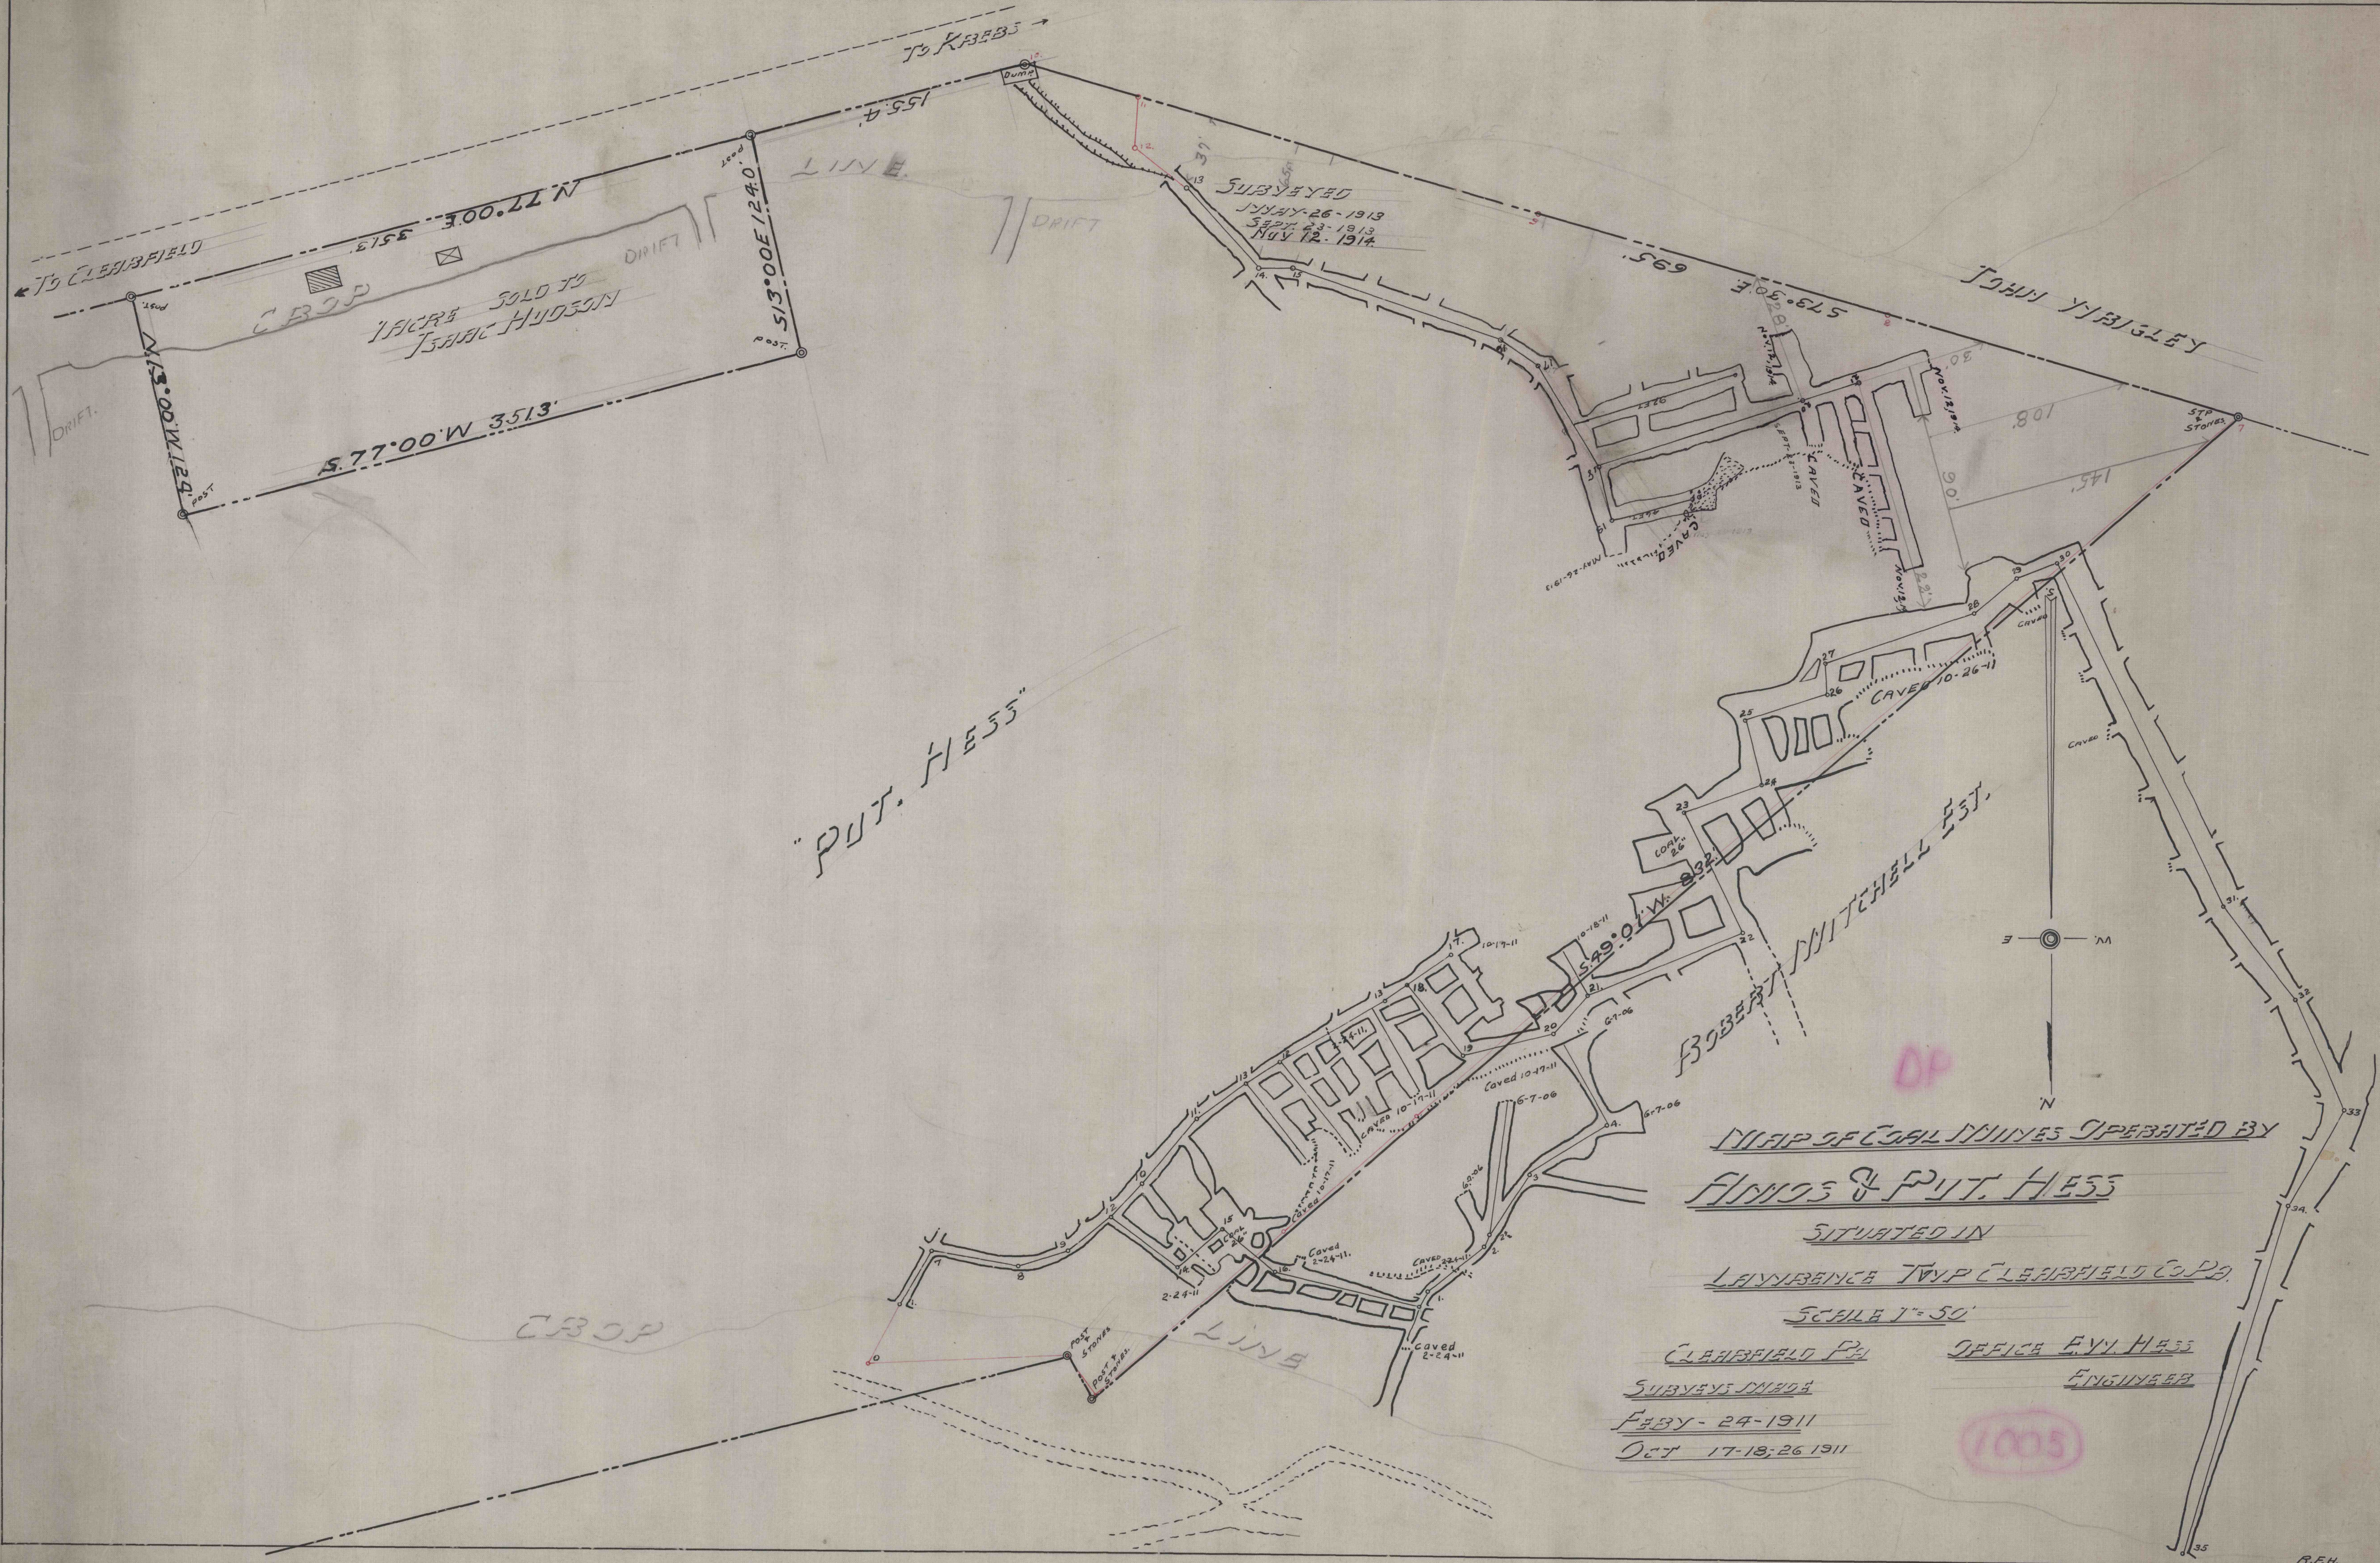

1 ACRE SOLD TO
ISAAC HUDSON

SUBVEYED
JULY 26 - 1913
SEPT. 23 - 1913
NOV. 12 - 1914

PUT. HESS

MAP OF COAL MINES OPERATED BY
FINN & PUT. HESS

SITUATED IN
LAWRENCE TWP CLEARFIELD CO. PA.

SCALE 1" = 50'

CLEARFIELD PA. OFFICE E.V. HESS
SURVEYOR ENGINEER

FEBY - 24 - 1911

OCT 17-18; 26 1911

1005

2833