


NOTE: OLD WORKINGS COPIED FROM HARDISON WALKER CO. MAP.

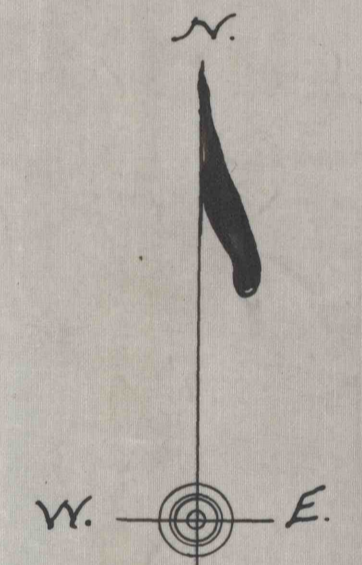

ALLEN YRIGLEY
 MAP OF COAL SHINE
 2 MILES SOUTHEAST OF CLEARFIELD
 LAWRENCE, TWP., CLEARFIELD CO., PA.
 SCALE 1"=50'

CLEARFIELD PA.
 OCT. 26 - 1914
 DATE OF SURVEYS.
 NOV. - 26 - 1913
 OCT. - 16 - 1914
 OCT. - 7 - 1915
 NOV. - 27 - 1916.

1066

OFFICE OF E. W. HESS
 ENGINEERS.