


555

D

-WALLACETON FIRE BRICK Co-
 -MAP OF CLAY MINE-
 ON
 H SHEMELL TRACT
 WALLACETON PA
 CLEARFIELD PA.
 APRIL 30-03
 SCALE 50' = 1"

E.W. Hess
 Eng'r

796

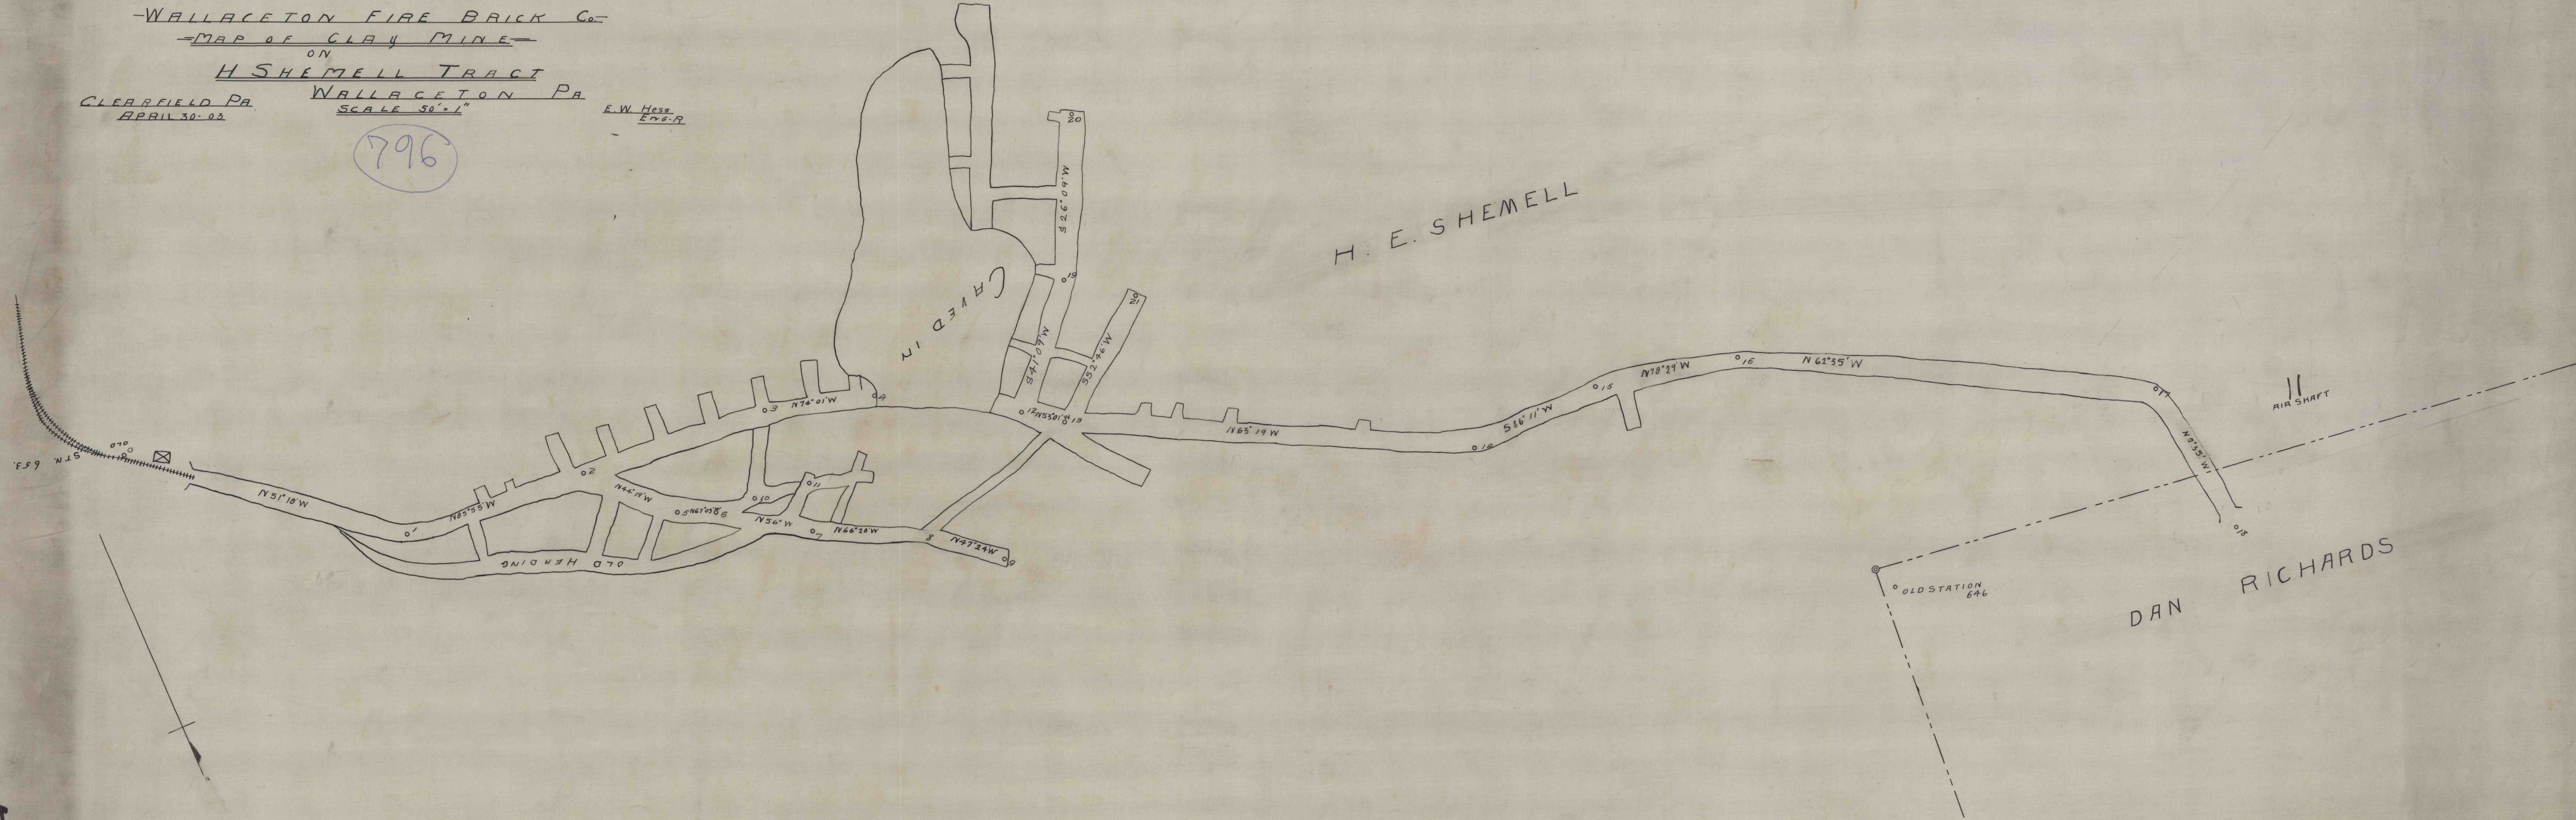

1032

B.L.W.